

KANSAS

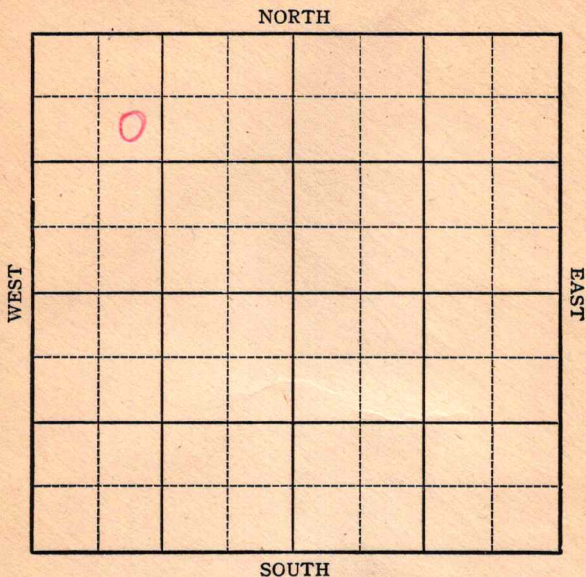
FORM 51 5M 6-46 PETROL

Butler County

Section 14 Township 26 Range 4E

Well No. 1 ~~Shriner~~

Company Buffington



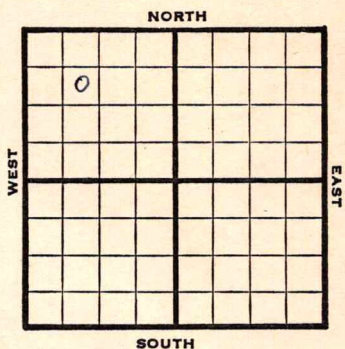
KANSAS

Sec. 14 Twp. 26 R. 4EWell No. #1 Shriber FarmBuffington Company

Miscellaneous

990 Ft. from N. Line Ft. from S. Line Ft. from E. Line990 Ft. from W. Line

SE NW NW

1946 1369 REPORT

7/31 Machine.
All wells abandoned.

8/6 Mach

8/13 Spud

8/20 "

8/27 12" @ 360
10" @ 1057
Drlg 1315'

9/5 SD 2110'

9/10 8" @ 2225'
Miss 2371
TD 2378 SD

9/18 Arb 2371
6" @ 2365'
TD2404 PBP

9/24 TD 4212
225' oil in 13 hrs

10/2 Arb 2371'
5" @ 2375'
TD 2412'
Pump 30 POT
Grav 38

COMPLETE

KANSASKansas Pool Name MiscellaneousMap No. 14 Sec. 14 Twp. 26 R. 4EWell No. 1 ShriberBuffington Company
FIRST REPORT

Contractor

SE NW NW

SECTION PLAT

990 Ft. from N. Line Ft. from S. Line Ft. from E. Line990 Ft. from W. Line

o			

Butler CountyLocation Rig up

Drilling and Remarks:

Machine
All wells
Abandoned

RECORD

Cased in., ft.Sand Gas Oil Total Depth

PRODUCTION

1st 24 hrs. Nat. 1st 24 hrs. after shot Gas Cu. Ft.Dry Hole Abandoned

Date

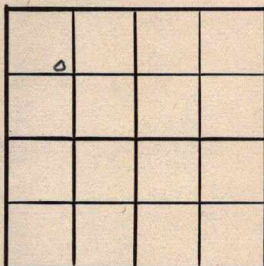
JUL 31 1946 19S. J. LEWIS Scout

KANSAS Kansas Pool Name MiscellaneousMap No. 14 Sec. 14 Twp. 26 R. 4EWell No. 1 ShriberBuffington Company

COMPLETED

Contractor

SE NW NW

E. 1369
SECTION PLAT990 Ft. from N. Line Ft. from S. Line Ft. from E. Line990 Ft. from W. LineButler CountyLocation Rig up

Drilling and Remarks:

Ar 728715" 2225Pump 30/2838 1/2

RECORD

Cased in., ft.Sand Gas Oil Total Depth 2412

PRODUCTION

1st 24 hrs. Nat. 1st 24 hrs. after shot Gas Cu. Ft.Dry Hole Abandoned

Date

OCT 2 1946 19

S. J. LEWIS Scout