

Map No. _____ Sec. 14 Twp. 26 R. 4Well No. #1 Drivew Farm __________Empire Company

NORTH

WEST

EAST

SOUTH

COMPLETED

Location _____

Rig Up _____

Drilling Remarks:

Drilling Remarks:

RECORD

Cased _____ in. _____ ft.

Sand _____

Gas _____

Oil _____

Total Depth _____

PRODUCTION

1st 24 hrs. Nat. _____

1st 24 hrs. after shot _____


Gas _____ cu. ft

Dry Hole _____

Abandoned _____

Map No. _____ Sec. 14 Twp. 26 R. 7Well No. 1 Spriver Farm _____
Emp. Company _____

NORTH

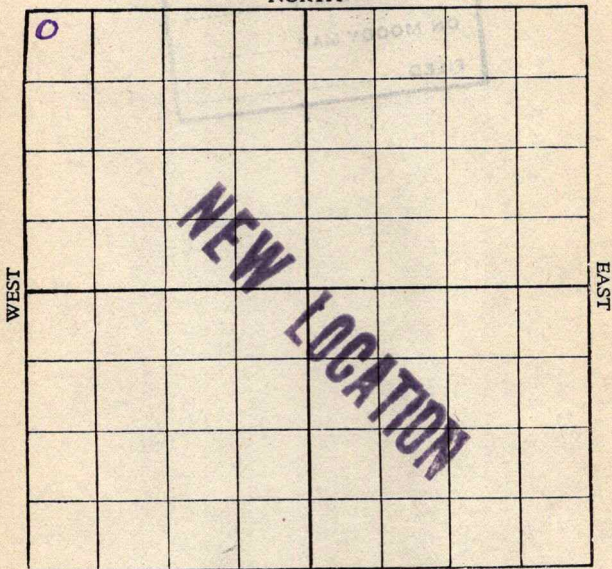

SOUTH

Location _____

Rig up _____

Drilling and remarks:

Rig.

RECORD

Cased _____ in. _____ Ft.

Sand _____

Gas _____

Oil _____

Total Depth _____

PRODUCTION

1st 24 hrs. Nat. _____

1st 24 hrs. after shot _____

Gas _____ Cu. Ft.

Dry Hole _____

Abandoned _____

Date

JUN 9 - 1917

, 191

C. J. Crocker Scout

Map No. _____ Sec. 14 Twp. 26 R. 4

Well No. 1 Shriver Farm _____
Emp Company _____

NORTH

WEST	<u>0</u>								EAST

SOUTH

Location _____

Rig up _____

Drilling and remarks:

Rig

RECORD

Cased _____ in. _____ Ft.

Sand _____

Gas _____

Oil _____

Total Depth _____

PRODUCTION

1st 24 hrs. Nat. _____

1st 24 hrs. after shot _____

Gas _____ Cu. Ft.

Dry Hole _____

Abandoned _____

Date

JUN 16 1917

, 191

E. J. Crocker

Scout

Map No. _____ Sec. 14 Twp. 26 R. 4Well No. 1 Shriver FarmEmp Company

NORTH

0							

SOUTH

Location _____

Rig up _____

Drilling and remarks:

Rig

RECORD

Cased _____ in. _____ Ft.

Sand _____

Gas _____

Oil _____

Total Depth _____

PRODUCTION

1st 24 hrs. Nat. _____

1st 24 hrs. after shot _____

Gas _____ Cu. Ft.

Dry Hole _____

Abandoned _____

Date

JUN 22 1917

G. T. Crocker Scout

Map No. _____ Sec. 14 Twp. 26 R. 4
 Well No. 1 Strived Farm _____
Empire Company _____

NORTH

WEST	0							
EAST								

SOUTH

Location _____

Rig up _____

Drilling and remarks:

D-230'

RECORD

Cased _____ in. _____ Ft.

Sand _____

Gas _____

Oil _____

Total Depth _____

PRODUCTION

1st 24 hrs. Nat. _____

1st 24 hrs. after shot _____

Gas _____ Cu. Ft.

Dry Hole _____

Abandoned _____

Date JUN 30 1917

_____, 191____, E. J. Crocker Scout

Map No. _____ Sec. 14 Twp. 26 R. 4
 Well No. 1 Shriver Farm _____
 _____ Emp Company

NORTH

WEST	0							

EAST

SOUTH

Location _____

Rig up _____

Drilling and remarks:

D-910'

RECORD

Cased _____ in. _____ Ft.

Sand _____

Gas _____

Oil _____

Total Depth _____

PRODUCTION

1st 24 hrs. Nat. _____

1st 24 hrs. after shot _____

Gas _____ Cu. Ft.

Dry Hole _____

Abandoned _____


Date

JUL 7 1917

E. J. Crocker
Scout

Map No. _____ Sec. 14 Twp. 26 R. 4Well No. 1 Shriver FarmEmpire Company

NORTH

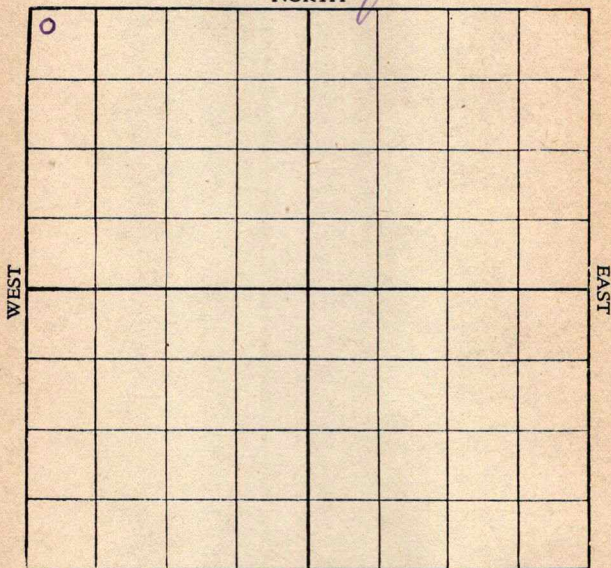

SOUTH

Location _____

Rig up _____

Drilling and remarks:

D. 1310Hole full of water

RECORD

Cased _____ in. _____ Ft.

Sand _____

Gas _____

Oil _____

Total Depth _____

PRODUCTION

1st 24 hrs. Nat. _____

1st 24 hrs. after shot _____

Gas _____ Cu. Ft.

Dry Hole _____

Abandoned _____

Date

JUL 14 1917

191


C. J. Crocker Scout

Map No. _____ Sec. 14 Twp. 26 R. 4
 Well No. 1 Shriver Farm _____
Empire Company _____

NORTH

WEST

EAST

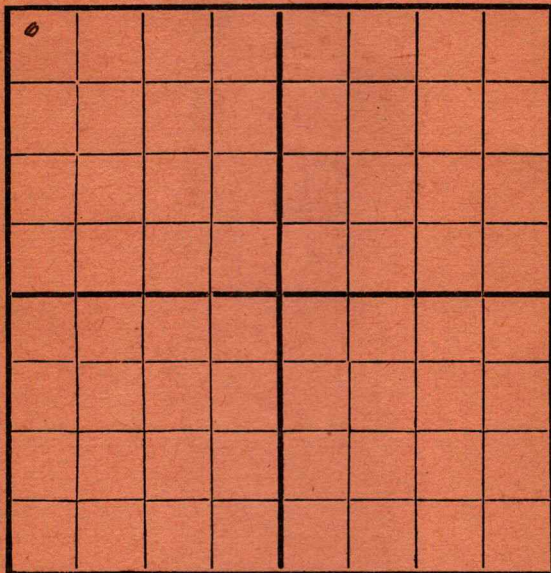

SOUTH

Location _____
 Rig Up _____
 Drilling and remarks _____

RECORD

Cased _____ in. _____ Ft.
 Sand _____
 Gas _____
 Oil _____
 Total Depth _____

PRODUCTION

1st 24 hrs. Nat. _____
 1st 24 hrs. after shot _____
 Gas _____ Cu. Ft.
 Dry Hole _____
 Abandoned _____

Date


7/24, 1917 Condy Scout

FORM 28 6-20-16 100 BOOKS OF 100 EACH
 Map No. _____ Sec. 14 Twp. 26 R. 4
 Well No. Shriner Farm _____
Cummins Company _____

NORTH

WEST

EAST

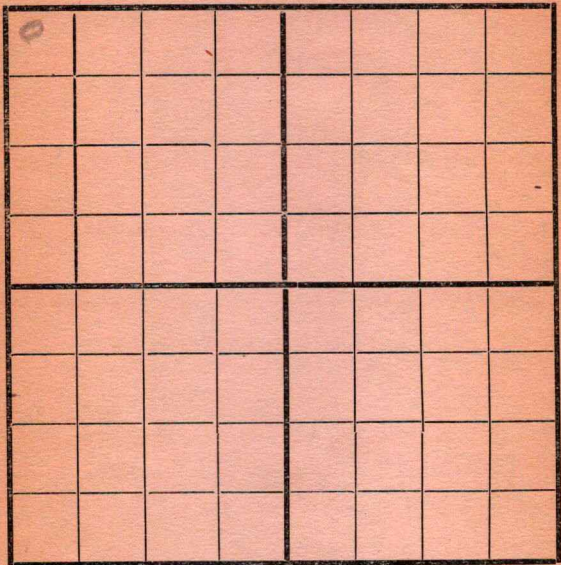

SOUTH

Location _____
 Rig Up _____
 Drilling and remarks _____

Straight
Running
1420

RECORD

Cased _____ in. _____ Ft.
 Sand _____
 Gas _____
 Oil _____
 Total Depth _____

PRODUCTION

1st 24 hrs. Nat. _____
 1st 24 hrs. after shot _____
 Gas _____ Cu. Ft.
 Dry Hole _____
 Abandoned _____


Date

8/1, 1917 C. Cardiff Scout _____

Map No. _____ Sec. 14 Twp. 26 R. 4Well No. 1 Shiner Farm _____Engine Company _____

NORTH

WEST

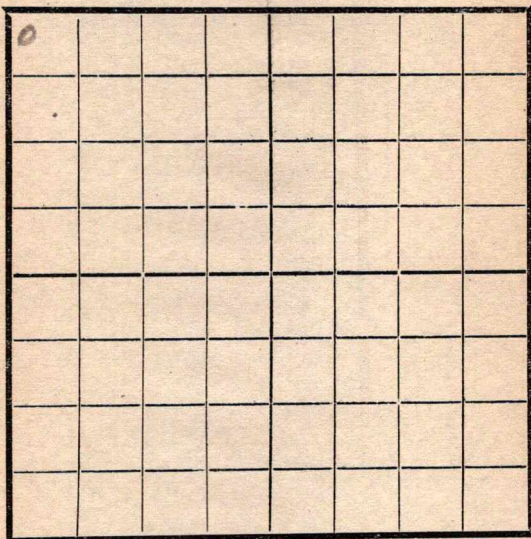

EAST

SOUTH

Location _____

Rig Up _____

Drilling and remarks

Under
Running
1420

RECORD

Cased _____ in. _____ Ft.

Sand _____

Gas _____

Oil _____

Total Depth _____

PRODUCTION

1st 24 hrs. Nat. _____

1st 24 hrs. after shot _____

Gas _____ Cu. Ft.

Dry Hole _____

Abandoned _____

Date

8/9, 1917 Candy Scout _____


Map No. _____ Sec. 14 Twp. 26 R. 4

Well No. 1 Shriver Farm _____

Engine Company _____

NORTH

WEST

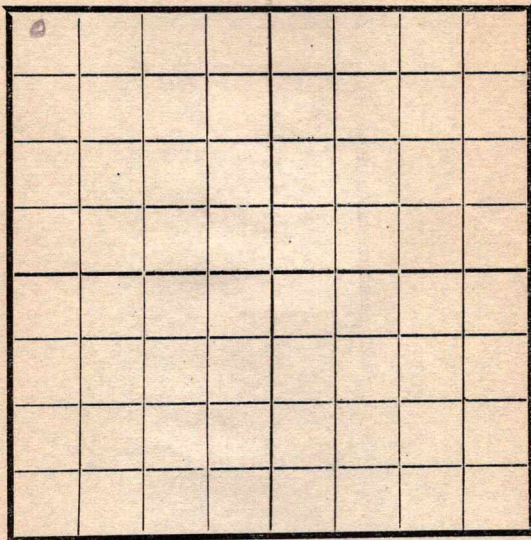

EAST

SOUTH

RECORD

Location _____

Cased _____ in. _____ Ft.

Rig Up _____

Sand _____

Drilling and remarks

Gas _____

Oil _____

Total Depth _____

PRODUCTION

1st 24 hrs. Nat. _____

1st 24 hrs. after shot _____

Gas _____ Cu. Ft.

Dry Hole _____

Abandoned _____

Date


8/17, 1917 Scout

Map No. _____ Sec. 44 Twp. 76 R. 4
 Well No. L. Shriver Farm _____
Empire Company _____

NORTH

WEST

EAST

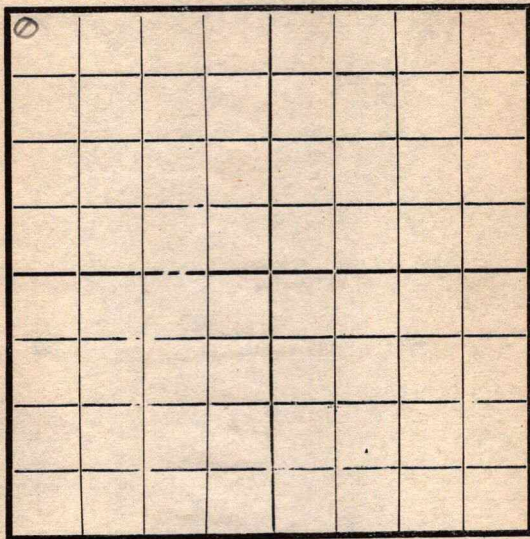

SOUTH

Location _____

Rig Up _____

Drilling and remarks

at 1635

RECORD

Cased _____ in. _____ Ft.

Sand _____

Gas _____

Oil _____

Total Depth _____

PRODUCTION

1st 24 hrs. Nat. _____

1st 24 hrs. after shot _____

Gas _____ Cu. Ft.

Dry Hole _____


Abandoned _____

Date

8-24, 1917Lantz

Scout

Map No. _____ Sec. 14 Twp. 26 R. 4
 Well No. 1 Shiner Farm _____
Engine Company _____
 NORTH

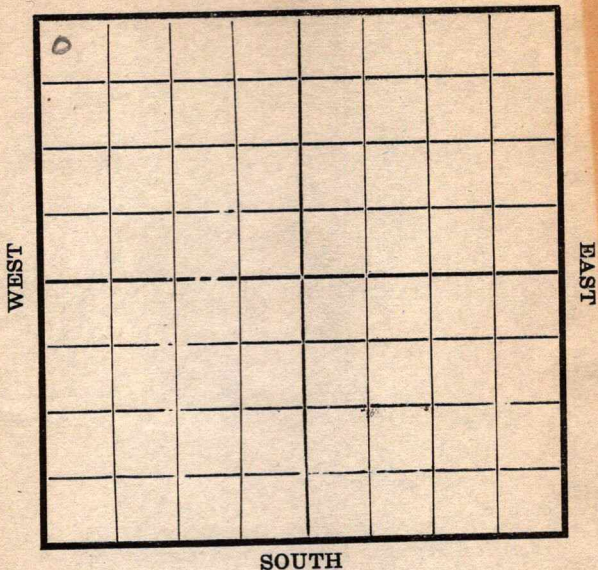

Location _____
 Rig Up _____
 Drilling and remarks

2055

RECORD

Cased _____ in. _____ Ft.
 Sand _____
 Gas _____
 Oil _____
 Total Depth _____

PRODUCTION

1st 24 hrs. Nat. _____
 1st 24 hrs. after shot _____
 Gas _____ Cu. Ft.
 Dry Hole _____
 Abandoned _____

Date

9/5, 1917 Engy Scout

Map No. _____ Sec. 14 Twp. 26 R. 4
 Well No. 1 Shiner Farm _____
Empire Company _____

NORTH

COMPLETED

WEST

EAST

SOUTH

Location _____

Rig Up _____

Drilling and remarks

*Est at
 100 lbs
 got some
 water in
 Bottom*

RECORD

Cased _____ in. _____ Ft.

Sand 2370-2425

Gas _____

Oil _____

Total Depth _____

PRODUCTION

1st 24 hrs. Nat. _____

1st 24 hrs. after shot _____

Gas _____ Cu. Ft.

Dry Hole _____

Abandoned _____

Date

9/19, 1917 Con Buff Scout