


Section 14 Township 26 ^{KANSAS} Range 4E

Well No. #4 Shiver (*Shriver*)

Company Sam Springer

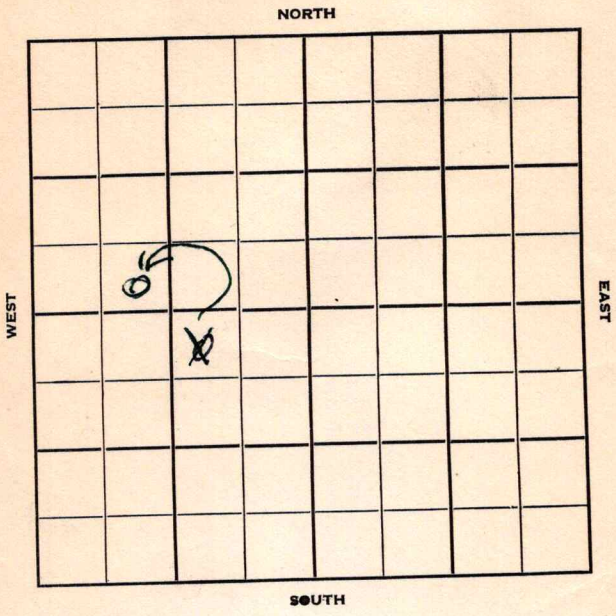

Butler

KANSAS

4E

Sec. 14 Twp. 26 R.

Well No. #4 Shiver Farm

Sam Springer Company

Eagle - Contr. Contractor


2400
330' Ft. from N. Line

Ft. from S. Line

990' Ft. from E. Line

1150 Ft. from W. Line

~~NW NE SW~~
SE SW NW

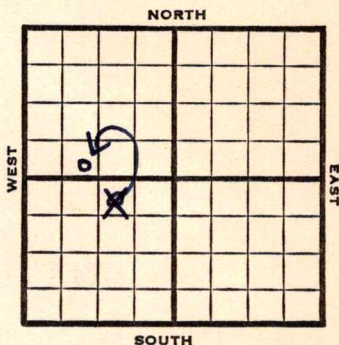


1952 Elev. 1358 REPORT

7/16 Spud 7-12-52
8" @ 89
Drlg. 860'

8/6 Spud 7-12-52
Oil Well TD 2408
8" @ 89
Arb. 2405
5" @ 2405
TD 2408
Comp. 25 bopd

COMPLETED

J. G. McGEHEE

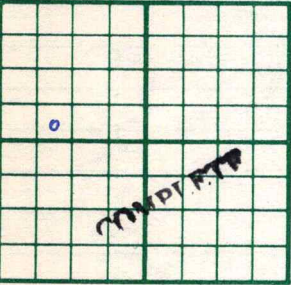County	Butler	State	Kansas	
Sec.	14	(Blk. Twp.)	26 (Sur. Rge.) 4E	Map No.
Operator	Sam Springer			
Well No.	4	Farm	Shriver	
Elev.	1358	Location	SE SW NW	
		2400	Ft. From N Line	NW
		1150	Ft. From W Line	Quarter
		1st. Report		
		Completion AUG 6 1952		
Remarks		Eagle - Contr.		
Spudding Date		7-12-52		
Orig. Data	Oil well	TD 2408		
8" @ 89	Arb. 2405	5" @ 2405	TD 2408	
Comp. 25 bopd				

J. G. McGEHEE

Map No. _____ Sec. 14 Twp. 26 R. 4EWell No. 4 Shriver

_____ Sam Springer _____ Company

_____ CORRECTION _____ Contractor


SE SW NW

SECTION PLAT

2400 Ft. from N. Line

_____ Ft. from S. Line

_____ Ft. from E. Line

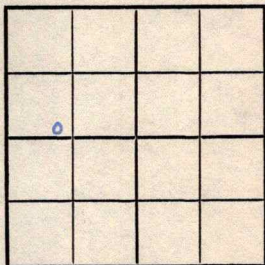1150 Ft. from W. LineButler County

Location _____

Rig up _____

Drilling and Remarks:

Reported

NW NE SW

RECORD

Cased _____ in., _____ ft.

Sand _____

Gas _____

Oil _____

Total Depth _____

PRODUCTION

1st 24 hrs. Nat. _____

1st 24 hrs. after shot _____

Gas _____ Cu. Ft.

Dry Hole _____

Abandoned _____

Date

JUL 23 1952 19J. G. McGEHEE Scout