

Map No. _____ Sec. 14 Twp. 26 R. 4Well No. 11-Shriver Farm __________Empire_____
Company

NORTH

WEST

EAST

SOUTH

Location _____

Rig Up _____

Drilling Remarks:

Drilling Remarks:

RECORD

Cased _____ in. _____ ft.

Sand _____

Gas _____

Oil _____

Total Depth _____

PRODUCTION

1st 24 hrs. Nat. _____

1st 24 hrs. after shot _____

Gas _____ cu. ft

Dry Hole _____


Abandoned _____

Map No. _____ Sec. 14 Twp. 26 R. 4Well No. 11 Shiner Farm _____

Company _____

NORTH

WEST

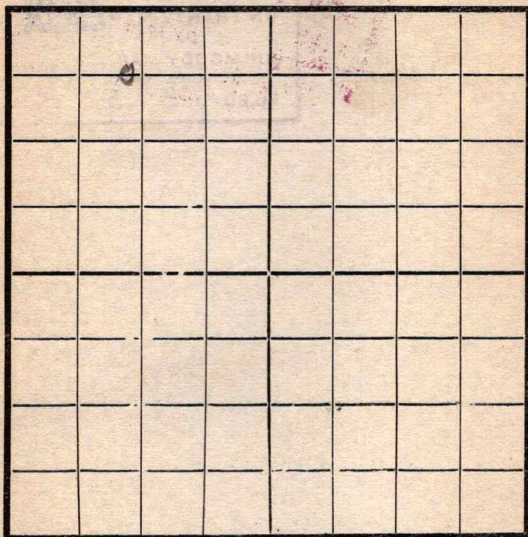

EAST

SOUTH

Location _____

Rig Up _____

Drilling and remarks _____

FIRST REPORT**RECORD**

Cased _____ in. _____ Ft.

Sand _____

Gas _____

Oil _____

Total Depth _____

PRODUCTION

1st 24 hrs. Nat. _____

1st 24 hrs. after shot _____

Gas _____ Cu. Ft.

Dry Hole _____

Abandoned _____


Date

9/19, 1917 Candy Scout

Map No. _____ Sec. 14 Twp. 26 R. 4
 Well No. 11 Shriver Farm _____
Cummins Company _____

NORTH

WEST

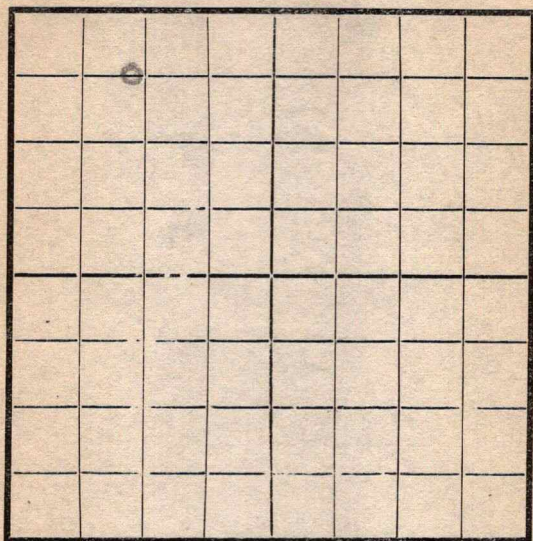

EAST

SOUTH

Location _____
 Rig Up ☒ _____
 Drilling and remarks _____

RECORD

Cased _____ in. _____ Ft.
 Sand _____
 Gas _____
 Oil _____
 Total Depth _____

PRODUCTION

1st 24 hrs. Nat. _____
 1st 24 hrs. after shot _____
 Gas _____ Cu. Ft.
 Dry Hole _____
 Abandoned _____

Date

2/9, 1917 Cummins Scout _____

Map No. _____ Sec. 14 Twp. 26 R. 4Well No. 11 Shriver Farm _____

_____ Company

NORTH

WEST

EAST

SOUTH

Location ✓Rig Up ✓

Drilling and remarks

RECORD

Cased _____ in. _____ Ft.

Sand _____

Gas _____

Oil _____

Total Depth _____

PRODUCTION

1st 24 hrs. Nat. _____

1st 24 hrs. after shot _____

Gas _____ Cu. Ft.

Dry Hole _____

Abandoned _____

Date

11-2, 1917 C. C. Cuddy Scout

Map No. _____ Sec. 14 Twp. 26 R. 4Well No. 11 Shriser Farm _____Company Engine

NORTH

WEST

EAST

SOUTH

Location _____

Rig Up ☒ _____

Drilling and remarks _____

RECORD

Cased _____ in _____ Ft.

Sand _____

Gas _____

Oil _____

Total Depth _____

PRODUCTION

1st 24 hrs. Nat. _____

1st 24 hrs. after shot _____

Gas _____ Cu. Ft.

Dry Hole _____

Abandoned _____


Date

11/14, 1917 Carroll Scout

Map No. _____ Sec. 14 Twp. 26 R. 4Well No. 11 Shriver Farm _____Engine Company _____

NORTH

WEST

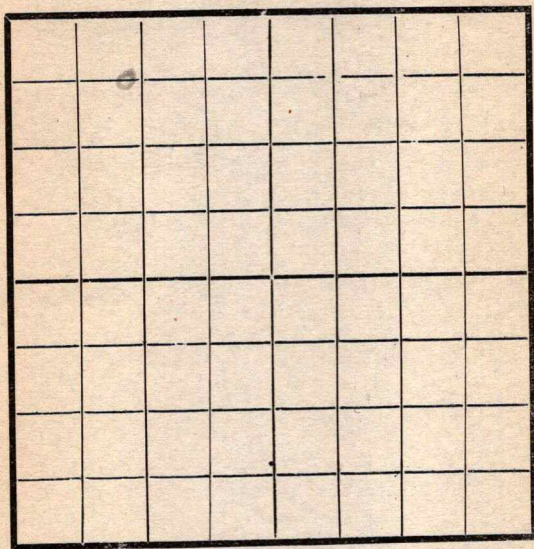

EAST

SOUTH

RECORD

Location _____

Rig Up ☒ _____

Drilling and remarks _____

Cased _____ in. _____ Ft.

Sand _____

Gas _____

Oil _____

Total Depth _____

PRODUCTION

1st 24 hrs. Nat. _____

1st 24 hrs. after shot _____

Gas _____ Cu. Ft.

Dry Hole _____

Abandoned _____

Date


11/21, 1917 C. C. C. Scout

Map No. _____ Sec. 14 Twp. 26 R. 4Well No. 11 Skinner Farm _____

_____ Company

NORTH

WEST

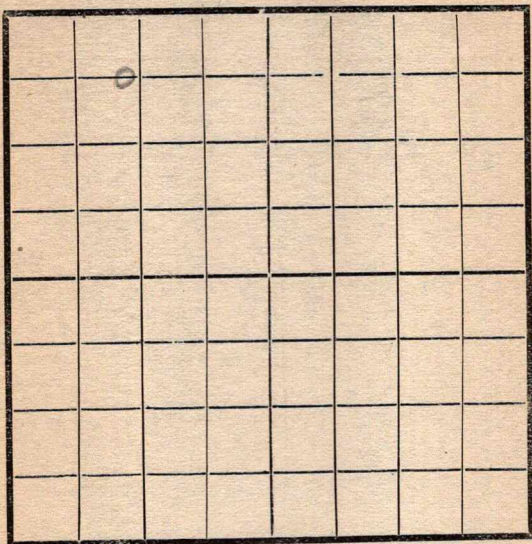

EAST

SOUTH

Location _____

Rig Up ☒ _____

Drilling and remarks _____

RECORD

Cased _____ in _____ Ft.

Sand _____

Gas _____

Oil _____

Total Depth _____

PRODUCTION

1st 24 hrs. Nat. _____

1st 24 hrs. after shot _____

Gas _____ Cu. Ft.

Dry Hole _____

Abandoned _____

Date

11/28, 1917 Cumley Scout

Map No. _____ Sec. 14 Twp. 26 R. 4Well No. 11 Shriver Farm _____Empire Company _____

NORTH

WEST

EAST

SOUTH

Location _____

Rig Up ☒ _____

Drilling and remarks _____

RECORD

Cased _____ in. _____ Ft.

Sand _____

Gas _____

Oil _____

Total Depth _____

PRODUCTION

1st 24 hrs. Nat. _____

1st 24 hrs. after shot _____

Gas _____ Cu. Ft.

Dry Hole _____

Abandoned _____


Date

10/5, 1917 Conley Scout _____

Map No. _____ Sec. 14 Twp. 26 R. 4Well No. 11 Skriver Farm _____Engine Company _____

NORTH

WEST

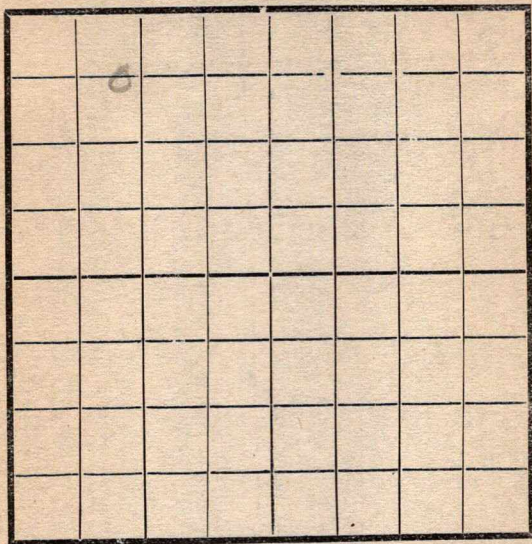

EAST

SOUTH

Location _____

Rig Up _____

Drilling and remarks

*Rigged
up*

RECORD

Cased _____ in. _____ Ft.

Sand _____

Gas _____

Oil _____

Total Depth _____

PRODUCTION

1st 24 hrs. Nat. _____

1st 24 hrs. after shot _____

Gas _____ Cu. Ft.

Dry Hole _____

Abandoned _____

Date

1/2, 1911 J. C. Leary Scout

Map No. _____ Sec. 14 Twp. 26 R. 4
 Well No. 11 Shriver Farm _____
Engine Company _____

NORTH

WEST

EAST

SOUTH

Location _____

Rig Up _____

Drilling and remarks

660

RECORD

Cased _____ in. _____ Ft.

Sand _____

Gas _____

Oil _____

Total Depth _____

PRODUCTION

1st 24 hrs. Nat. _____

1st 24 hrs. after shot _____

Gas _____ Cu. Ft.

Dry Hole _____

Abandoned _____

Date

1/16, 1918, J. C. C. C. Scout

Map No. _____ Sec. 14 Twp. 26 R. 4
 Well No. 11 Shreves Farm _____
Engine Company _____

NORTH

WEST

EAST

SOUTH

RECORD

Location _____
 Rig Up _____
 Drilling and remarks

Cased _____ in. _____ Ft.
 Sand _____
 Gas _____
 Oil _____
 Total Depth _____

PRODUCTION

1st 24 hrs. Nat. _____
 1st 24 hrs. after shot _____
 Gas _____ Cu. Ft.
 Dry Hole _____
 Abandoned _____

Date

1/23, 1918 Carney Scout _____

Map No. _____ Sec. 14 Twp. 26 R. 4Well No. 11 Shriver Farm _____
Engine Company

NORTH

WEST

EAST

SOUTH

Location _____

Rig Up _____

Drilling and remarks

RECORD

Cased _____ in. _____ Ft.

Sand _____

Gas _____

Oil _____

Total Depth _____

PRODUCTION

1st 24 hrs. Nat. _____

1st 24 hrs. after shot _____

Gas _____ Cu. Ft.

Dry Hole _____

Abandoned _____

Date

1/30, 1918 Scout

Map No. _____ Sec. 14 Twp. 26 R. 4
Well No. 11 Shiner Farm _____
Empire Company _____
Date Started _____ Ft. from N _____ S _____ E _____ W _____ line
NORTH

Date Started----- Ft. from N-----S-----E-----W-----line
NORTH

NORTH

A blank 8x8 grid with a thicker central cross. The grid is labeled with 'NORTH' at the top, 'SOUTH' at the bottom, 'WEST' on the left, and 'EAST' on the right. A small purple mark is visible in the top-left quadrant.

SOUTH

Cased -----In. -----Ft.

Sand -----

Pay	{	Gas	-----
		Oil	-----

Total Depth -----

Production Remarks

Condition of Well on this date-----


950

2/6/18 Condry

Scout

Map No. _____ Sec. 14 Twp. 26 R. 4
 Well No. 11 Shreve Farm _____
Crane Company _____
 NORTH

WEST

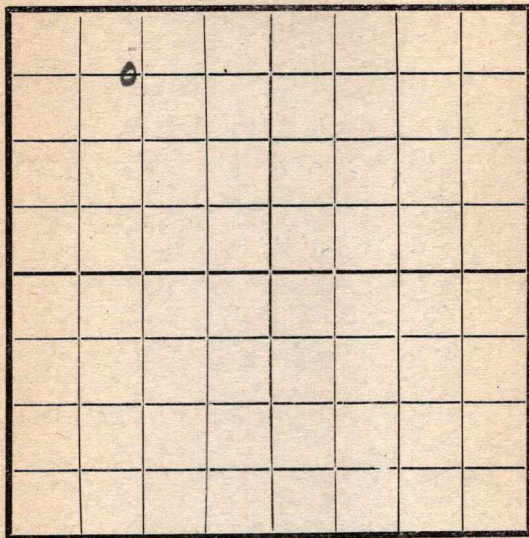

EAST

SOUTH

Location _____

Rig Up _____

Drilling and remarks

950

(Knightrise Co)
 CP Drilling

RECORD

Cased _____ in. _____ Ft.

Sand _____

Gas _____

Oil _____

Total Depth _____

PRODUCTION

1st 24 hrs. Nat. _____

1st 24 hrs. after shot _____

Gas _____ Cu. Ft.

Dry Hole _____

Abandoned _____

Date

2/13, 1918 C. C. C. C. Scout _____

Map No. _____ Sec. 14 Twp. 26 R. 4Well No. 11 Shiner Farm _____

Company _____

NORTH

WEST

EAST

SOUTH

Location _____

Rig Up _____

Drilling and remarks

RECORD
Cased _____ in. _____ Ft.

Sand _____

Gas _____

Oil _____

Total Depth _____

PRODUCTION

1st 24 hrs. Nat. _____

1st 24 hrs. after shot _____

Gas _____ Cu. Ft.

Dry Hole _____

Abandoned _____

Date

191

Scout


Map No. _____ Sec. 14 Twp. 26 R. 4

Well No. 11 Shriver Farm _____

Cummins Company _____

NORTH

WEST

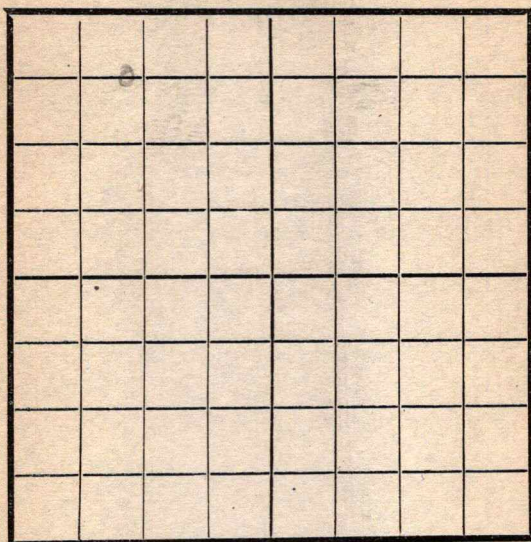

EAST

SOUTH

RECORD

Location _____

Cased _____ in. _____ Ft.

Rig Up _____

Sand _____

Drilling and remarks

Gas _____

Oil _____

Total Depth _____

1650

PRODUCTION

1st 24 hrs. Nat. _____

1st 24 hrs. after shot _____

Gas _____ Cu. Ft.

Dry Hole _____

Abandoned _____


Date

7/27, 1918 Cummins Scout _____

Map No. _____ Sec. 14 Twp. 26 R. 4Well No. 11 Shurmer Farm __________Cambridge Company _____

NORTH

WEST

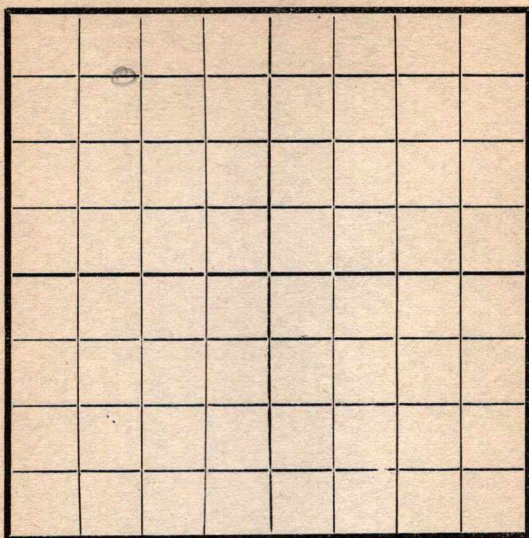

EAST

SOUTH

Location _____

Rig Up _____

Drilling and remarks

2150

RECORD

Cased _____ in. _____ Ft.

Sand _____

Gas _____

Oil _____

Total Depth _____

PRODUCTION

1st 24 hrs. Nat. _____

1st 24 hrs. after shot _____

Gas _____ Cu. Ft.

Dry Hole _____

Abandoned _____


Date

3/6, 1918 C. C. C. C. Scout _____

Map No. _____ Sec. 14 Twp. 26 R. 4Well No. 11 Shiner Farm __________Empire Company

NORTH

WEST

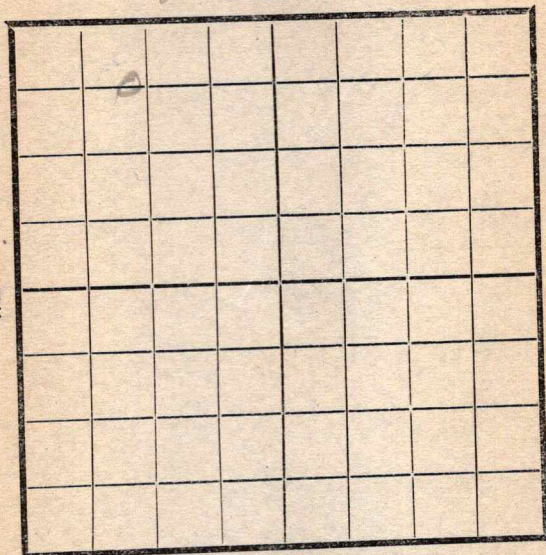

EAST

SOUTH

Location _____

Rig Up _____

Drilling and remarks

2340

RECORD

Cased _____ in. _____ Ft.

Sand _____

Gas _____

Oil _____

Total Depth _____

PRODUCTION

1st 24 hrs. Nat. _____

1st 24 hrs. after shot _____

Gas _____ Cu. Ft.


Dry Hole _____

Abandoned _____

Date

3/13, 1911 S. Conroy Scout

Map No. _____ Sec. 14 Twp. 26 R. 4
 Well No. 11-3-11-14 Farm _____
Engine Company _____
 NORTH

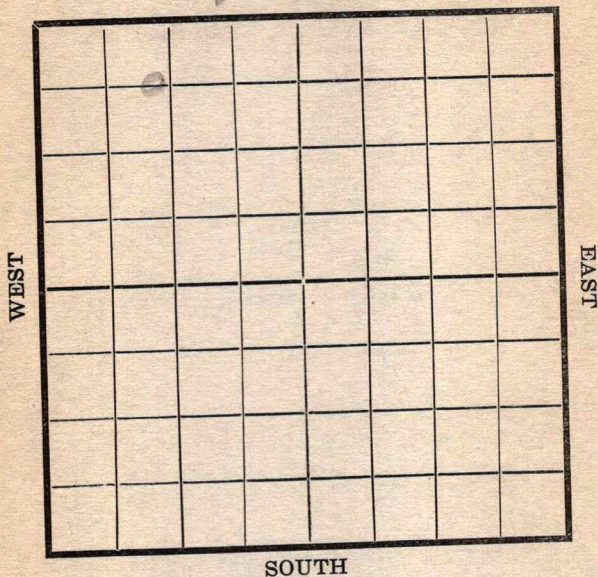

Location _____
 Rig Up _____
 Drilling and remarks

RECORD
 Cased _____ in. _____ Ft.
 Sand _____
 Gas _____
 Oil _____
 Total Depth _____

PRODUCTION
 1st 24 hrs. Nat. _____
 1st 24 hrs. after shot _____
 Gas _____ Cu. Ft.
 Dry Hole _____
 Abandoned _____


Date

3/20, 1911 S. C. S. Co. Scout

Map No. 514 Sec. 14 Twp. 26 R. 4Well No. 11 Shriver FarmEngine Company

NORTH

WEST

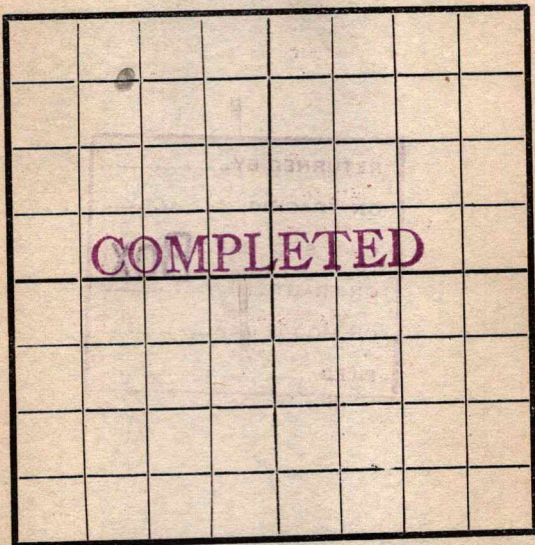

EAST

SOUTH

Location -----

Rig Up -----

Drilling and remarks

Est at
150 Bbs

RECORD

Cased ----- in. ----- Ft.

Sand 2376-2401

Gas -----

Oil -----

Total Depth -----

PRODUCTION

1st 24 hrs. Nat. -----

1st 24 hrs. after shot -----

Gas ----- Cu. Ft.

Dry Hole -----

Abandoned -----

Date

3/27, 1911 P. Condy Scout