

13

W

14

S

26

Section

Russell,

County

William Letsch, No. 5,

Farm

CONTINENTAL OIL CO.

Company

Sec.

Twp.


CEL W/2 SW

Elev. _____ T.D. 2850'

Date Drilled 3-7-38.

Correlation by _____

PROD. POT. 3240 B.

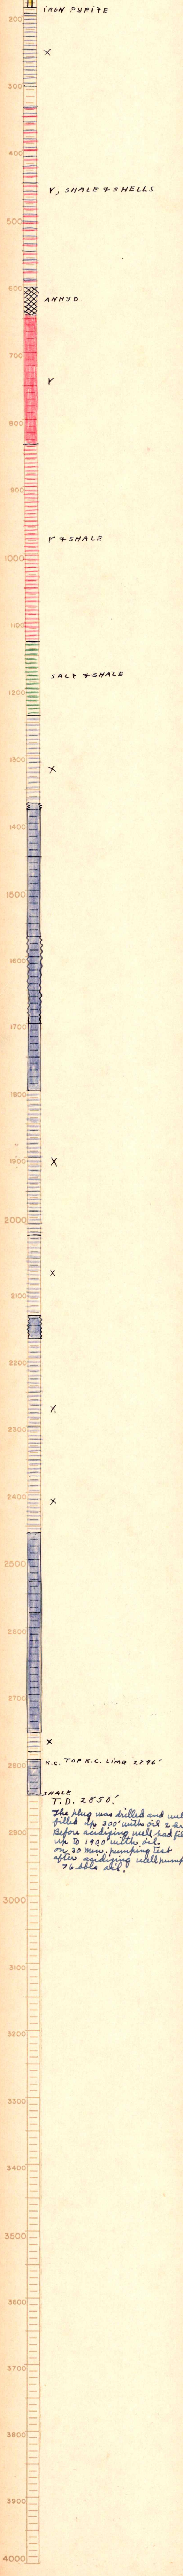

The plug was drilled and well filled up 300' with oil 2 hrs. Before acidizing well had filled up to 1900' with oil. on 30 min. pumping test after acidizing well pumped 76 bbls oil.