
Butler KANSAS

FORM 51 5M 2-38 TPCO.

Section 14 Township 26 Range 4-E

Well No. 23 Hamilton

Company Cities Service Oil

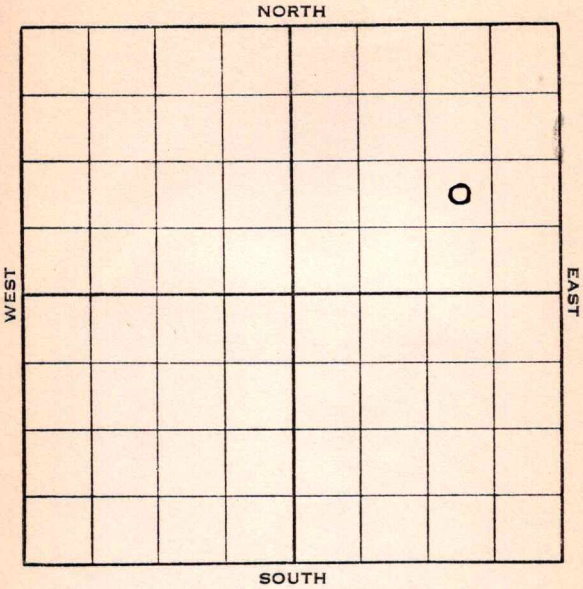

Form 252-A—5M—9-37 KANSAS Butler

Sec. 14 Twp. 26 R. 4-E

Well No. #23 Hamilton Farm


Cities Service Oil Company

_____ Ft. from N. Line

990 Ft. from S. Line

990 Ft. from E. Line

_____ Ft. from W. Line

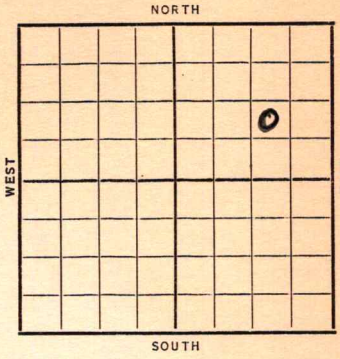


| Date | REPORT |
|---|---|
| 1938 | |
| 3/9 | Location |
| 3/18 | Mach. |
| 3/25 | 15" @ 46'. Drlg. 750'. |
| 4/1 | 12" @ 771'. Drlg. 1170'. |
| 4/8 | 10" @ 1565'. Lans. 1745'. |
| | K.C. 2003'. 8" @ 2101'. |
| | Drlg. 2102'. |
| 4/15 | Cong. 2401'. Arb. 2406'. |
| | 6" @ 2411'. T.D. 2411'. WOC. |
| | No shows. |
| 4/22 | T.D. 2443'. 1000 acid. |
| 4/29 | " " " " |
| 5/6 | " " " " |
| | |
| 5/10 | 6" @ 2411'. |
| | Arb. 2406'. |
| | T.D. 2443'. |
| | 1000 acid. |
| | Potential 50 oil. No water. |
| | |
| | COMPLETED |

Form 26—1M Bks.—2-29 Butler KANSAS

Map No. 14 Sec. 14 Twp. 26 R. 4E

Well No. 23 Hamilton

Cities Service Oil Company

Contractor

FIRST REPORT

NW SE NE


Ft. from N. Line

990 Ft. from S. Line

990 Ft. from E. Line

Ft. from W. Line

SECTION PLAT

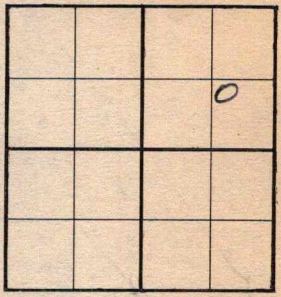

Location X

Rig up

Drilling and Remarks:

RECORD

Cased in., ft.

Sand

Gas

Oil

Total Depth

PRODUCTION

1st 24 hrs. Nat.

1st 24 hrs. after shot

Gas Cu. Ft.

Dry Hole

Abandoned

Date

MAR 9 - 1938

19

H. D. Hatfield Scout

Form 26—1M Bks.—2-29 Butler KANSAS

Map No. 14 Sec. 14 Twp. 26 R. 4E

Well No. 23 Hamilton

Cities Service Oil Company

Contractor

COMPLETED

NW SE NE


Ft. from N. Line

990 Ft. from S. Line

990 Ft. from E. Line

Ft. from W. Line

SECTION PLAT

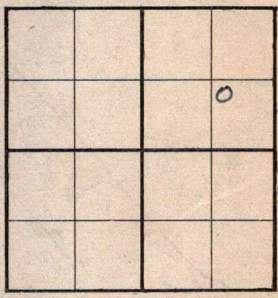


Location

Rig up

Drilling and Remarks:

1000 acid

POT 50 oil

NO WTR

RECORD

Cased 6 in., 2411 ft.

~~Sand~~ Arb 2406

Gas

Oil

Total Depth 2443

PRODUCTION

1st 24 hrs. Nat.

1st 24 hrs. after shot

Gas Cu. Ft.

Dry Hole

Abandoned

Date

MAY 10 1950

19

H. D. Hatfield Scout