

WEST

EAST

SOUTH

Location -----

Drilling Remarks:

Rig Up-----

Drilling Remarks:

RECORD

Cased----- in.-----ft.

Sand _____

Gas _____

Oil _____

Total Depth_____

PRODUCTION

1st 24 hrs. Nat.-----

1st 24 hrs. after shot-----


Gas-----cu. ft.

Dry Hole-----

Abandoned -----

Map No. _____ Sec. 14 Twp. 26 R. 4
 Well No. 1 Hamilton Farm _____
 _____ Emps. Company _____

NORTH

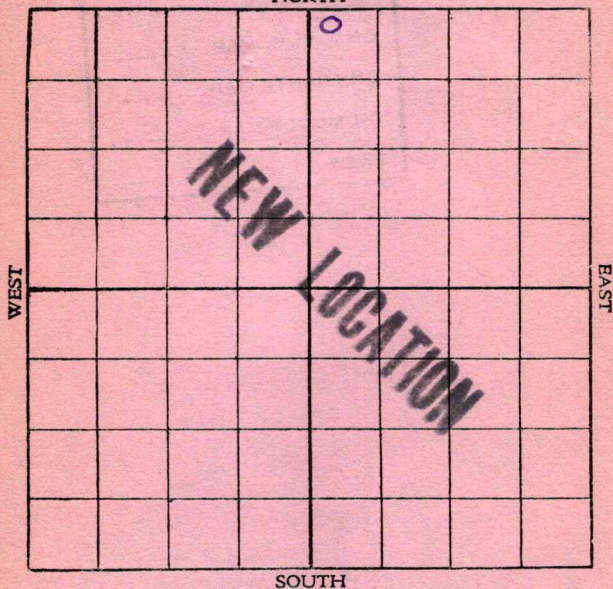

SOUTH

Location _____

Rig up _____

Drilling and remarks:

RECORD

Cased _____ in. _____ Ft.

Sand _____

Gas _____

Oil _____

Total Depth _____

PRODUCTION

1st 24 hrs. Nat. _____

1st 24 hrs. after shot _____

Gas _____ Cu. Ft.

Dry Hole _____

Abandoned _____


Date

JUN 22 1917

C. J. Crocker
 Scout

Map No. _____ Sec. 14 Twp. 26 R. 4
 Well No. 1 Hamilton Farm
Empire Company

NORTH

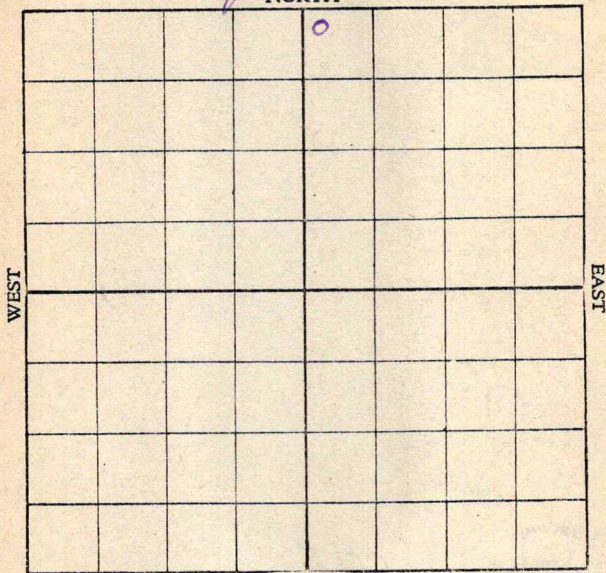

SOUTH

Location _____

Rig up ☒ _____

Drilling and remarks:

RECORD

Cased _____ in. _____ Ft.

Sand _____

Gas _____

Oil _____

Total Depth _____

PRODUCTION

1st 24 hrs. Nat. _____

1st 24 hrs. after shot _____

Gas _____ Cu. Ft.

Dry Hole _____

Abandoned _____

Date JUN 30 1917

191

C. T. Crocker Scout

Map No. _____ Sec. 14 Twp. 26 R. 4Well No. 1 Hamilton Farm __________Emp. Company

NORTH

				0			

WEST

EAST

SOUTH

Location _____

Rig up _____

Drilling and remarks:

Shud.

RECORD

Cased _____ in. _____ Ft.

Sand _____

Gas _____

Oil _____

Total Depth _____

PRODUCTION

1st 24 hrs. Nat. _____

1st 24 hrs. after shot _____

Gas _____ Cu. Ft.

Dry Hole _____

Abandoned _____

Date


JUL 7 1917

191

G. J. Crocker Scout

Map No. _____ Sec. 14 Twp. 26 R. 4Well No. 1 Hamilton Farm _____
Empire Company

NORTH

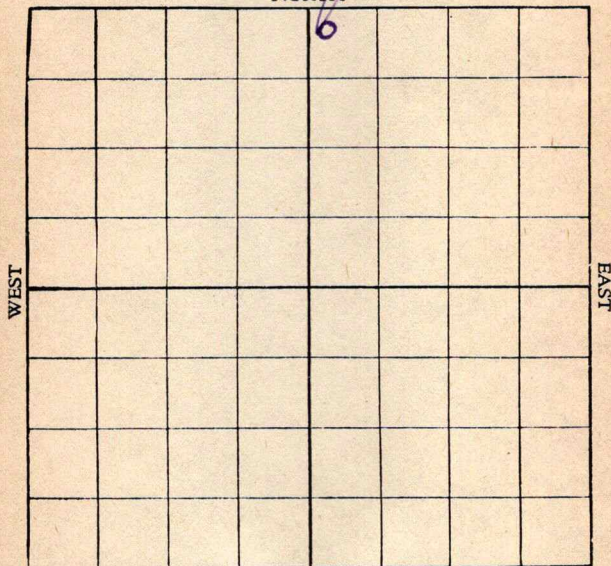

SOUTH

Location _____

Rig up _____

Drilling and remarks:

SD. 660'

RECORD

Cased _____ in. _____ Ft.

Sand _____

Gas _____

Oil _____

Total Depth _____

PRODUCTION

1st 24 hrs. Nat. _____

1st 24 hrs. after shot _____

Gas _____ Cu. Ft.

Dry Hole _____

Abandoned _____


Date

JUL 14 1917

C. J. Crocker Scout

Map No. _____ Sec. 14 Twp. 26 R. 4
 Well No. 1 Hamilton Farm _____
Empire Company _____
 NORTH

WEST

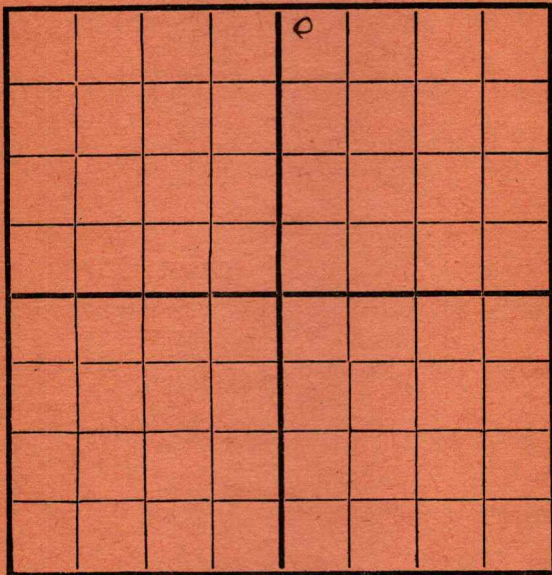

EAST

SOUTH

Location _____

Rig Up _____

Drilling and remarks

Shut Down
P50

RECORD

Cased _____ in. _____ Ft.

Sand _____

Gas _____

Oil _____

Total Depth _____

PRODUCTION

1st 24 hrs. Nat. _____

1st 24 hrs. after shot _____

Gas _____ Cu. Ft.

Dry Hole _____

Abandoned _____


Date

7/24, 1917 Cordiff Scout

Map No. _____ Sec. 14 Twp. 26 R. 4Well No. 1 Hamilton Farm __________Empire Company _____

NORTH

WEST

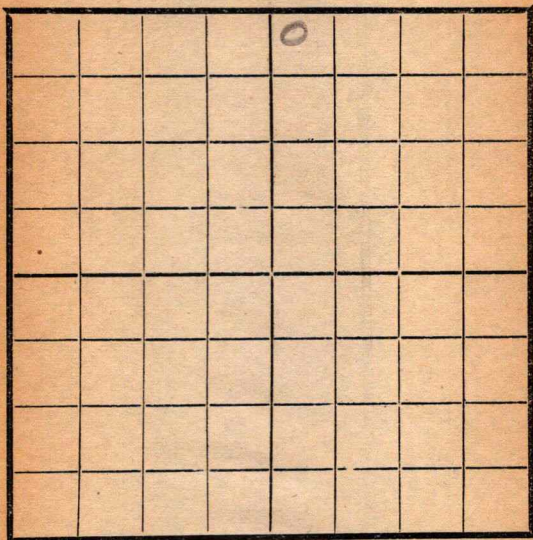

EAST

SOUTH

Location _____

Rig Up _____

Drilling and remarks

*Shut
Down
1080*

RECORD

Cased _____ in. _____ Ft.

Sand _____

Gas _____

Oil _____

Total Depth _____

PRODUCTION

1st 24 hrs. Nat. _____

1st 24 hrs. after shot _____

Gas _____ Cu. Ft.

Dry Hole _____

Abandoned _____

Date

8/9, 191*7* *C. C. C.* Scout _____

Map No. _____ Sec. 14 Twp. 40 R. 4
 Well No. 1. Hamilton Farm _____
Co. Myrice Company _____

NORTH

WEST

EAST

SOUTH

Location _____

Rig Up _____

Drilling and remarks

at 1875

RECORD

Cased _____ in. _____ Ft.

Sand _____

Gas _____

Oil _____

Total Depth _____

PRODUCTION

1st 24 hrs. Nat. _____

1st 24 hrs. after shot _____

Gas _____ Cu. Ft.

Dry Hole _____

Abandoned _____


Date

8-24, 1917Lantz Scout

Map No. _____ Sec. 14 Twp. 26 R. 4Well No. 1 Hamilton Farm _____Engine Company _____

NORTH

WEST

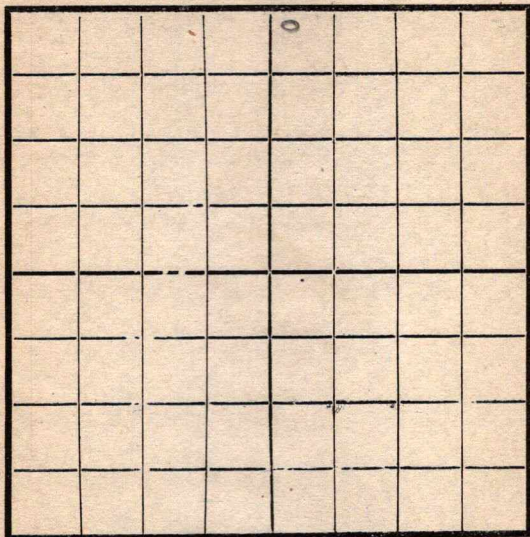

EAST

SOUTH

Location _____

Rig Up _____

Drilling and remarks

Day sand
2376

RECORD

Cased _____ in. _____ Ft.

Sand _____

Gas _____

Oil _____

Total Depth _____

PRODUCTION

1st 24 hrs. Nat. _____

1st 24 hrs. after shot _____

Gas _____ Cu. Ft.


Dry Hole _____

Abandoned _____

Date

9/5, 1917 Conroy Scout _____

Map No. _____ Sec. 14 Twp. 26 R. 4
Well No. 1 Hamilton Farm _____
Empire Company _____

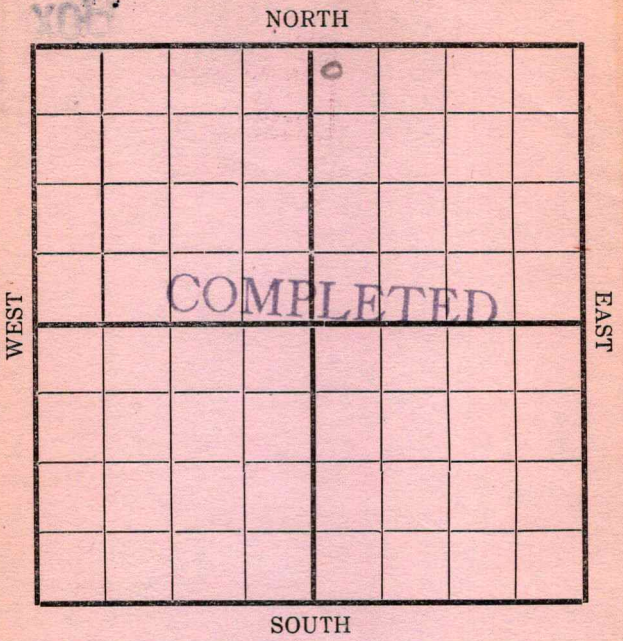

	RECORD
Location _____	Cased _____ in. _____ Ft.
Rig Up _____	Sand <u>7351-2406</u>
Drilling and remarks	Gas _____
<u>Estimated</u>	Oil _____
<u>at 600</u>	Total Depth _____
<u>1362</u>	
	PRODUCTION
	1st 24 hrs. Nat. _____
	1st 24 hrs. after shot _____
	Gas _____ Cu. Ft.
	Dry Hole _____
	Abandoned _____

Date 7/12, 1912 Condiff Scout