


Map No. \_\_\_\_\_ Sec. 14 Twp. 26 R. 4  
 Well No. 3 McClure Farm \_\_\_\_\_  
Empire Company \_\_\_\_\_

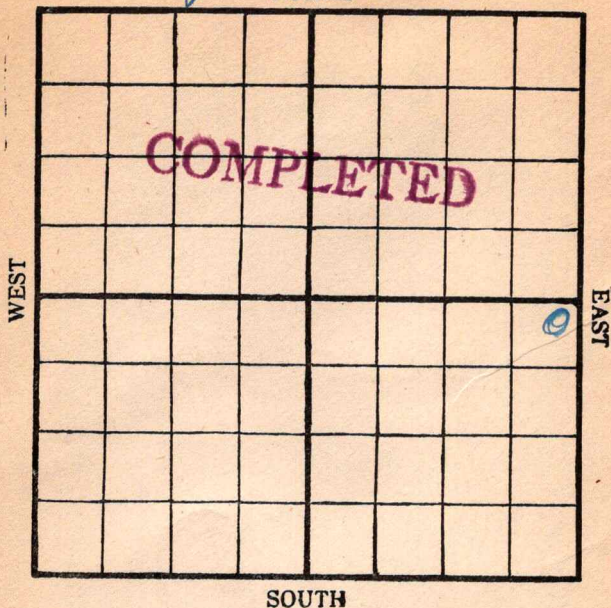

Location \_\_\_\_\_

Rig Up \_\_\_\_\_

Drilling Remarks:

Drilling Remarks:

175 Bbls. (and 2411-2410)

5/20.

### RECORD

### PRODUCTION

Cased \_\_\_\_\_ in. \_\_\_\_\_ ft.

1st 24 hrs. Nat. \_\_\_\_\_

Sand \_\_\_\_\_

1st 24 hrs. after shot \_\_\_\_\_

Gas \_\_\_\_\_

Gas \_\_\_\_\_ cu. ft.

Oil \_\_\_\_\_

Dry Hole \_\_\_\_\_


Total Depth \_\_\_\_\_

Abandoned \_\_\_\_\_

Map No. H14 Sec. 14 Twp. 26 R. 4  
 Well No. 3 McChure Farm  
Empire Company

NORTH

WEST

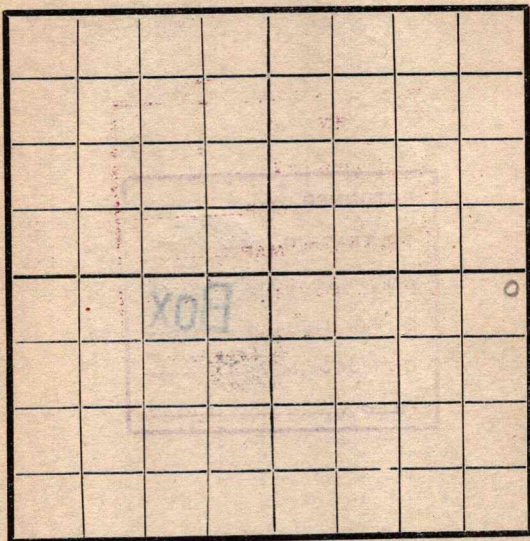

EAST

SOUTH

Location \_\_\_\_\_  
 Rig Up ☒ \_\_\_\_\_  
 Drilling and remarks \_\_\_\_\_

## FIRST REPORT

### RECORD

Cased \_\_\_\_\_ in. \_\_\_\_\_ Ft.  
 Sand \_\_\_\_\_  
 Gas \_\_\_\_\_  
 Oil \_\_\_\_\_  
 Total Depth \_\_\_\_\_

### PRODUCTION

1st 24 hrs. Nat. \_\_\_\_\_  
 1st 24 hrs. after shot \_\_\_\_\_  
 Gas \_\_\_\_\_ Cu. Ft.  
 Dry Hole \_\_\_\_\_  
 Abandoned \_\_\_\_\_

Date

3/13, 1918 E. Cordery Scout

Map No. \_\_\_\_\_ Sec. 14 Twp. 26 R. 4Well No. 3 MacClure Farm \_\_\_\_\_Company Empire

NORTH

WEST

EAST

SOUTH

Location \_\_\_\_\_

Rig Up \_\_\_\_\_

Drilling and remarks

1085

## RECORD

Cased \_\_\_\_\_ in. \_\_\_\_\_ Ft.

Sand \_\_\_\_\_

Gas \_\_\_\_\_

Oil \_\_\_\_\_

Total Depth \_\_\_\_\_

## PRODUCTION

1st 24 hrs. Nat. \_\_\_\_\_

1st 24 hrs. after shot \_\_\_\_\_

Gas \_\_\_\_\_ Cu. Ft.

Dry Hole \_\_\_\_\_

Abandoned \_\_\_\_\_


Date

4/17, 1918 S. C. Cady Scout \_\_\_\_\_

Map No. \_\_\_\_\_ Sec. 14 Twp. 26 R. 4  
 Well No. 3 Two Course Farm \_\_\_\_\_  
Cummins Company

NORTH

WEST

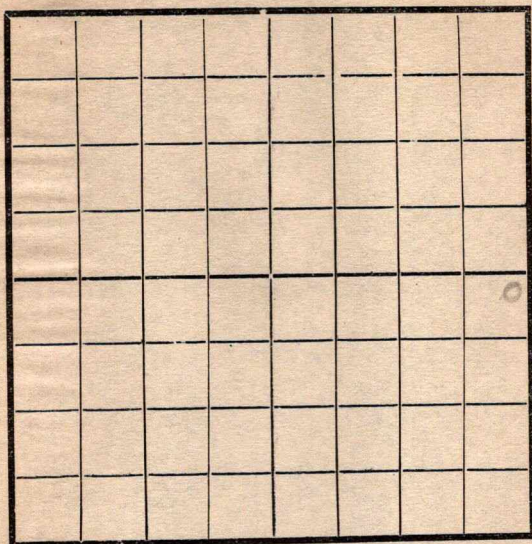

EAST

SOUTH

Location \_\_\_\_\_

Rig Up \_\_\_\_\_

Drilling and remarks

1400

## RECORD

Cased \_\_\_\_\_ in. \_\_\_\_\_ Ft.

Sand \_\_\_\_\_

Gas \_\_\_\_\_

Oil \_\_\_\_\_

Total Depth \_\_\_\_\_

## PRODUCTION

1st 24 hrs. Nat. \_\_\_\_\_

1st 24 hrs. after shot \_\_\_\_\_

Gas \_\_\_\_\_ Cu. Ft.

Dry Hole \_\_\_\_\_

Abandoned \_\_\_\_\_


Date

5/1, 1918 Scout

Map No. \_\_\_\_\_ Sec. 14 Twp. 26 R. 4  
 Well No. 3 McChure Farm \_\_\_\_\_  
Empire Company

NORTH

WEST

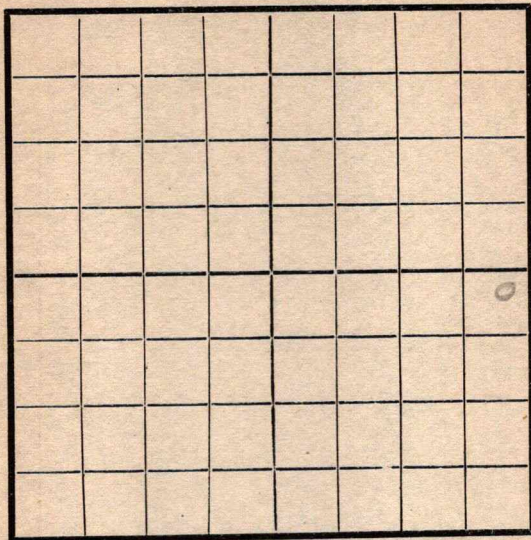

EAST

SOUTH

Location \_\_\_\_\_  
 Rig Up \_\_\_\_\_  
 Drilling and remarks

### RECORD

Cased \_\_\_\_\_ in. \_\_\_\_\_ Ft.  
 Sand \_\_\_\_\_  
 Gas \_\_\_\_\_  
 Oil \_\_\_\_\_  
 Total Depth \_\_\_\_\_

### PRODUCTION

1st 24 hrs. Nat. \_\_\_\_\_  
 1st 24 hrs. after shot \_\_\_\_\_  
 Gas \_\_\_\_\_ Cu. Ft.  
 Dry Hole \_\_\_\_\_  
 Abandoned \_\_\_\_\_


Date

5/8, 1918 Empire Scout

Map No. \_\_\_\_\_ Sec. 14 Twp. 26 R. 4  
 Well No. 3 McChes Farm \_\_\_\_\_  
Empire Company \_\_\_\_\_

NORTH

WEST

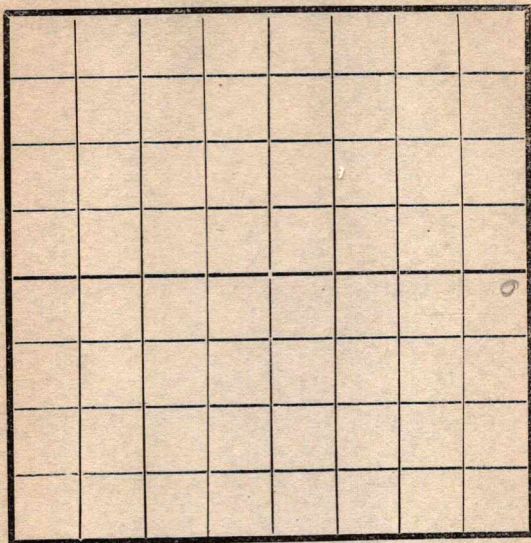

EAST

SOUTH

Location \_\_\_\_\_  
 Rig Up \_\_\_\_\_  
 Drilling and remarks

2235

## RECORD

Cased \_\_\_\_\_ in \_\_\_\_\_ Ft.  
 Sand \_\_\_\_\_  
 Gas \_\_\_\_\_  
 Oil \_\_\_\_\_  
 Total Depth \_\_\_\_\_


## PRODUCTION

1st 24 hrs. Nat. \_\_\_\_\_  
 1st 24 hrs. after shot \_\_\_\_\_  
 Gas \_\_\_\_\_ Cu. Ft.  
 Dry Hole \_\_\_\_\_  
 Abandoned \_\_\_\_\_

Date

5/15, 1918 Condyff Scout \_\_\_\_\_

Map No. \_\_\_\_\_ Sec. 14 Twp. 26 R. 4  
Well No. 3 Mc Clell Farm. \_\_\_\_\_  
Amphure Company  
NORTH

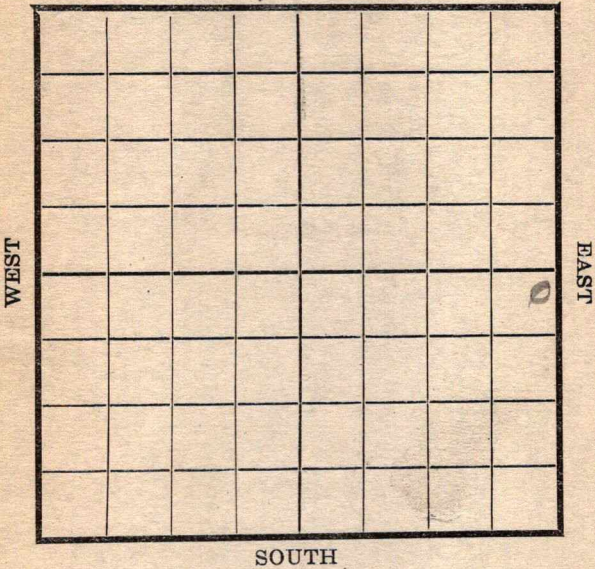

| RECORD                         |                              |
|--------------------------------|------------------------------|
| Location _____                 | Cased _____ in. _____ Ft.    |
| Rig Up _____                   | Sand _____                   |
| Drilling and remarks           | Gas _____                    |
|                                | Oil _____                    |
|                                | Total Depth _____            |
|                                | PRODUCTION                   |
| <u>Top sand</u><br><u>2411</u> | 1st 24 hrs. Nat. _____       |
|                                | 1st 24 hrs. after shot _____ |
|                                | Gas _____ Cu. Ft.            |
|                                | Dry Hole _____               |
|                                | Abandoned _____              |

Date 7-22-1911 Scout

Map No. 114 Sec. 14 Twp. 26 R. 4Well No. 3. McClureEmpire H & F Co Company

Contractor

NORTH

WEST

COMPLETED

EAST

5/22/18 Estimated  
at 175 Bbls-

SOUTH

Location

Rig up

Drilling and Remarks:

Rigging  
Hallagers  
Cedarvale

## RECORD

Cased \_\_\_\_\_ in., \_\_\_\_\_ ft.

Sand \_\_\_\_\_ 2411-2470

Gas \_\_\_\_\_

Oil \_\_\_\_\_

Total Depth \_\_\_\_\_

## PRODUCTION

1st 24 hrs. Nat. \_\_\_\_\_

1st 24 hrs. after shot \_\_\_\_\_

Gas \_\_\_\_\_ Cu. Ft.

Dry Hole \_\_\_\_\_

Abandoned \_\_\_\_\_

Date

5/27 8 Cardiff

191

Scout


Map No. 114 Sec. 14 Twp. 26 R. 4

Well No. 3 McChure Farm

Brumfield Company

NORTH

WEST

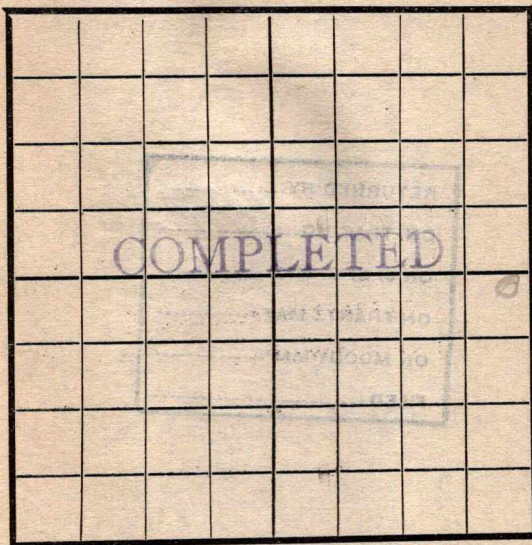

EAST

SOUTH

Location -----

Rig Up -----

Drilling and remarks

*Est 24*  
*175*  
*0266*

### RECORD

Cased ----- in. ----- Ft.

Sand 2411-2470

Gas -----

Oil -----

Total Depth -----

### PRODUCTION

1st 24 hrs. Nat. -----

1st 24 hrs. after shot -----

Gas ----- Cu. Ft.

Dry Hole -----

Abandoned -----

Date

5/30, 1918 S. Conkey Scout