


Map No. _____ Sec. 14 Twp. 26 R. 4
 Well No. 7 McClure Farm _____
 _____ Empire Company

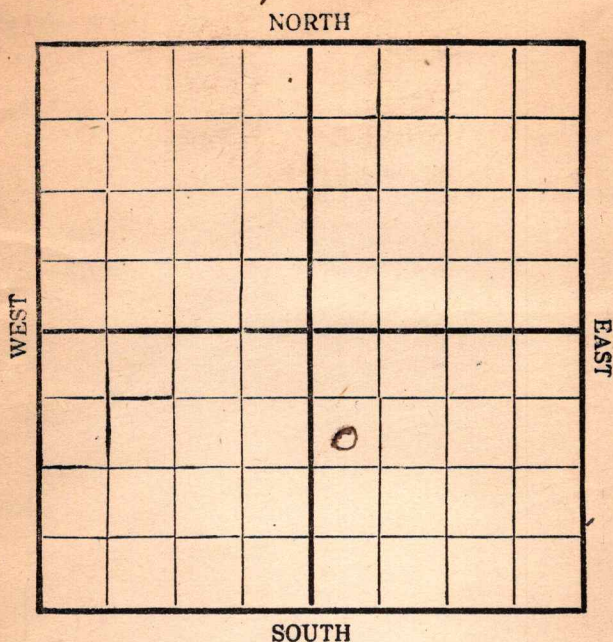

Location _____

Rig Up _____

Drilling Remarks:

Drilling Remarks:

COMPLETED

RECORD

PRODUCTION

Cased _____ in. _____ ft.

1st 24 hrs. Nat. _____

Sand _____

1st 24 hrs. after shot _____

Gas _____

Gas _____ cu. ft.

Oil _____

Dry Hole _____


Total Depth _____

Abandoned _____

Map No. _____ Sec. 14 Twp. 26 R. 4Well No. 7. McClure FarmEmpire G. & T. Co CompanyContractor J.B. Quarter990 Ft. from N. Line

_____ Ft. from S. Line

_____ Ft. from E. Line

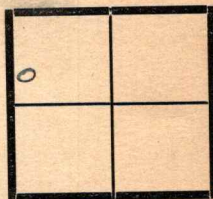380 Ft. from W. Line


Date

REPORT

17.11Rig.11/17/20 SD for 8'4" 2050'4/3 Dry Hae. 2490

COMPLETED

Map No. K14 Sec. 14 Twp. 26 R. 4
 Well No. 7 M. C. Chase
Empire Company
 Contractor

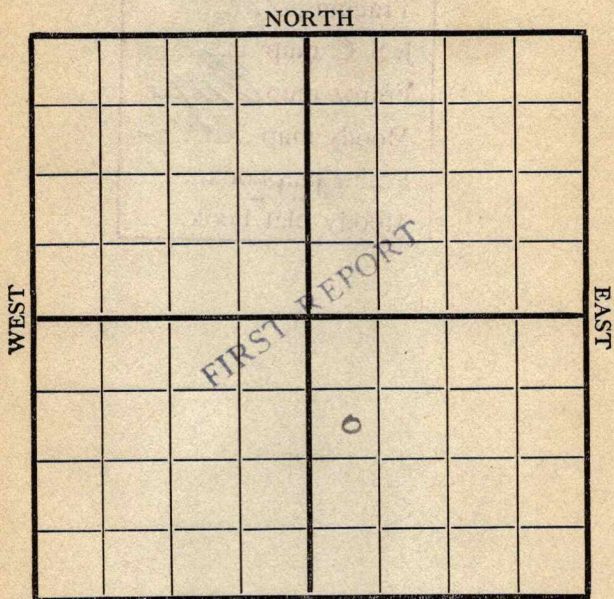

990 N

SOUTH

380 W

Location _____

Rig up ☒

Drilling and Remarks:

RECORD

Cased _____ in., _____ ft.

Sand _____

Gas _____

Oil _____

Total Depth _____

PRODUCTION

1st 24 hrs. Nat. _____

1st 24 hrs. after shot _____

Gas _____ Cu. Ft.

Dry Hole _____

Abandoned _____

Date

6/27 1919

Pyle

Scout

Map No. K14 Sec. 14 Twp. 26 R. 4Well No. 7 Mc Clure

----- Company


----- Contractor

SECTION PLAT

990 Ft. from N. Line

----- Ft. from S. Line

----- Ft. from E. Line

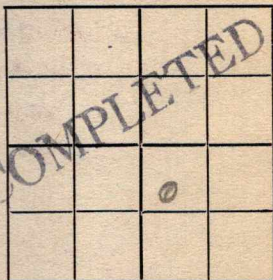380 Ft. from W. Line

Location -----

Rig up -----

Drilling and Remarks:

RECORD

Cased ----- in., ----- ft.

Sand -----

Gas -----

Oil -----

Total Depth -----

PRODUCTION

1st 24 hrs. Nat. -----

1st 24 hrs. after shot -----

Gas ----- Cu. Ft.

Dry Hole 2490 -----

Abandoned -----

Date

4/3 1920

Pyle

----- Scout

Barton
K14 KANSAS SEC. *14* TWP. *26S* R. *VE*
 MAP NO. _____
 WELL No. *7 M.C. Chum*
B. m. p. v. e. COMPANY _____

CONTRACTOR _____

SECTION PLAT

ABANDONED

_____ FT. FROM N. LINE
 _____ FT. FROM S. LINE
 _____ FT. FROM E. LINE
 _____ FT. FROM W. LINE

		0	

LOCATION _____

RIG UP _____

DRILLING AND REMARKS:

RECORD

CASED _____ IN. _____ FT.
 SAND _____
 GAS _____
 OIL _____
 TOTAL DEPTH *2490*

PRODUCTION

1ST 24 HRS. NAT. _____
 1ST 24 HRS. AFTER SHOT _____
 GAS _____ Cu. Ft.
 DRY HOLE ☒
 ABANDONED ☒

DATE

5/1 1920 _____ SCOUT