


SECTION 14 TOWNSHIP 26S RANGE 4E

WELL NO. #1 Fowler

COMPANY J.P. Gaty

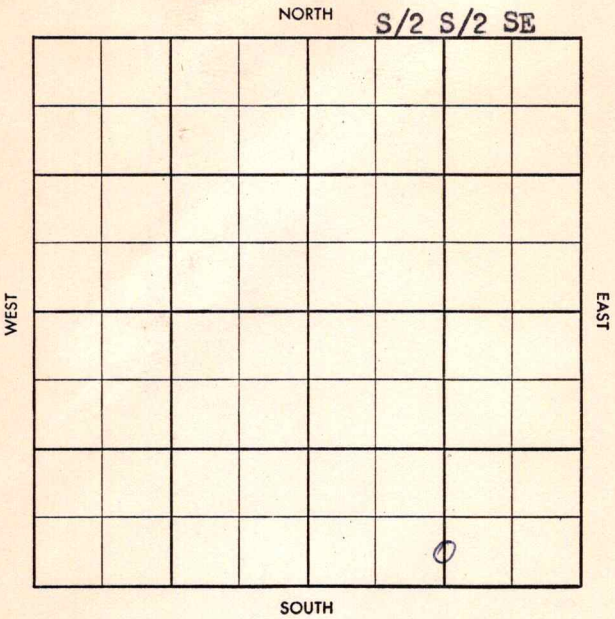

Tw. ~~Pool~~

Co. ~~Facet~~

S-513-B

County Butler Elev. 1371 RB
 Sec. 14 Twp. 26 Rge. 4E
 Company J. P. Gaty
 Farm Name Fowler No. 1

TOPS	DEPTH	LOG	DATUM
Anh.			
Tp.			
H.			
Tr.			
Dg.			
B.L.			
L.			
K.C.	2032		
B.K.C.	2193		
x Ft. Scot.	2351		
x Detrl Zn	2432		
M.			
M.			
K.			
Mz.			
Mq.			
V. Sd	2447		
S.			
S.	2451		
A.			
R.			
Pf.			
G.			
T.D.			

Loc. in Sec. S/2 S/2 SE

Geol. Glen Delg.

Pool ELDorado

FIRST REPORT
 JUL 9 58

Date Comm. 7-2-58
10" @ 120, Tops, (highly Sat. @ 2465 $\frac{1}{2}$ -69 $\frac{1}{2}$)
DST 2444-60 1 hr NR of rec 0#, DST 2458-68,
1 hr 10 ocm some free oil, BHP 530#, RTD
2500, rung 7"

Twp. Pool
Co. Face

S-513-B

County Butler Elev. 1371 RB 13690E
Sec. 14 Twp. 26 Rge. 4E
Company J. F. Caty
Farm Name Fowler No. 1

TOPS	DEPTH	LOG	DATUM
Anh.			
Tp.			
H.			
Tr.			
Dg.			
B.L.			
L.			
K.C.	2032		
B.K.C.	2193		
O.Ft. Scot.	2351		
x. Detrl Zn	2432		
M.			
M.			
K.			
Mz.			
Mq.			
V.			
S. Cd	2447		
S.			
A.	2451		
R.			
Pf.			
G.			
T.D.	2500		

Loc. in Sec. S/2 S/2 SE

Geol. Glen Delg.
Contr.

Pool ElDorado

ABANDONED

AUG 6 '58

Date Comm. 7-2-58
10" @ 120, Tops, (highly Sat. @ 24651-69)

DST 2444-60 1 hr NR of rec Off, DST 2458-68,
1 hr 10 ocm some free oil, BHP 530ff, RTL

2500, rung 7" JUL 16 '58 2500 JUL 23 '58

16/ 2463-67 fac P9-10

Bope NW JUL 30 '58 AUG 6 '58 wtr increased

D6A