

Section 14 Township 26 Range 4EWell No. #1 FowlerCompany Holley Oil

NORTH

WEST

EAST

	0						

SOUTH

Butler

Sec. 14 Twp. 26 R. 4E

Well No. #1 Fowler Farm

Holley Oil Company

Murfin - Contr. Contractor


El Dorado

330' Ft. from N. Line

Ft. from S. Line

Ft. from E. Line

990' Ft. from W. Line

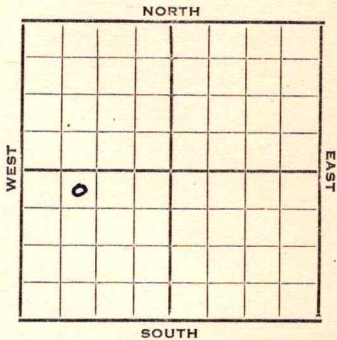

NE NW SW

1952 Elev. 1342' REPORT

3/26 5/7 RUR CT

Spud 3-29-52

Oil Well TD 2410'

13" @ 995' 10" @ 1615'

Lans. 1767 KC 1995

8" @ 2235' Arb. 2399-2410

5" @ 2401 TD 2410 2 boph

Comp. 25 bopd

COMPLETED

J. G. McGEHEE

J. G. McGEHEE