


SECTION 15 TOWNSHIP 26S RANGE 4EWELL NO. #1 TurnerCOMPANY A. D. Allison

NORTH

~~SW SE NW~~
~~SE NW SE~~

WEST

EAST

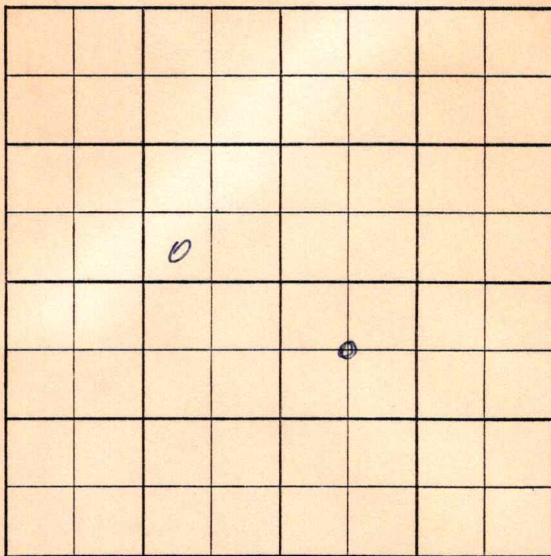

SOUTH

Twp. ~~X~~ Pool ~~X~~

Ge. ~~X~~ Facet ~~2/5~~

S-513-B

County Butler Elev. _____
 Sec. 15 Twp. 26 Rge. 4E
 Company A. D. Allison
 Farm Name Turner No. 1

TOPS	DEPTH	LOG	DATUM
------	-------	-----	-------

Anh.			
Tp.			
H.			
Tr.			
Dg.			
B.L.			
L.			
K.C.			
B.K.C.			
Ce.			
C.			
M.			
M.			
K.			
Mz.			
Mq.			
V.			
S.			
S.			
A.			
R.			
Pf.			
G.			
T.D.			

Loc. in Sec. _____

C NW SE

Geol. Wharton

Contr. G. D.

Smitherman

Pool _____

ElDorado



Date Comm. 6-13-58

8" @ 130, Drlg. 1600.

~~Twp. Pool~~

~~CORRECTION Twp. Pool~~

~~Co. Facet~~

~~Co.~~

~~Facet~~

S-513-B

County Butler Elev. 1315KB 13140E
Sec. 15 Twp. 26 Rge. 1317NB 4E
Company A. D. Allison
Farm Name Turner No. 1

TOPS	DEPTH	LOG	DATUM
Anh.			
Tp.			
H.			
Tr.			
Dg.			
B.L.			
L.	<u>1790</u>		
K.C.	<u>2005</u>		
B.K.C.	<u>2165</u>		
Q <u>Marm</u>	<u>2351</u>		
C.			
M.			
M.			
K.			
Mz.			
Mq.			
V.			
S. <u>5d</u>	<u>2448</u>		
S.			
A.			
R.			
Pf.			
G.			
T.D.	<u>2507</u>		

Loc. in Sec. G NW SE

SW SE NW

Geol. Wharton

Contr. G. D.

Smitherman

Pool

Eldorado

COMPLETE

JUL 2 '58

Date Comm. 6-13-58

8" @ 130, Drlg. 1600. JUL 5 '58 ud 2450-82

m32 2450-72 sh 2472-82

5" 2507 CO 2480 20/2448-S3

16/2456-60 FU 2430' oil NW 12hrs

T&R JUL 2 '58 5 BOPh NW

4hrs

POP
P 25 BOPh NW