


Section 3 Township 26 Range 8E

Well No. #9 Barrier

Company Jackson Bros

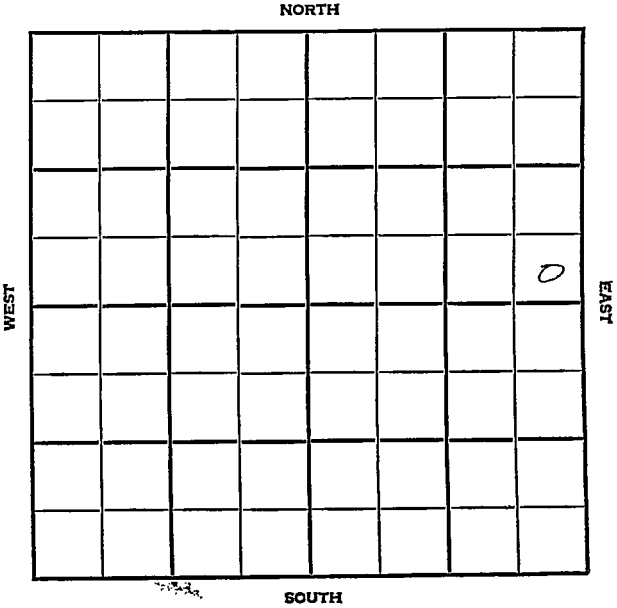

Greenwood

KANSAS

SEC.

TWP.

R.

3

26

8E

WELL NO.

#9 Barrier

FARM

COMPANY

Jackson Bros.

CONTRACTOR

Sunflower

Sallyards


____ FT. FROM N. LINE

____ FT. FROM S. LINE

____ FT. FROM E. LINE

____ FT. FROM W. LINE

SE SE NE

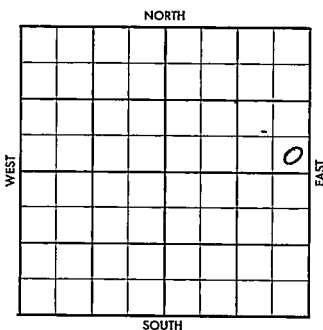

1956

ELEVATION

REPORT

6-6

Comm. 6-4-56
Drlg. 150

8-1

8 5/8" @ 100
4 1/2" @ 2511
CO 2490 40/2474-84
P/ 60 bopd
Bv. 2450'; M. 2510';
TD 2511'

COMPLETED

TOPS	DEPTH	LOG	DATUM	Loc. in Sec.
Anh.				SE SE NE
Tp.				
H.				
Tr.				
Dg.				
Bl.				
L.				Geol.
K.C.				Contr.
B.K.C.				Sunflower
Ce.				
C.				Pool
M.				Sallyards
M.				
K.				
Mz.				
Me.				
V.				
S.				
S.				
A.				
R.				
Pc.				
G.				
T.D.				

Lse.
No.

JUN 6 \$6
FIRST REPORT

Date Comm. 6-1-56
drlg. 150

1951
 1952
County Greenwood Elev. _____
 Sec. 3 Twp. 26 Rge. 8E
 Company Jackson Bros.
 Farm Name Barrier No. 9

TOPS	DEPTH	LOG	DATUM	Loc. in Sec.
Anh.				<u>SE SE NE</u>
Tr.				
H.				
Tr.				
Dg.				
BL.				
L.				Geol. _____
K.C.				Contr. _____
B.K.C.				<u>Sunflower</u>
Ce. <u>134</u>	<u>2450</u>			<u>Pool</u>
C.				<u>Sallyards</u>
M.	<u>2510</u>			
M.				
K.				
Mz.				
Ma.				
V.				
S.				
S.				
A.				
R.				
Pe.				
G.				
T.D. <u>2511</u>	<u>2545</u>			

Date Comm. 6-4-56 AUG 1 1956
 drlg. 150 JUN 13 '56 85/8-100', 4 1/2 2511
C.O. JUN 20 '56 JUN 27 '56 JUL 3 '56 JUL 11 '56
 JUL 18 '56 JUL 25 '56 AUG 1 '56 CO 2490
40/2474-84 FRAC., P. 60
Bopd