Butler


KANSAS

SECTION 16 TOWNSHIP 26S RANGE 4E

WELL NO. #1 Davis

COMPANY J. E. Morris & Kewanee

NORTH NW NE SW

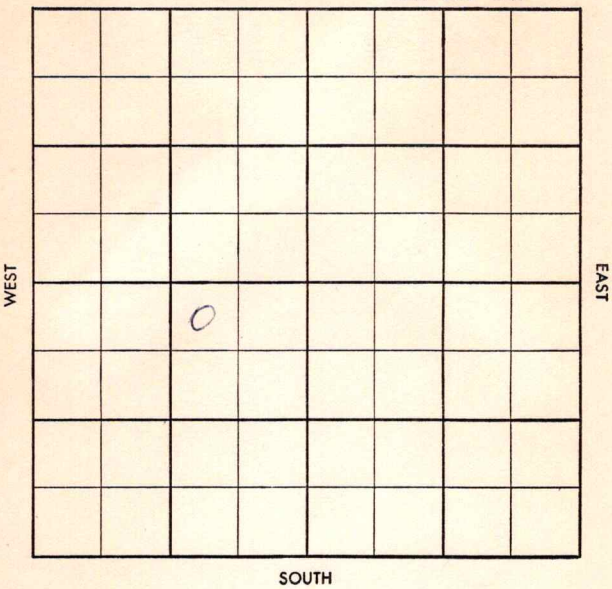

FORM 504-3 SUNRAY

Twp. X Pool X

Co. X Prod. 39

S-513-B

County Butler Elev.

Sec. 16 Twp. 26 Rge. 4E

Company J. E. Morris and Kewanee

Farm Name Davis No. 1


TOPS	DEPTH	LOG	DATUM
Anh.			
Tp.			
H.			
Tr.			
Dg.			
B. L.			
L.			
K.C.			
B.K.C.			
Ce.			
C.			
M.			
M.			
K.			
Mz.			
Mq.			
V.			
S.			
S.			
A.			
R.			
Pf.			
G.			
T.D.			

Loc. in Sec. NW NE SW

Geol.

Contr. Co. Tools

Pool ElDorado

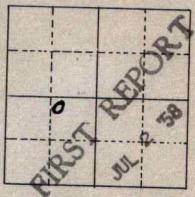

Date Comm. WORT

Co. Lse. No. Sec. T. R.

Twp. X Pool X

Co. X Facet X

S-513-B

County Butler Elev. 1275 DF 1278 RB

Sec. 16 Twp. 26 Rge. 4E

Company J. E. Morris and Kewanee

Farm Name Davis No. 1

TOPS	DEPTH	LOG	DATUM
Anh.			
Tp.			
H.			
Tr.			
Dg.			
B. L.	1698		
L.	1770		
K.C. B L sd	1944		
B.K.C. K C	2078		
Ce. B K C	2244		
C. Ft Scot	2319		
M.	2486		
M. dolo	2536		
K.	2632		
Mz.			
Mq.			
V.	2701		
S. s d	2727		
S.			
A.			
R.			
Pf.			
G.			
T.D.	2743		

Loc. in Sec. NW NE SW

Geol.

Contr. Co. Tools

Pool El Dorado

ABANDONED

0

JUL 16 '58

Date Comm. 7-7-58 8" 218/200

WOPT. JUL 9 '58 WOC JUL 16 '58 Log

D&A

Co. Lse. No. Sec. T. R.