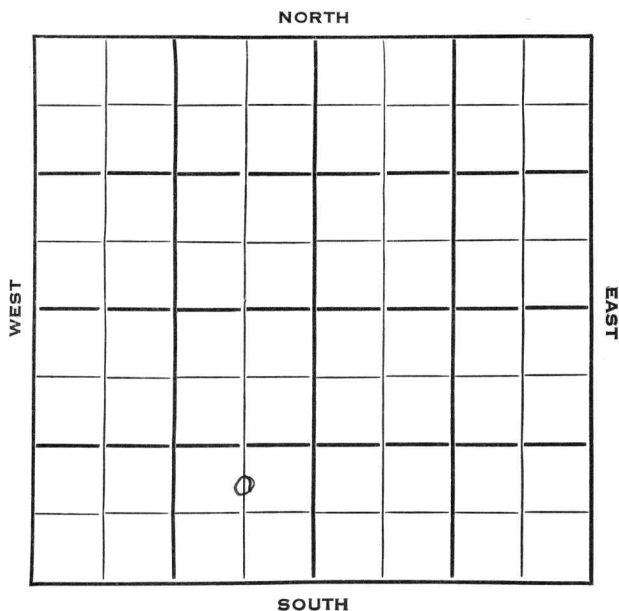


Well No. # 34 Houston

[illegible]

Butler		KANSAS
SEC.	TWP.	R.
19	26	5E

WELL NO.

#34 Houston

FARM

COMPANY

Cities Service

CONTRACTOR

Eldorado Pool

NORTH

Ft. from N. Line

825


Ft. from S. Line

660

Ft. from E. Line

Ft. from W. Line

C N L SE SW

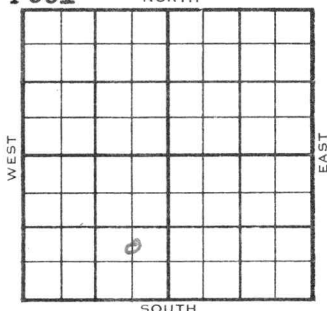

	ELEVATION	REPORT
1954	1351' RB	

4/14

Oil Well

TD 2683'

8" @ 131'

Viola 2630', Simp 2646'

4" @ 2648'

TD 2673'

DD2683'

22/ 2654-68

47/ 2632-42

SP 2643

2000 A

Comp 24 bopd 127 bw.

FIRST REPORT
COMPLETED

County Butler State Kansas
 Sec. 19 (Blk.) 26 (Sur.) 5E Map No.
 Operator Cities Service
 Well No. 34 Farm Houston
 Elev. 1351 RB Location C N L SE SW

FIRST REPORT
 COMPLETE
 0

825 Ft. From S Line SW
660 Ft. From E Line Quarter
 Ist. Report APR 14 1954
 Completion APR 14 1954
 Remarks Eldorado Pool
 Spudding Date

Drlg. Data Oil well TD 2683
8" @ 131 Viola 2630 Simp. 2646
4" @ 2648 TD 2673 DD 2683 22/ 2654-68
47/ 2632-42 SP 2643 2000 A
Comp. 24 bopd 127 bw

J. G. McGEHEE