

Map No. _____ Sec. 25, Twp. 26, R. 4Well No. 2 Shreves Farm
Morton Prairie Company

NORTH

WEST

EAST



SOUTH

Location _____

Rig up _____

Drilling Remarks:

Drilling Remarks:

RECORD

Cased _____ in. _____ ft.

Sand _____

Gas _____

Oil _____

Total Depth _____

PRODUCTION

1st 24 hrs. Nat. _____

1st 24 hrs. after shot _____

Gas _____ Cu. Ft.

Dry Hole _____

Abandoned _____

Map No. _____ Sec. 25 Twp. 26 R. 4Well No. 2 Shreene Farm _____

Morton Company _____

NORTH

WEST

EAST

SOUTH

Location _____

Rig Up ☒ _____

Drilling and remarks

200 S of N.L.
760 W of E.L.

RECORD

Cased _____ in. _____ Ft.

Sand _____

Gas _____

Oil _____

Total Depth _____

PRODUCTION

1st 24 hrs. Nat. _____

1st 24 hrs. after shot _____

Gas _____ Cu. Ft.

Dry Hole _____

Abandoned _____

Date

1/23, 1918 B. Cardy Scout _____


Final Report

Map No. _____ Sec. 25 Twp. 26 R. 4Well No. 2 Shreener Farm
Morton Company

NORTH

WEST

EAST

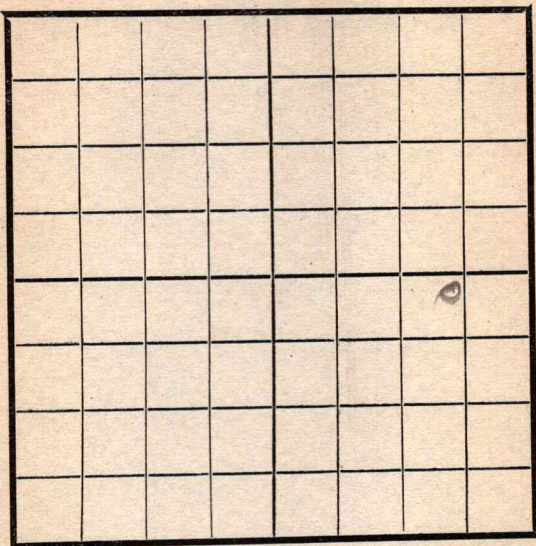

SOUTH

Location _____

Rig Up _____

Drilling and remarks

640

RECORD

Cased _____ in. _____ Ft.

Sand _____

Gas _____

Oil _____

Total Depth _____

PRODUCTION

1st 24 hrs. Nat. _____

1st 24 hrs. after shot _____

Gas _____ Cu. Ft.

Dry Hole _____

Abandoned _____


Date

9/30, 1918 Scout

Map No. _____ Sec. 25 Twp. 36 R. 4
 Well No. 2 Shreeves Farm _____
A. D. Morton Company

NORTH

WEST

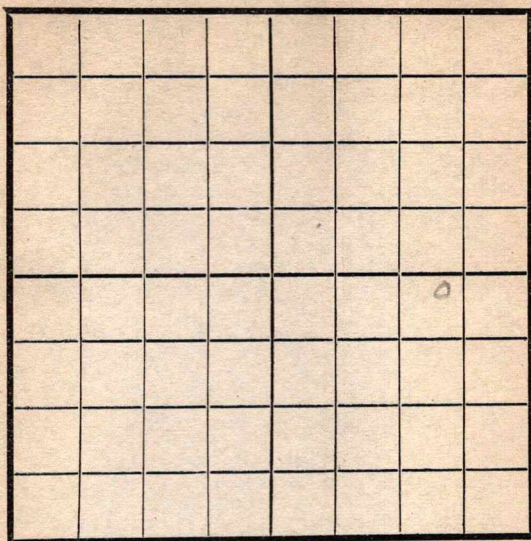

EAST

SOUTH

Location _____
 Rig Up _____
 Drilling and remarks

1100

RECORD

Cased _____ in. _____ Ft.
 Sand _____
 Gas _____
 Oil _____
 Total Depth _____

PRODUCTION

1st 24 hrs. Nat. _____
 1st 24 hrs. after shot _____
 Gas _____ Cu. Ft.
 Dry Hole _____
 Abandoned _____

John Strosny Jr.
Augusta
Kansas

Date

2/27, 1918 _____ Scout

Map No. _____ Sec. 25 Twp. 26 R. 4Well No. 2 Shreeves Farm _____Prairie Oils Company _____

NORTH

WEST

EAST

SOUTH

Location _____

Rig Up _____

Drilling and remarks

RECORD

Cased _____ in. _____ Ft.

Sand _____

Gas _____

Oil _____

Total Depth _____

PRODUCTION

1st 24 hrs. Nat. _____

1st 24 hrs. after shot _____

Gas _____ Cu. Ft.

Dry Hole _____

Abandoned _____

Date

3/6, 1918 P. Caudy ScoutPrairie Oils Co
have taken over
this lease from
A D Norton


Map No. _____ Sec. 25 Twp. 26 R. 4

Well No. 2 Shreeves Farm

Morton-Paine Company

NORTH

WEST

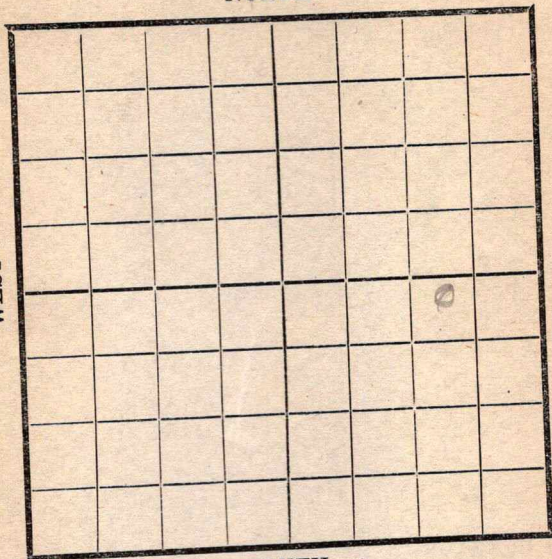

EAST

SOUTH

Location. _____

Rig Up _____

Drilling and remarks

RECORD

Cased _____ in. _____ Ft.
 Sand _____
 Gas _____
 Oil _____
 Total Depth _____

PRODUCTION

1st 24 hrs. Nat. _____
 1st 24 hrs. after shot _____
 Gas _____ Cu. Ft.
 Dry Hole _____
 Abandoned _____


Date

3/13, 1918 S. Condy Scout

Map No. _____ Sec. 25 Twp. 26 R. 4Well No. 2 Shreene FarmPrairie Company

NORTH

WEST

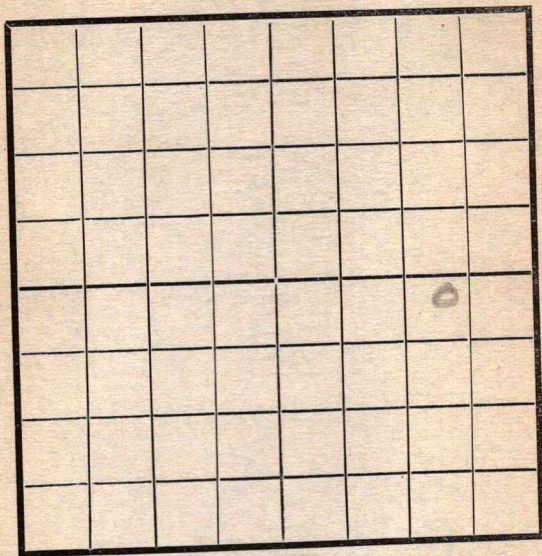

EAST

SOUTH

RECORD

Location _____

Cased _____ in. _____ Ft.

Rig Up _____

Sand _____

Drilling and remarks

Gas _____

Oil _____

Total Depth _____

PRODUCTION

1st 24 hrs. Nat. _____

1st 24 hrs. after shot _____

Gas _____ Cu. Ft.

Dry Hole _____

Abandoned _____


Date

3/20, 1911 J. C. Canby Scout

Map No. _____ Sec. 25 Twp. 26 R. 4
 Well No. 2 Shreve Farm _____
Pringle Company _____

NORTH

WEST

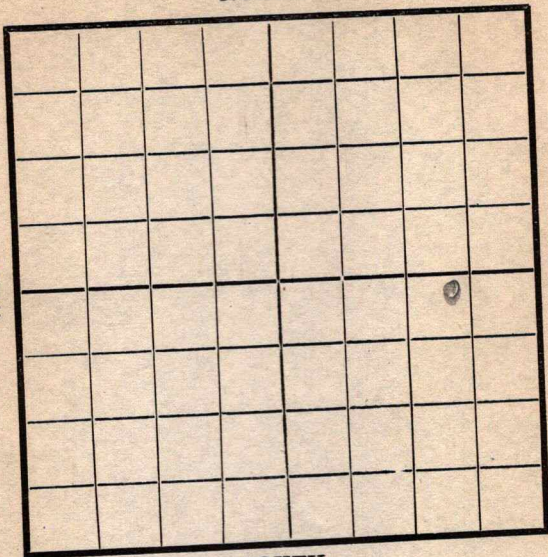

EAST

SOUTH

RECORD

Location _____
 Rig Up _____
 Drilling and remarks _____

Cased _____ in. _____ Ft.
 Sand _____
 Gas _____
 Oil _____
 Total Depth _____

PRODUCTION

1st 24 hrs. Nat. _____
 1st 24 hrs. after shot _____
 Gas _____ Cu. Ft.
 Dry Hole _____
 Abandoned _____

*Top sand 2665
 10 ft in int.
 1800' oil in
 hole*

Date

Scout

3/27, 1918 *J. C. [Signature]*

Map No. _____ Sec. 25 Twp. 26 R. 4Well No. 2 Shreves Farm _____Prairie Oil Company _____

NORTH

WEST

EAST

COMPLETED

SOUTH

Location _____

Rig up _____

Drilling and remarks:

Est at 200
1760

RECORD

Cased _____ in. _____ Ft.

Sand 2661-2685

Gas _____

Oil _____

Total Depth _____

PRODUCTION

1st 24 hrs. Nat. _____

1st 24 hrs. after shot _____

Gas _____ Cu. Ft.

Dry Hole _____

Abandoned _____

Date

4/1

, 191

8 Co. S. J.

Scout