


Map No. K Sec. 9 Twp. 26 R. 8  
 Well No. Blankenship Farm  
Bullman Oil Company  
50' west of dry hole #4

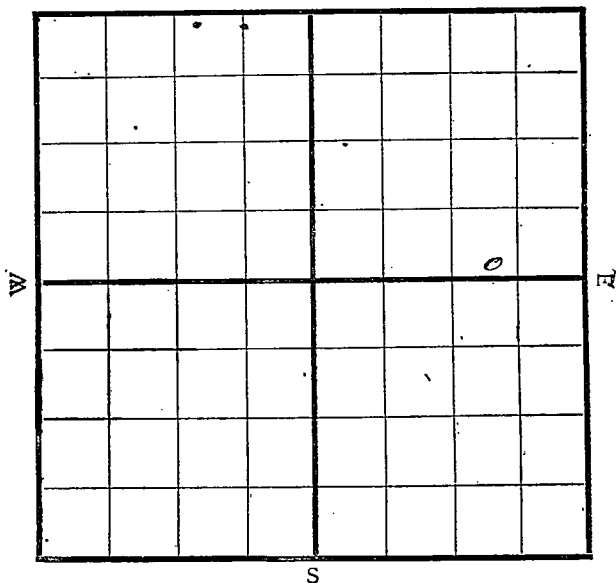

Location -----

Drilling Remarks:

Rig Up -----

Drilling Remarks:

## RECORD

Cased ----- in. ----- ft.

Sand -----

Gas -----

Oil -----

Total Depth -----

## PRODUCTION

1st 24 hrs. Nat. -----

1st 24 hrs. after shot -----

Gas ----- cu. ft.

Dry Hole -----

Abandoned -----



Map No. K 15 Sec. 9 Twp. 26 R. 8  
 Well No. 8 Blankenship  
Cattlemans Oil Company  
50' West of dry hole #4 Contractor

## FIRST REPORT

## SECTION PLAT

-----Ft. from N. Line

200 Ft. from S. Line8 1/2 Ft. from E. Line

-----Ft. from W. Line

|  |  |  |   |
|--|--|--|---|
|  |  |  |   |
|  |  |  | 0 |
|  |  |  |   |
|  |  |  |   |

Location -----

Rig up -----

Drilling and Remarks:

Log 600'

## RECORD

Cased ----- in., ----- ft.

Sand -----

Gas -----

Oil -----

Total Depth -----

## PRODUCTION

1st 24 hrs. Nat. -----

1st 24 hrs. after shot -----

Gas ----- Cu. Ft.

Dry Hole -----

Abandoned -----

Date

JAN 27 1922

191

M. A. BENEAR

Scout

Map No. K15 Sec. 9 Twp. 26 R. 8  
 Well No. 8 B. Lankenship,  
Scott Clemens Oil Company  
 Contractor

## COMPLETED

## SECTION PLAT

\_\_\_\_\_ Ft. from N. Line  
200 Ft. from S. Line  
8/10' Ft. from E. Line  
 \_\_\_\_\_ Ft. from W. Line

|  |  |  |   |
|--|--|--|---|
|  |  |  | 1 |
|  |  |  | 0 |
|  |  |  |   |
|  |  |  |   |

Location \_\_\_\_\_

Rig up \_\_\_\_\_

Drilling and Remarks:

sand 2431-69  
T.D. 2473  
shot 200 lb.  
100 lbs.

## RECORD

Cased \_\_\_\_\_ in., \_\_\_\_\_ ft.

Sand \_\_\_\_\_

Gas \_\_\_\_\_

Oil \_\_\_\_\_

Total Depth \_\_\_\_\_

## PRODUCTION

1st 24 hrs. Nat. \_\_\_\_\_

1st 24 hrs. after shot \_\_\_\_\_

Gas \_\_\_\_\_ Cu. Ft.

Dry Hole \_\_\_\_\_

Abandoned \_\_\_\_\_

Date

MAR 26 1922

M. A. BENEAR

191

Scout