


Map No. _____ Sec. 9 Twp. 26 R. 8
 Well No. 3 Blankenship Farm _____
Cattlemens Oil Company _____

NORTH

WEST

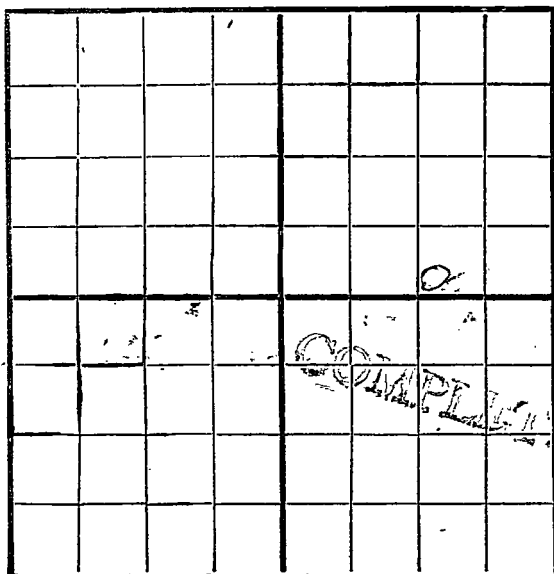

EAST

SOUTH

Location _____

Rig Up _____

Drilling Remarks:

Drilling Remarks:

RECORD

PRODUCTION

Cased _____ in. _____ ft.

1st 24 hrs. Nat. _____

Sand _____

1st 24 hrs. after shot _____

Gas _____


Gas _____ cu. ft.

Oil _____

Dry Hole _____

Total Depth _____

Abandoned _____

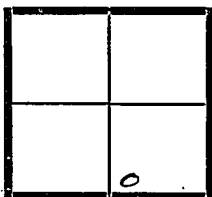Map No. _____ Sec. 9 Twp. 26 R. 8Well No. 3. Blankenship Farm
Cattlemans Oil Co Company_____
Contractor
W.E. Quarter_____
Ft. from N. Line200 Ft. from S. Line1170 Ft. from E. Line_____
Ft. from W. Line

Date

REPORT

1911 Dreg. 1070'1924 SP. 1600' for water1929 SP. 1600'11/18 Land 2439'-2469' 7000' Oil in line17/6 Land 2439'-2469' shot 140 gts
90 Bbl.

Map No. *K15* Sec. *9* Twp. *26* R. *8*Well No. *3* *Blanchardship**Cattlemen's Oil* Company

Contractor

NORTH

WEST

EAST

FIRST REPORT

0

1120 E

SOUTH

2005

Location _____

Rig up _____

Drilling and Remarks:

Timbers

RECORD

Cased _____ in., _____ ft.

Sand _____

Gas _____

Oil _____

Total Depth _____

PRODUCTION

1st 24 hrs. Nat. _____

1st 24 hrs. after shot _____

Gas _____ Cu. Ft.

Dry Hole _____

Abandoned _____


Date

*7/3*191*9**Pyle* Scout

Map No. K15 Sec. 9 Twp. 26 R. 8
 Well No. 3 Blankinship
Cattlemen's Oil Company

Contractor

NORTH

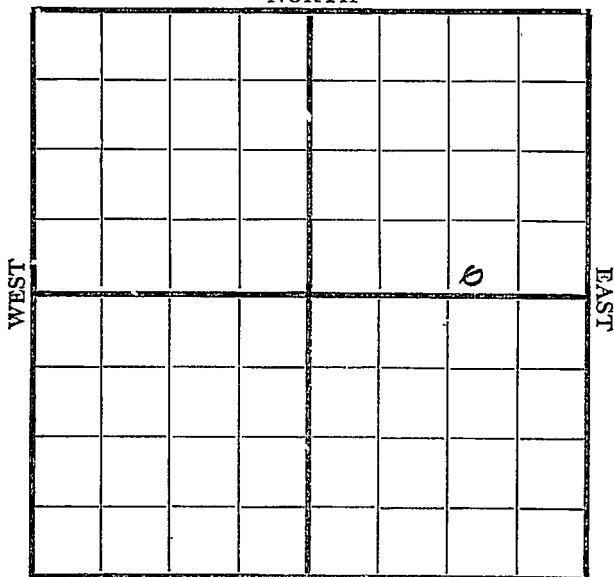

1120 E

SOUTH

200 S

Location _____

Rig up _____

Drilling and Remarks:

Spud

RECORD

Cased _____ in., _____ ft.

Sand _____

Gas _____

Oil _____

Total Depth _____

PRODUCTION

1st 24 hrs. Nat. _____

1st 24 hrs. after shot _____

Gas _____ Cu. Ft.

Dry Hole _____

Abandoned _____

Date

8/7 1919 Pyle Scout

Map No. K15 Sec. 9 Twp. 26 R. 8
 Well No. 3 Blankenship
Cattlemen's Oil Company
 Contractor

SECTION PLAT

-----Ft. from N. Line
200 Ft. from S. Line
1120 Ft. from E. Line
 -----Ft. from W. Line

			P

Location -----

Rig up -----

Drilling and Remarks:

1070

RECORD

Cased ----- in., ----- ft.

Sand -----

Gas -----

Oil -----

Total Depth -----

PRODUCTION

1st 24 hrs. Nat. -----

1st 24 hrs. after shot -----

Gas ----- Cu. Ft.

Dry Hole -----

Abandoned -----

Date

9/4 1919

Pyle

Scout

Map No. K 15 Sec. 9 Twp. 26 R. 8
Well No. 3 Blankinship
Cutlissmen's Oil Company
Contractor

SECTION PLAT

_____ Ft. from N. Line
200 Ft. from S. Line
1120 Ft. from E. Line
_____ Ft. from W. Line

COMPLETED			

Location _____
Rig up _____
Drilling and Remarks:

Shot 140 gts

RECORD

Cased _____ in., _____ ft.
Sand 2439 - 2469
Gas _____
Oil _____
Total Depth _____

PRODUCTION

1st 24 hrs. Nat. _____
1st 24 hrs. after shot 90 bbls
Gas _____ Cu. Ft.
Dry Hole _____
Abandoned _____

Date 12/6 1919 Pyle Scout