


Map No. 1 Sec. 9 Twp. 26 R. 8
 Well No. 9 Blankenship Farm
Brittlemans Company

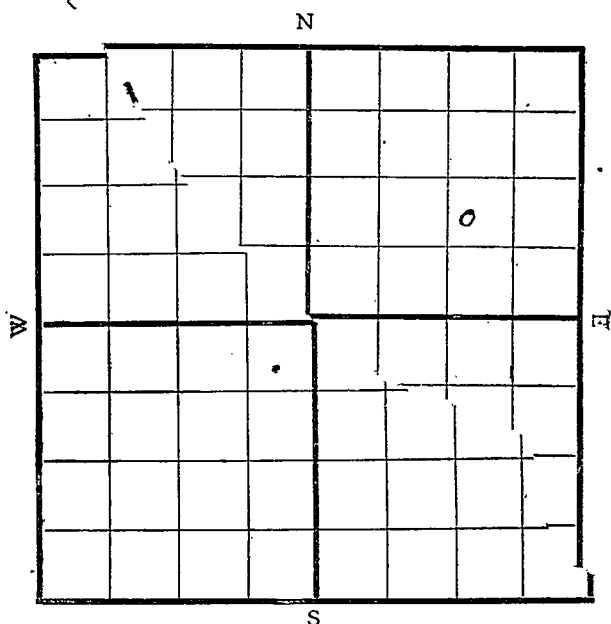

Location -----
 Drilling Remarks:

Rig Up -----
 Drilling Remarks:

RECORD

Cased ----- in. ----- ft.

Sand -----

Gas -----

Oil -----

Total Depth -----

PRODUCTION

1st 24 hrs. Nat. -----

1st 24 hrs. after shot -----

Gas ----- cu. ft.

Dry Hole -----

Abandoned -----

Map No. X Sec. 9 Twp. 26 R. 8Well No. J Blankenship Farm
Gentlemen's Oil Company

NORTH

_____ Ft. from N. Line

980 Ft. from S. Line1120 Ft. from E. Line

_____ Ft. from W. Line

WEST

EAST

SOUTH

Date

REPORT

19221/272/43/30DrigSpud.Sd 2421-2451 T.D. 2493Shot 70 gts 25 bbls.

Map No. K15 Sec. 9 Twp. 26 R. 8
 Well No. 9 Blankenship
Watkins Oil Company

Contractor _____

FIRST REPORT

SECTION PLAT

			2

_____ Ft. from N. Line

980' Ft. from S. Line1120 Ft. from E. Line

_____ Ft. from W. Line

Location _____

Rig up _____

Drilling and Remarks:

Rig

RECORD

Cased _____ in., _____ ft.

Sand _____

Gas _____

Oil _____

Total Depth _____

PRODUCTION

1st 24 hrs. Nat. _____

1st 24 hrs. after shot _____

Gas _____ Cu. Ft.

Dry Hole _____

Abandoned _____

Date

JAN 27 1922

191 _____

M. A. BENEAR Scout

Kansas

Map No. K15 Sec. 9 Twp. 26 R. 8Well No. 9 B. Bankers
Cottlemen Co Company

Contractor

COMPLETED SECTION PLAT

			o

Ft. from N. Line

980

Ft. from S. Line

1120

Ft. from E. Line

Ft. from W. Line

Location

Rig up

Drilling and Remarks:

and 2421-
2431-T.O.
2493
shot 70 yd
25 Hls.

RECORD

Cased _____ in., _____ ft.

Sand _____

Gas _____

Oil _____

Total Depth _____

PRODUCTION

1st 24 hrs. Nat. _____

1st 24 hrs. after shot _____

Gas _____ Cu. Ft.

Dry Hole _____

Abandoned _____

Date

MAR 30 1922

M. A. BENEAR

Scout