


Butler

KANSAS

SECTION 9 TOWNSHIP 26 RANGE 8 E

WELL NO. #5 Dunne

COMPANY T. C. Lillystrand

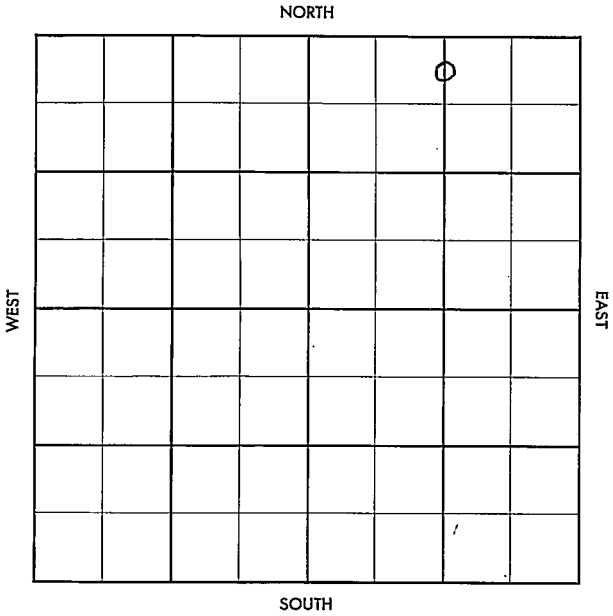

Butler

KANSAS

SEC.	TWP.	R.
9	26	8E

WELL NO.

#5 Dunn

FARM

COMPANY

T.O. Lillystrand

CONTRACTOR

Berentz


Sallyards

Ft. from N. Line

Ft. from S. Line.

Ft. from E. Line

Ft. from W. Line

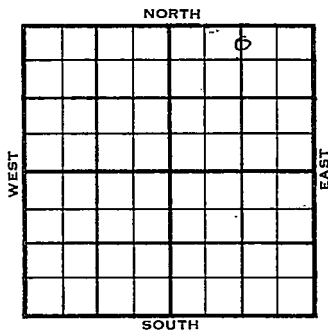C $N\frac{1}{2}$ $N\frac{1}{2}$ NE

1955

ELEVATION

1435 KB

REPORT

11-30

Comm. 11-26-55
Drlg.

12-14

D & A
Bart 2478
TD 2524

ABANDONED

County Butler Elev. _____
Sec. 9 Twp. 26 Rge. 8E
Company T. O. Lillystrand
FarmName Dunn No. 5

TOPS	DEPTH	LOG	DATUM
Anh.			
TP.			
H.			
Tr.			
Dg.			
BL.			
L.			
K.C.			
B.K.C.			
Ce.			
C.			
M.			
M.			
K.			
Mz.			
Ma.			
V.			
S.			
S.			
A.			
R.			
Pe.			
G.			
T.D.			

Loc. in Sec. C N $\frac{1}{2}$ N $\frac{1}{2}$ NE
Geol. _____
Contr. Berentz
Pool Sallyards

NOV 30 '55
FIRST REPORT

Date Comm. 11-26-55
drlg.

Co.
Lse.
No.
Sec.
T.
R.

County Butler Elev. 1435 KB
 Sec. 9 Twp. 46 Rge. 8E
 Company T. O. Lillystrand
 Farm Name Dunn No. 5


TOPS	DEPTH	LOG	DATUM
Anh. <u>/</u>			
Tr. <u>Bark</u>	<u>2478</u>		<u>1043</u>
Dg.			
BL.			
L.			
K.C.			
B.K.C.			
Ce.			
C.			
M.			
M.			
K.			
Mz.			
Mq.			
V.			
S.			
S.			
A.			
R.			
Pe.			
G.			
T.D.	<u>2524</u>		

Loc. in Sec. C N $\frac{1}{2}$ N $\frac{1}{2}$ NE

Geol. _____

Contr. Berentz

Pool Sallyards

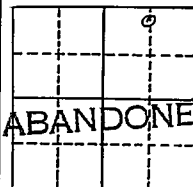

Date Comm. 11-26-55 DEC 14 1955

D & A

Co.

Lse.

No.

Sec.

T.

R.