


Map No. 22 Sec. 19 Twp. 26 R. 5
Well No. Empire Farm _____
Company _____

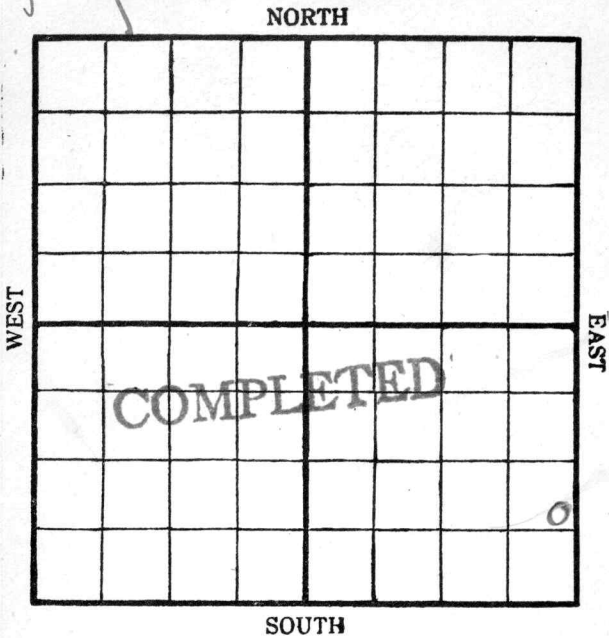

Location _____

Rig Up _____

Drilling Remarks:

Drilling Remarks:

RECORD

PRODUCTION

Cased _____ in. _____ ft.
Sand _____
Gas _____
Oil _____
Total Depth _____

1st 24 hrs. Nat. _____
1st 24 hrs. after shot _____
Gas _____ cu. ft.
Dry Hole _____
Abandoned _____

1004K14
Map No. _____ Sec. 19 Twp. 26 R. 5

Well No. 22 Hoagler

Empire Company

Contractor _____

NORTH

WEST

EAST

SOUTH

FIRST REPORT

Location _____

Rig up ☒

Drilling and Remarks:

810' N

250' W

RECORD

Cased _____ in., _____ ft.

Sand _____

Gas _____

Oil _____

Total Depth _____

PRODUCTION

1st 24 hrs. Nat. _____

1st 24 hrs. after shot _____

Gas _____ Cu. Ft.

Dry Hole _____

Abandoned _____

Date


191

Scout

6/26

Pyle

Map No. _____ Sec. 19 Twp. 26 R. 5
 Well No. 22 Hoogler Farm
Empire Company
 Date Started _____ Ft. from N. S. E. W. line
NORTH

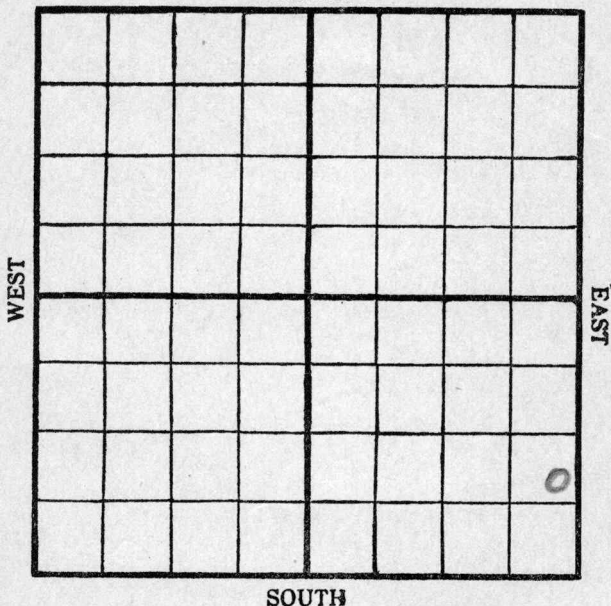

Cased _____ In. _____ Ft.
 Sand _____
 Pay { Gas _____
 { Oil _____
 Total Depth _____

Production Remarks

Condition of Well on this date _____

Rig

Cyle Scout


7/3/18

Map No. _____ Sec. 19 Twp. 26 R. 5Well No. 22 Loogler_____
Empire Company_____
Contractor

NORTH

WEST

EAST

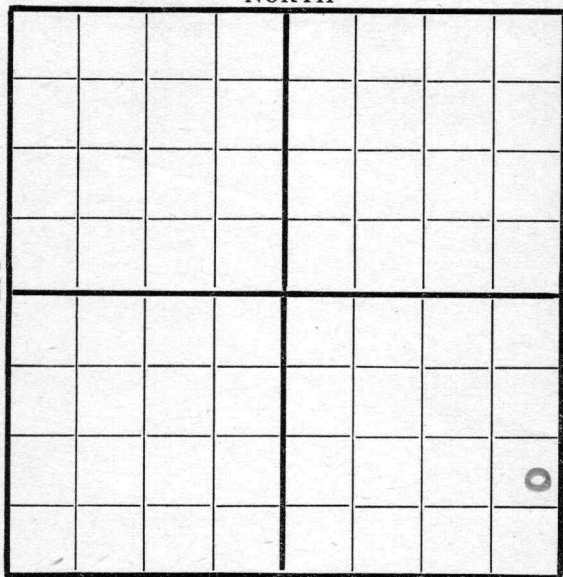

SOUTH

Location _____

Rig up _____

Drilling and Remarks:

125'**RECORD**

Cased _____ in., _____ ft.

Sand _____

Gas _____

Oil _____

Total Depth _____

PRODUCTION

1st 24 hrs. Nat. _____

1st 24 hrs. after shot _____

Gas _____ Cu. Ft.

Dry Hole _____

Abandoned _____

Date

7/10 1918 Gyle Scout

Map No. _____ Sec. 19 Twp. 26 R. 0

Well No. 22 Koster

Company

Contractor

NORTH

WEST

EAST

SOUTH

Location _____

Rig up.....

Drilling and Remarks:

850'

RECORD

Cased _____ in., _____ ft.

Sand_____

Gas

Oil _____

Total Depth_____

PRODUCTION

1st 24 hrs. Nat. -----

1st 24 hrs. after shot-----

Gas.....Cu. Ft.

Dry Hole.....


Abandoned.....

Date _____

191

Scout

Map No. _____ Sec. 19 Twp. 26 R. 5
Well No. 22 Hoagler
Empire Company _____ Contractor _____

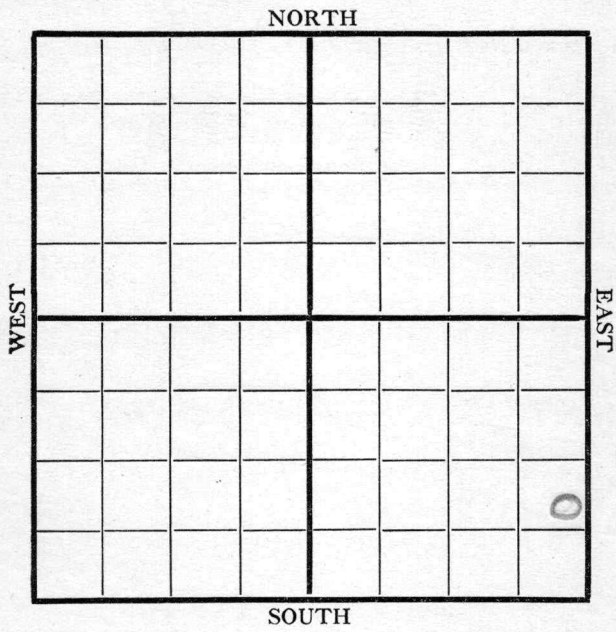

Location _____
Rig up _____
Drilling and Remarks:
fishing tools
@ 900

RECORD

Cased _____ in., _____ ft.
Sand _____
Gas _____
Oil _____
Total Depth _____

PRODUCTION

1st 24 hrs. Nat. _____
1st 24 hrs. after shot _____
Gas _____ Cu. Ft.
Dry Hole _____
Abandoned _____


Date 7/24 1918 *Gyle* Scout

Map No. _____ Sec. 19 Twp. 26 R. 5Well No. 22 Royster_____
Company_____
Contractor

NORTH

WEST

EAST

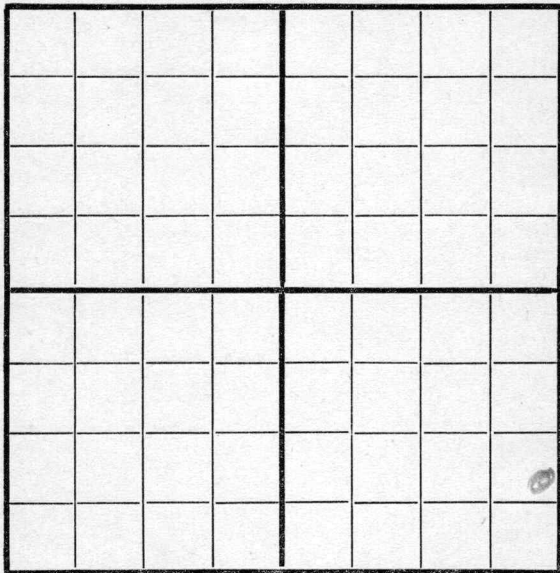

SOUTH

Location 810' ARig up 250' B

Drilling and Remarks:

10 @
1500'

RECORD

Cased _____ in., _____ ft.

Sand _____

Gas _____

Oil _____

Total Depth _____

PRODUCTION

1st 24 hrs. Nat. _____

1st 24 hrs. after shot _____

Gas _____ Cu. Ft.

Dry Hole _____

Abandoned _____

Date


7
31

1918

Oyle

Scout

Map No. _____ Sec. 19 Twp. 26 R. 5
Well No. 22 Hoogler
Empire _____ Company
_____ Contractor

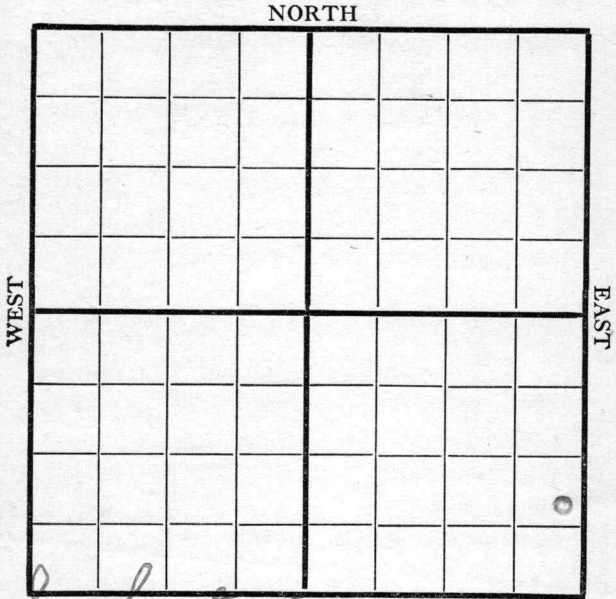


810 S 2506

	RECORD
Location _____	Cased _____ in., _____ ft.
Rig up _____	Sand _____
Drilling and Remarks:	Gas _____
<u>D. 10 @</u>	Oil _____
<u>1605'</u>	Total Depth _____
	PRODUCTION
	1st 24 hrs. Nat. _____
	1st 24 hrs. after shot _____
	Gas _____ Cu. Ft.
	Dry Hole _____
	Abandoned _____

Date 8/13 1918 Cyle Scout

Map No. _____ Sec. 19 Twp. 26 R. 5
Well No. 22 Hoogler
Empire Company
Contractor _____

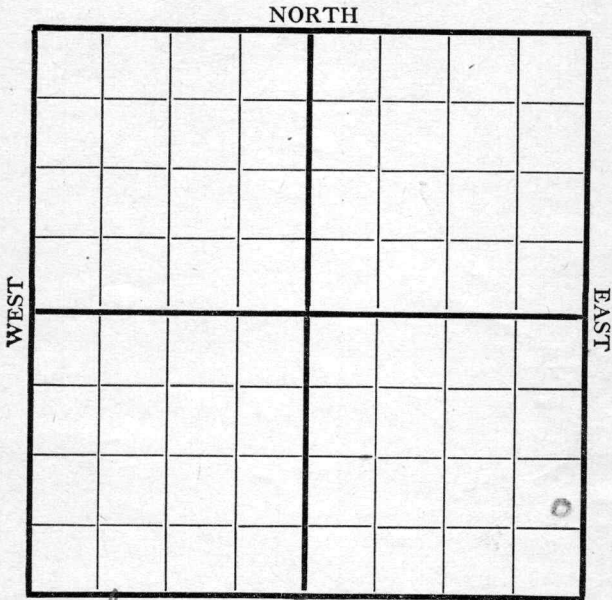

810' 10" - 250'

Location _____

Rig up _____

Drilling and Remarks:

2055'

RECORD

Cased _____ in., _____ ft.

Sand _____

Gas _____

Oil _____

Total Depth _____

PRODUCTION

1st 24 hrs. Nat. _____

1st 24 hrs. after shot _____

Gas _____ Cu. Ft.

Dry Hole _____

Abandoned _____

Date

8/21

1918

Pyle

Scout

Map No. K 14 Sec. 19 Twp. 26^S R. 5^E

Well No. 22 Koogler


Empire Company

Contractor

NORTH

WEST

EAST

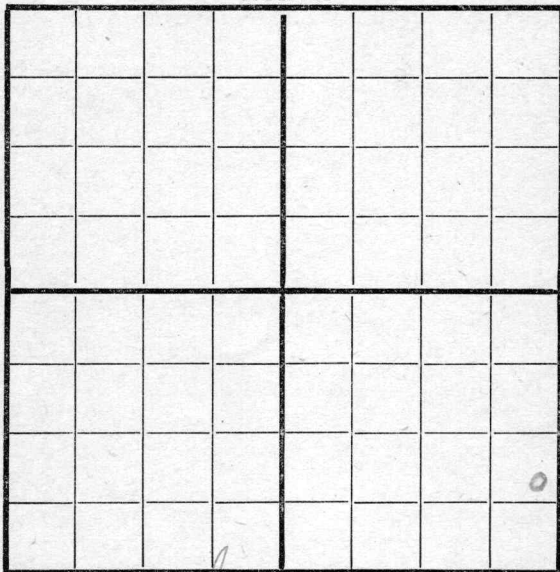

SOUTH

Location 810 N
250 W

Rig up

Drilling and Remarks:

fishing 8 1/4
casing @
2160

RECORD

Cased _____ in., _____ ft.

Sand _____

Gas _____

Oil _____

Total Depth _____

PRODUCTION

1st 24 hrs. Nat. _____

1st 24 hrs. after shot _____

Gas _____ Cu. Ft.

Dry Hole _____

Abandoned _____

Date

8/28 1918

Pyle

Scout

Map No. K14 Sec. 19 Twp. 26^S R. 5^EWell No. 22 KooglerEmpire Company

Contractor

NORTH

WEST

EAST

SOUTH

Location _____

Rig up _____

Drilling and Remarks:

810 ft from A.
 250 ft E

2300'

RECORD

Cased _____ in., _____ ft.

Sand _____

Gas _____

Oil _____

Total Depth _____

PRODUCTION

1st 24 hrs. Nat. _____

1st 24 hrs. after shot _____

Gas _____ Cu. Ft.

Dry Hole _____

Abandoned _____

Date


9/5 1915 Pyle Scout

Map No. K14 Sec. 19 Twp. 26 S 5 E

Well No. 22 Knogler

Empire Company

Contractor

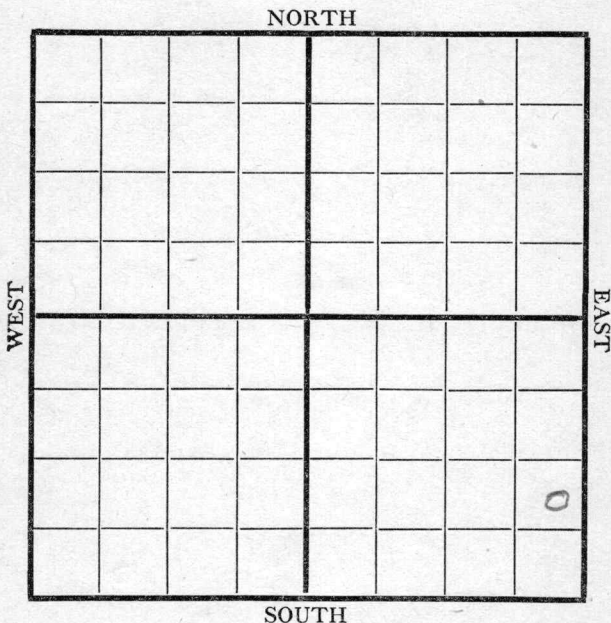

Location 810 S

Rig up 250 E

Drilling and Remarks:

2380'

RECORD

Cased _____ in., _____ ft.

Sand _____

Gas _____

Oil _____

Total Depth _____

PRODUCTION

1st 24 hrs. Nat. _____

1st 24 hrs. after shot _____

Gas _____ Cu. Ft.

Dry Hole _____

Abandoned _____

Date

9/11 1918

Pyle

Scout

Map No. 1514 Sec. 19 Twp. 26 R. 5Well No. 22 Roogles
Empire Company

Contractor

NORTH

WEST

EAST

COMPLETED

SOUTH

Location 810-SRig up 250-E

Drilling and Remarks:

✓

RECORD

Cased _____ in., _____ ft.

Sand 2579-2586

Gas _____

Oil _____

Total Depth _____

PRODUCTION

1st 24 hrs. Nat. 30 bbls

1st 24 hrs. after shot _____

Gas _____ Cu. Ft.

Dry Hole _____

Abandoned _____

Date

9/18 1918 Oyle Scout