


Map No. _____ Sec. 9 Twp. 26 R. 8
 Well No. 1 Hughes Farm
Miller et al Company

NORTH

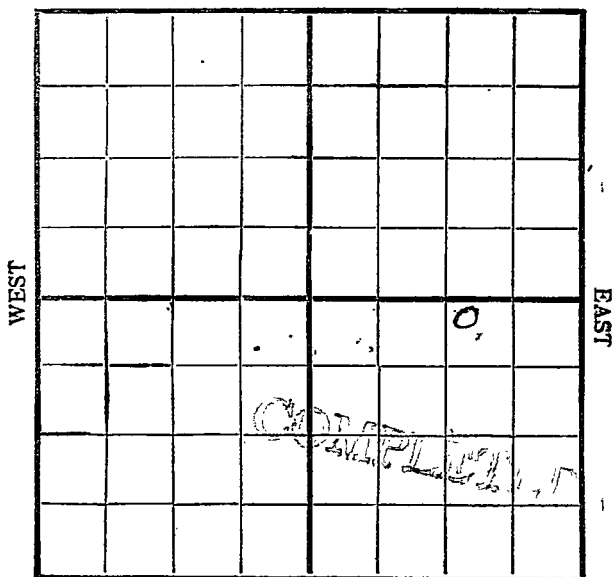

SOUTH

Location _____

Rig Up _____

Drilling Remarks:

Drilling Remarks:

RECORD

Cased _____ in. _____ ft.

Sand _____

Gas _____

Oil _____

Total Depth _____

PRODUCTION

1st 24 hrs. Nat. _____

1st 24 hrs. after shot _____

Gas _____ cu. ft.

Dry Hole _____


Abandoned _____

Map No. _____ Sec. 9 Twp. 26 R. 8Well No. 1 Hughes Farm
Millen et al CompanyContractor SE. Quarter700 Ft. from N. Line

Ft. from S. Line

1170 Ft. from E. Line

Ft. from W. Line

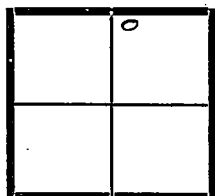

Date

REPORT

10/11 Wdg. 1900'10/24 LD for 8 1/4 215010/29 Wdg. 2310'11/8 Sand 2439-2506' - 4300' (in hole)12/6 Sand 2430-2518 shot 200 lbs
100 bbl.

Map No. K15 Sec. 9 Twp. 26 R. 8Well No. 1 HughesMiller et al Company

Contractor

NORTH

WEST

EAST

FIRST REPORT

1120 E

SOUTH

200 N

Location

Rig up. ☒

Drilling and Remarks:

RECORD

Cased _____ in., _____ ft.

Sand _____

Gas _____

Oil _____

Total Depth _____

PRODUCTION

1st 24 hrs. Nat. _____

1st 24 hrs. after shot _____

Gas _____ Cu. Ft.

Dry Hole _____


Abandoned _____

Date

7/3 1919 Cyph Scout

Map No. K 15 Sec. 9 Twp. 26 R. 8
 Well No. 1 Hughes
Miller et al Company
 Contractor

NORTH

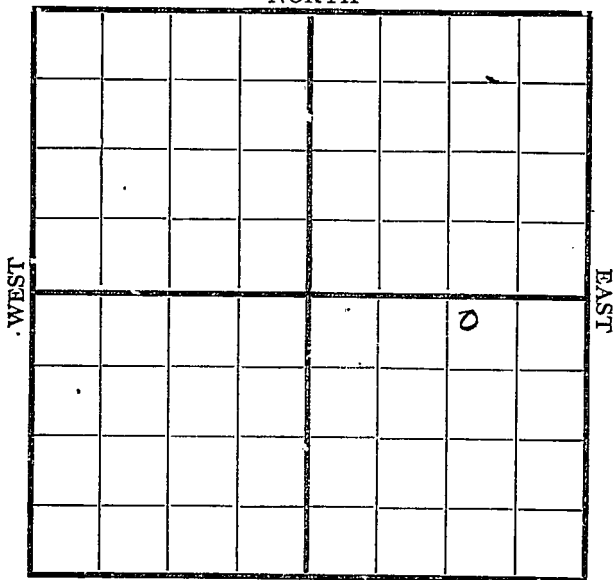

1120 E

SOUTH

200 N

Location _____

Rig up _____

Drilling and Remarks:

Spud

RECORD

Cased _____ in., _____ ft.

Sand _____

Gas _____

Oil _____

Total Depth _____

PRODUCTION

1st 24 hrs. Nat. _____

1st 24 hrs. after shot _____

Gas _____ Cu. Ft.

Dry Hole _____

Abandoned _____

Date

8/7 1919

Pyle Scout

Map No. K15 Sec. 9 Twp. 26 R. 8Well No. 1 HughesMiller et al Company

Contractor

SECTION PLAT

200 Ft. from N. Line

Ft. from S. Line

1120 Ft. from E. Line

Ft. from W. Line

			0
			1

Location

Rig up

Drilling and Remarks:

1900'

RECORD

Cased _____ in., _____ ft.

Sand _____

Gas _____

Oil _____

Total Depth _____

PRODUCTION

1st 24 hrs. Nat. _____

1st 24 hrs. after shot _____

Gas _____ Cu. Ft.

Dry Hole _____

Abandoned _____


Date

9/4 1919 Pyle Scout

Map No. K 15 Sec. 9 Twp. 26 R. 8
Well No. 1 Hughes
Miller et al Company
Contractor

SECTION PLAT

200 Ft. from N. Line
Ft. from S. Line
1120 Ft. from E. Line
Ft. from W. Line

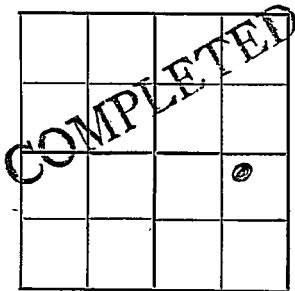

Location _____
Rig up _____
Drilling and Remarks:
Shot 200 qts

RECORD

Cased _____ in., _____ ft.
Sand 2430-2518
Gas _____
Oil _____
Total Depth _____

PRODUCTION

1st 24 hrs. Nat. _____
1st 24 hrs. after shot 100 bbls
Gas _____ Cu. Ft.
Dry Hole _____
Abandoned _____

Date 12/6 1919 Pyle Scout