


Section 20 Township 26 Range 5 E

Well No. # 270 Koogler

Company Cities Service Oil

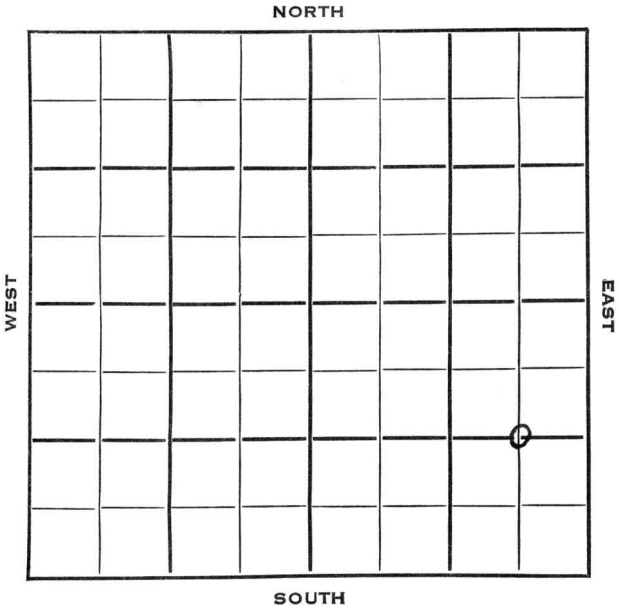

Butler

KANSAS

Sec. 20 Twp. 26 R. 5 E

Well No. # 270 Koogler Farm

Cities Service Oil Company

El Dorado Pool Contractor


 Ft. from N. Line

1320 Ft. from S. Line

660 Ft. from E. Line

 Ft. from W. Line

C E/2 SE

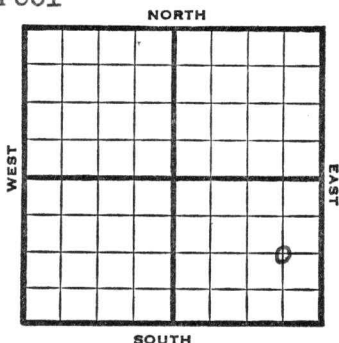

1953


REPORT

5/13

Oil well TD 2597'
8" @ 82 Viola 2527' Simp 2552'
TD 2558 4" @ 2557 DD 2597
10 BO 34 BW 11 hr. 94/2527-51
SP 2553' 1500 A
Comp. 155 BOPD 59 BW

FIRST REPORT
✓
COMPLETED

County **Butler** State **Kansas**
 Sec. **20** (Blk.) **26** (Sur.) **5 E** Map No.
 Operator **Cities Service Oil**
 Well No. **270** Farm **Koogler**
 Elev. Location **C E/2 SE**

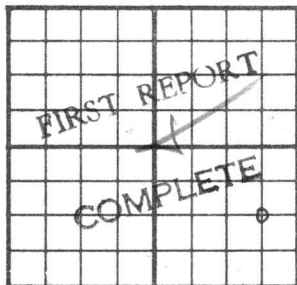

1320 Ft. From **S** Line **SE**
660 Ft. From **E** Line Quarter
 1st. Report **MAY 13 1953**
 Completion **MAY 13 1953**
 Remarks

Spudding Date

Drlg. Data **Oil well TD 2597 Eldorado Pool**

8" @ 82 Viola 2527 Simp. 2552

TD 2558 4" @ 2557 DD 2597 10 bo

34 bw 11 hr. 94/ 2527-51 SP 2553

1500 A Comp. 155 bopd 59 bw