


Section 9 Township 26 Range 8 E

Well No. # 5 Hughes

Company Franco Central

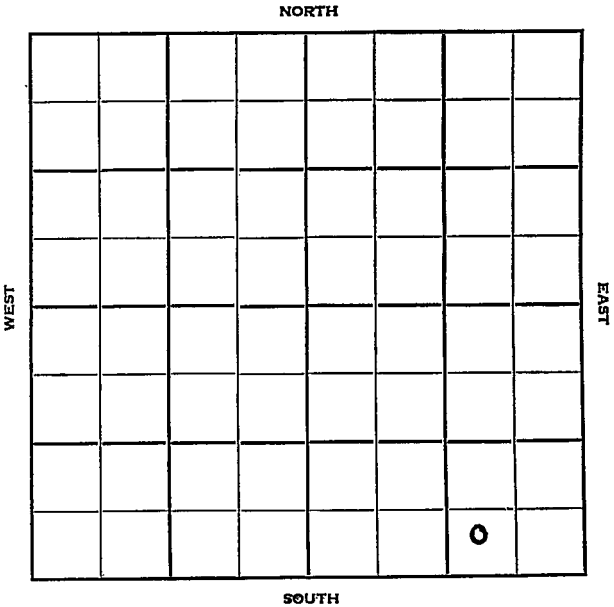

Butler

KANSAS

Sec. 9 Twp. 26 R. 8E

Well No. #5 Hughes Farm

Franco Central Company

Contractor

Ft. from N. Line

440


Ft. from S. Line

990

Ft. from E. Line

Ft. from W. Line

SW SE SE

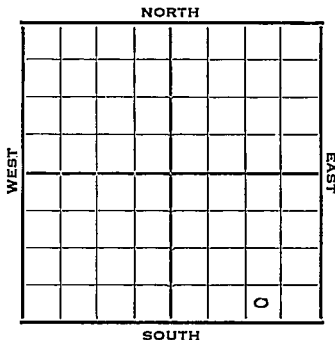

1952

-

R E P O R T

6/11

7/30

Location

Spud 7-19-52 Oil Well TD 2528

10" @ 98 7" @ 2439 TD 2528

B KC 2043


Prue 2280

Bart. 2402

B. Bart 2438

Comp. 10 bopd

COMPLETED

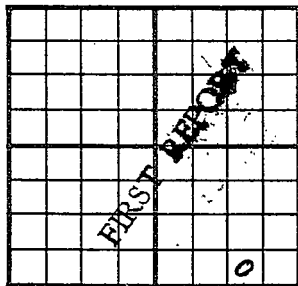County Butler State Kan sasSec. 9 (Blk. 26 (Sur. 8E Map No.Operator Franco CentralWell No. 5 Farm HughesElev. Location SW SE SE440 Ft. From S Line SE990 Ft. From E Line Quarter1st. Report JUN 11 1952

Completion

Remarks

Spudding Date

Drlg. Data


J. G. McGEHEE

County Butler State Kansas
 Sec. 9 (Blk.) 26 (Sur.) 8E Map No.

Operator Franco Central

Well No. 5 Farm Hughes

Elev. Location SW SE SE

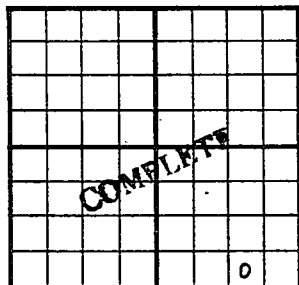

440 Ft. From S Line SE

990 Ft. From E Line Quarter

1st. Report

Completion JUL 30 1952

Remarks

Spudding Date 7-19-52

Drlg. Data Oil well TD 2528

10" @ 98 7" @ 2439 TD 2528

R KC 2043 Prue 2280 Bart. 2402

B. Bart. 2438 Comp. 10 bopd

J. G. McGEHEE