
FORM 51 25M 8-50 WESTERN Butler KANSAS

Section 9 Township 26 Range 8 E

Well No. # 6 Hughes

Company Franco Central

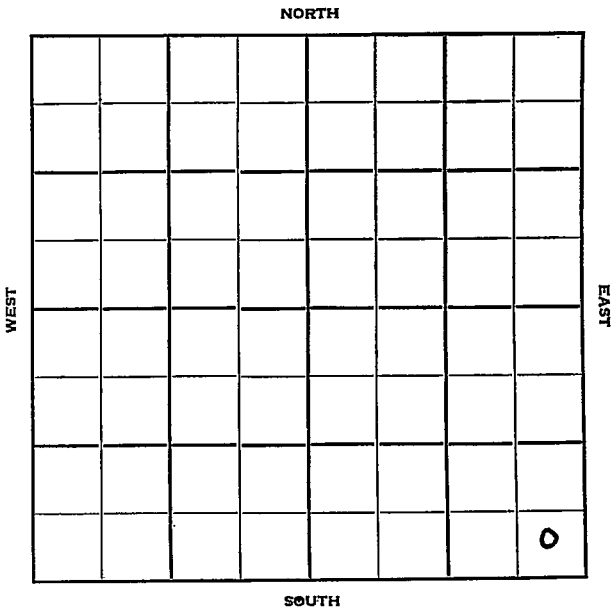

FORM 252-B
10M 8-51 TPCO. Butler KANSAS

Sec. 9 Twp. 26 R. 8E

Well No. #6 Hughes Farm

Franco Central Company

Contractor


Ft. from N. Line

440 Ft. from S. Line

330 Ft. from E. Line

Ft. from W. Line

SE SE SE

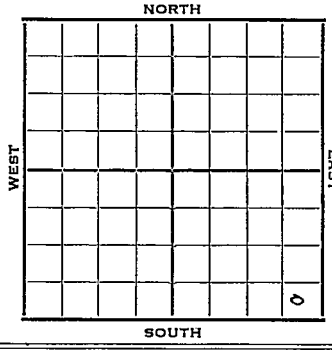

1952 Elev. 1402 REPORT

6/11 **Location**

8/6 Spud 7-25-52
Oil Well TD 2510
8" @ 101
Lans. 1472 KC 1780
BKC 2005 Prue 2246
Bart 2406
TD 2510 5" @ 2406
CO to 2485
109 qt/24H-85 Comp. 10 bopd

COMPLETED

FORM 275 FOR SALE BY KANSAS BLUE PRINT CO


County Butler State Kansas

Sec. 9 (Blk. Twp.) 26 (Sur. Rge.) 8E Map No.

Operator Franco Central

Well No. 6 Farm Hughes

Elev. Location SE SE SE

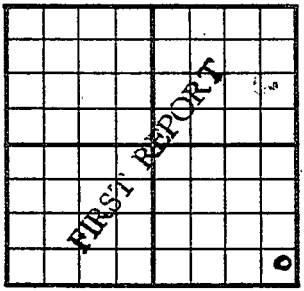

440 Ft. From S Line SE

330 Ft. From E Line Quarter

1st. Report JUN 11 1952

Completion

Remarks

Spudding Date

Drlg. Data

J. G. McGEHEE

FORM 275 FOR SALE BY KANSAS BLUE PRINT CO.


County Butler State Kansas

Sec. 9 (Blk. Twp.) 26 (Sur. Rge.) 8E Map No.

Operator Franco Central

Well No. 6 Farm Hughes

Elev. 1402 Location SE SE SE

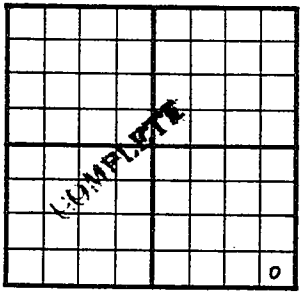

440 Ft. From S Line SE

330 Ft. From E Line Quarter

1st. Report

Completion AUG 6 1952

Remarks

Spudding Date 7-25-52

Drlg. Data Oil well TD 2510

8" @ 101 Lans. 1472 KC 1780

B KC 2005 Prue 2246 Bart. 2406

TD 2510 5" @ 2406 CO to 2485

109 qt/ 2411-85 Comp. 10 bopd

J. G. McGEHEE