

Section 33 Township 26 Range 13 EWell No. # 1 WoodsideCompany D. R. Lauck

|  |  |  |   |  |  |  |  |
|--|--|--|---|--|--|--|--|
|  |  |  |   |  |  |  |  |
|  |  |  |   |  |  |  |  |
|  |  |  |   |  |  |  |  |
|  |  |  | 0 |  |  |  |  |
|  |  |  |   |  |  |  |  |
|  |  |  |   |  |  |  |  |
|  |  |  |   |  |  |  |  |
|  |  |  |   |  |  |  |  |

NORTH

WEST

EAST

SOUTH

Greenwood

KANSAS

|      |      |        |
|------|------|--------|
| SEC. | TWP. | R.     |
| 33   | 26   | 13 E ✓ |

WELL NO.

# 1 Woodside

FARM

COMPANY

D. R. Lauck

CONTRACTOR

Schafges &amp; Kimsey

Wildcat

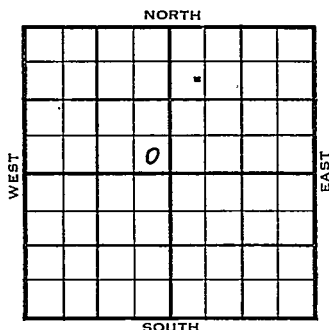
\_\_\_\_\_ Ft. from N. Line

330 \_\_\_\_\_ Ft. from S. Line

330 \_\_\_\_\_ Ft. from E. Line

\_\_\_\_\_ Ft. from W. Line

SE SE NW



1954

ELEVATION

REPORT

4/14

Spud 4-6-54

10" @ 65

Drlg. 860'

5/5

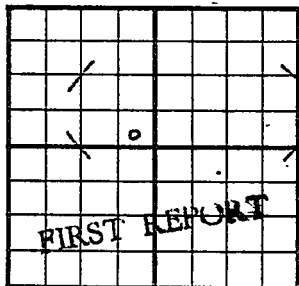
Spud 4-6-54 D &amp; A TD 1847

10" @ 65 8" @ 1035 Miss 1485

7" @ 1621 Arb. 1795 TD 1847

D &amp; A

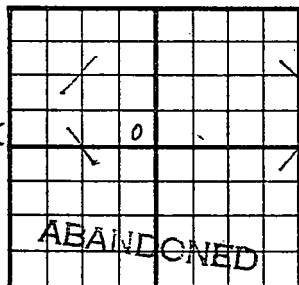
**ABANDONED**

County Greenwood State KansasSec. 33 (Blk. Twp.) 26 (Sur. Rge.) 13E Map No.Operator D. R. LauckWell No. 1 Farm WoodsideElev. Location SE SE NW330 Ft. From S Line NW330 Ft. From E Line Quarter1st. Report APR 14 1954

Completion

Remarks

Schafges & Kimsey - ContrSpudding Date 4-6-54Drlg. Data Wildcat10" @ 65 drlg. 860J. G. McGEHEE

County Greenwood State KansasSec. 33 (Blk.  
Twp.) 26 (Sur.  
Rge.) 13E Map No.Operator D. R. LauckWell No. 1 Farm WoodsideElev. Location SE SE NW330 Ft. From S Line NW330 Ft. From E Line QuarterIst. ReportCompletion MAY 5 1954Remarks WildcatSchafges & Kimsey - Contr.Spudding Date 4-6-54Drlg. Data D & A TD 184710" @ 65 8" @ 1035 Miss. 14857" @ 1621 Arb. 1795 TD 1847D & A