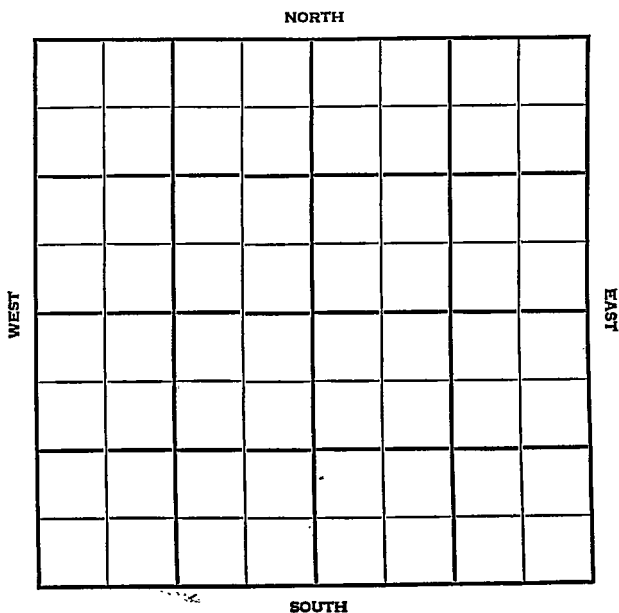


Greenwood

Section 10 Township 26 Range 8EWell No. #37 F. H. Hill C & DCompany Tidewater

Greenwood

KANSAS

SEC.	TWP.	R.
10	26	8 E

WELL NO.

37 F. H. Hull C & D

FARM

COMPANY

Tidewater

CONTRACTOR

White & Ellis

Sallyards

648

Ft. from N. Line


Ft. from S. Line

Ft. from E. Line

200

Ft. from W. Line

NW NW NW

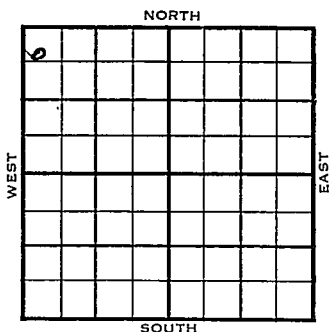

	ELEVATION	REPORT
1955	1419'	

6/15

8" @ 89 w/50

COMPLETED

7/13

5 1/2" @ 2559/100 CO 106/2418-36 frac

Comp. 40 bopd 10 bw

Tops: Depth Datum

H. Cattle 2396 1020

Tr. Bart 2452 1033

M. 2553 1134

TD. 2559

County Greenwood ✓ Elev. _____
 Sec. 10 Twp. 26 Rge. 8E
 Company Tidewater
 Farm Name F. H. Hull C & D No. 37

TOPS	DEPTH	LOG	DATUM
Anh.			
Tr.			
H.			
Tr.			
Dg.			
Bl.			
L.			
K.C.			
B.K.C.			
Ce.			
C.			
M.			
M.			
K.			
Mz.			
Me.			
V.			
S.			
S.			
A.			
R.			
Pe.			
G.			
T.D.			

Loc. in Sec. _____

NW NW NW

648' NL

200' WL

Geol. _____

Contr. _____

White & Ellis

Pool _____

Sallyards

0		

REPORT

JUN 15 1955

Date Comm. _____

8th @ 89/50

County Greenwood Elev. 1419
 Sec. 10 Twp. 26 Rge. 8E
 Company Tidewater
 Farm Name F. H. Hull C & D No. 37

TOPS	DEPTH	LOG	DATUM	Loc. in Sec.
Anh.				NW NW NW
Tr. <u>Cattle</u>	<u>2396</u>		<u>1020</u>	648' NL
Tr. <u>Bart</u>	<u>2452</u>		<u>1033</u>	200' WL
Dg.				
Bl.				
L.				Geol.
K.C.				Contr.
B.K.C.				White & Ellis
Ce.				Pool
C.				Sallyards
M.	<u>2553</u>		<u>1134</u>	
M.				
K.				
Mz.				
Mq.				
V.				
S.				
S.				
A.				
R.				
PE.				
G.				
T.D.	<u>2559</u>			

Date Comm. JUL 13 1955
 8" @ 89/50 5 $\frac{1}{2}$ " @ 2559/100 CO
 106/ 2418-36 frac Comp. 40 bopd 10 b/w