


Map No. _____ Sec. 10 Twp. 26 R. 8

Well No. 20 Hull Farm

Liquid Oil & St. Souther Company

N

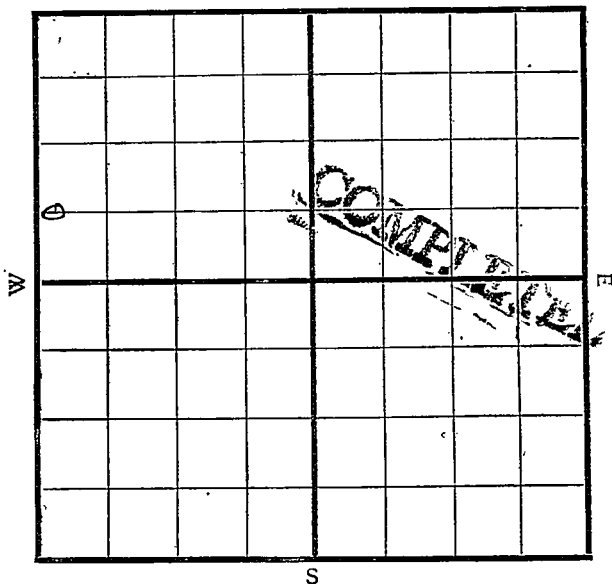

Location _____

Drilling Remarks:

Rig Up -----

Drilling Remarks:

RECORD

Cased ----- in.-----ft.

Sand -----

Gas _____

Oil _____

Total Depth-----

PRODUCTION

1st 24 hrs. Nat.-----

1st 24 hrs. after shot-----

Gas _____ cu. ft.

Dry Hole -----

Abandoned -----

Map No. _____ Sec. 10 Twp. 26 R. 8

Well No. 20 Huel Farm


Well No: 1 Farm 1
Lidal Oil & Gr. Sales Company

_____Ft. from N. Line

660 Ft. from S. Line

_____Ft. from E. Line

200 Ft. from W. Line

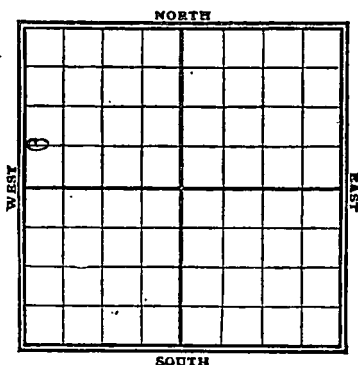

Date 1/9/20

REPORT

 $\frac{1}{2}$

REPO
Spedding

16


24

Dray. 1000'

21,

LD 1000

DL 2300'

12

dry abandoned $\approx 600'$

COMPLETED

Map No. K15 Sec. 10 Twp. 26 R. 8Well No. 20 HullTidal Oil & Southern Company

Contractor

SECTION PLAT

Ft. from N. Line

660 Ft. from S. Line

Ft. from E. Line

200 Ft. from W. Line

0			

FIRST REPORT

Location

Rig up

Drilling and Remarks:

Spud

RECORD

Cased _____ in., _____ ft.

Sand _____

Gas _____

Oil _____

Total Depth _____

PRODUCTION

1st 24 hrs. Nat. _____

1st 24 hrs. after shot _____

Gas _____ Cu. Ft.

Dry Hole _____

Abandoned _____

Date

1/3 1919

Pyle

Scout

Map No. K 15 Sec. 10 Twp. 26 R. 8Well No. 20 Hull
Tidal & Southern Company


Contractor

SECTION PLAT

Ft. from N. Line

660 Ft. from S. Line

Ft. from E. Line

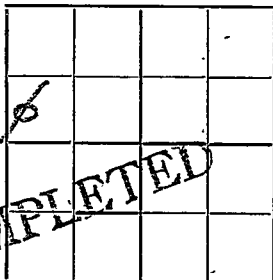200 Ft. from W. Line

Location

Rig up

Drilling and Remarks:

RECORD

Cased _____ in., _____ ft.

Sand _____

Gas _____

Oil _____

Total Depth _____

PRODUCTION

1st 24 hrs. Nat. _____

1st 24 hrs. after shot _____

Gas _____ Cu. Ft.

Dry Hole 2600

Abandoned _____

Date

2/12 1940

Pyle

Scout