
DX 78-1

Butler KANSAS

Section 19 Township 26 Range 5 E

Well No. # 171 Koogler

Company Cities Service

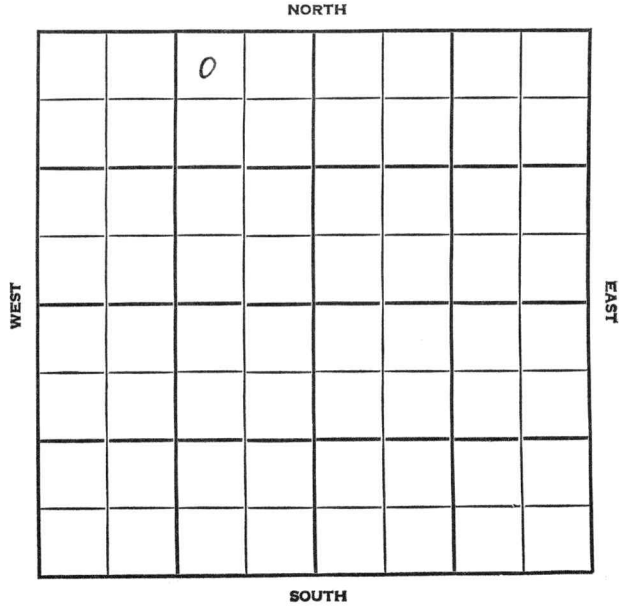

Butler KANSAS

SEC.	TWP.	R.
19	26	5E

WELL NO.

171 Koogler FARM

COMPANY

Cities Service

CONTRACTOR


El Dorado Pool

325 Ft. from N. Line

Ft. from S. Line

990 Ft. from E. Line

Ft. from W. Line

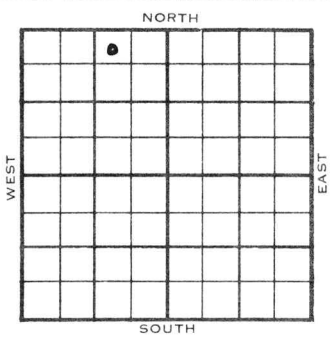

NW NE NW

	ELEVATION	
1954	1329'	REPORT

8/4

Oil Well
TD 2585'
8" @ 104'
Lans 1810', KC 2028', B KC 2188',
Viola 2528', Simp. 2550'
TD 2585'
7" @ 2552'
CO to 2585'
30 qts. 2563-83,
CO to 2583
Comp. 90 bopd 93 bw

FIRST REPORT

COMPLETED

DX-78

FORM 275 FOR SALE BY KANSAS BLUE PRINT CO.


County Butler State Kansas

Sec. 19 (Blk. Twp.) 26 (Sur. Rge.) 5E Map No.

Operator Cities Service

Well No. 171 Farm Koogler

Elev. 1329 Location NW NE NW

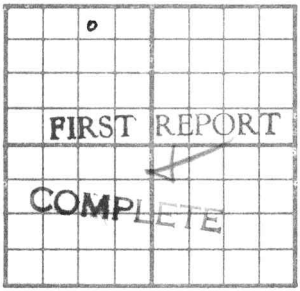

325 Ft. From N Line NW

990 Ft. From E Line Quarter

1st. Report AUG 4 1954

Completion AUG 4 1954

Remarks ElDorado Pool

Spudding Date

Drlg. Data Oil well TD 2585

8" @ 104 Lans. 1810 KC 2028

B KC 2188 Viola 2528 Simp. 2550

TD 2585 7" @ 2552 CO to 2585

30 qt/ 2563-83 CO to 2583

Comp. 90 bopd 93 bw

J. G. McGEHEE