


Section 28 Township 26 Range 4 EWell No. # 1 RedingtonCompany Tom Allan et al

NORTH

WEST

EAST

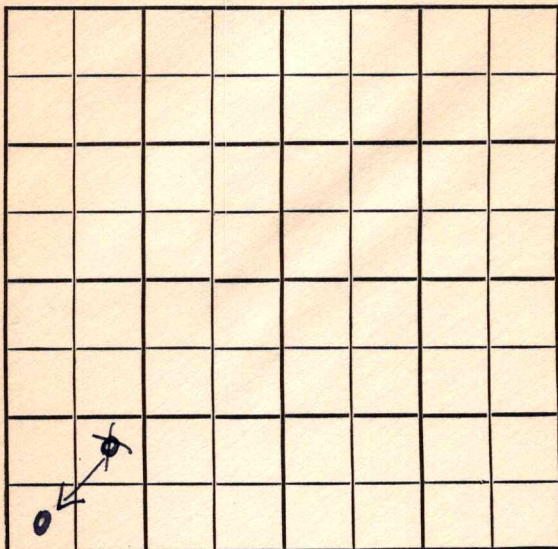

SOUTH

SEC.	TWP.	R.
28	26	4 E

WELL NO.

1 Redington

FARM

COMPANY

Tom Allen et al

CONTRACTOR


Co. tools

Wildcat

Ft. from N. Line

~~990~~ 330 Ft. from S. Line

Ft. from E. Line

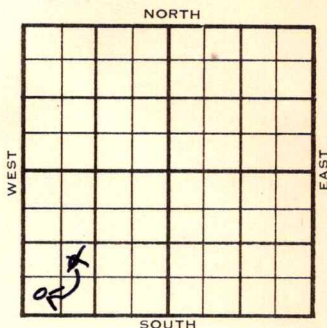~~990~~ 330 Ft. from W. Line

NE SW SW
SW SW SW

ELEVATION

REPORT

1954

1256'

7/14

Spud 7-12-54

7/28

Spud 7-12-54

D&A

TD 2865'

8" @ 103'

Lans 1792', KC 2134', B KC 2380',
Miss 2613', Kh. 2769', Meisner 2832',
Viola 2839', Simp. 2851'

TD 2865'

D&A

ABANDONED

County **Butler** State **Kansas**
Sec. **28** (Blk.) **26** (Sur.) **4E** Map No.

Operator **Tom Allan et al.**

Well No. **1** Farm **Redington**

Elev. Location **NE SW SW**

FIRST REPORT

See correct

o

990 Ft. From **S** Line **SW**

990 Ft. From **W** Line Quarter

1st. Report **JUL 14 1954**

Completion

Remarks

Co. tools

Spudding Date **7-12-54**

Wildcat

Drlg. Data

Kansas

Map No. _____ Sec. 28 Twp. 26 R. 4EWell No. 1 RedingtonTom Allen et al.


Company

CORRECTION

Contractor

SW SW SW

SECTION PLAT

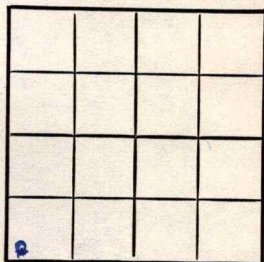

_____ Ft. from N. Line

330

_____ Ft. from S. Line

_____ Ft. from E. Line

330

_____ Ft. from W. Line

Butler County

Location _____

Rig up _____

Drilling and Remarks:

Reported

NE SW SW

RECORD

Cased _____ in., _____ ft.

Sand _____

Gas _____

Oil _____

Total Depth _____

PRODUCTION

1st 24 hrs. Nat. _____

1st 24 hrs. after shot _____

Gas _____ Cu. Ft.


Dry Hole _____

Abandoned _____

Date

JUL 21 195419J. G. McGEHEE

Scout

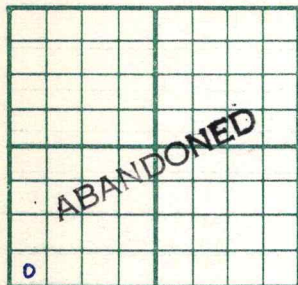County Butler State KansasSec. 28 (Blk.
Twp.) 26 (Sur.
Rge.) 4E Map No.Operator Tom Allan et al.Well No. 1 Farm RedingtonElev. 1256 Location SW SW SW330 Ft. From S Line SW330 Ft. From W Line Quarter

1st. Report

Completion JUL 28 1954Remarks WildcatCo. toolsSpudding Date 7-12-54Drlg. Data D & A TD 28658" @ 103 Lans. 1792 KC 2134B KC 2380 Miss. 2613 Kh. 2769Meisner 2832 Viola 2839 Simp. 2851TD 2865D & A