


Section 28 Township 26 Range 4E
Well No. #1 Mannion
Company Rex & Morris

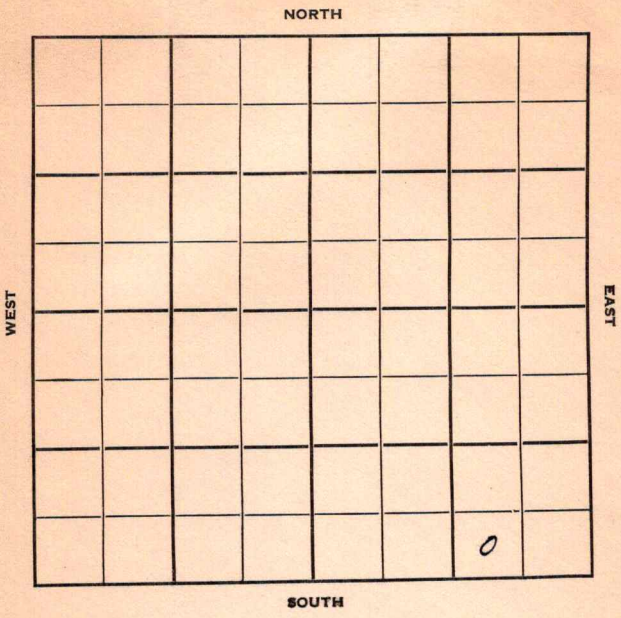

Sec. 28 Twp. 26 R. 4-E

Well No. #1 Mannion Farm

Rex & Morris Company

Wildcat Contractor


Ft. from N. Line

330 Ft. from S. Line

990 Ft. from E. Line

Ft. from W. Line

SW SE SE

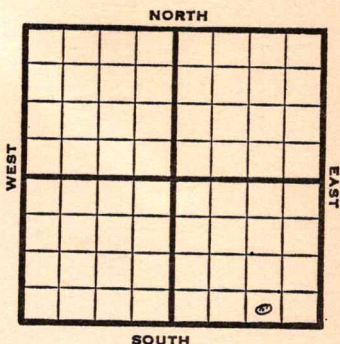

1950

Elev 1282'

REPORT

3/22

Location

5/3

TD 2900'

15 1/2" @ 190'

13" @ 875'

10" @ 1365'

8" @ 1813'

KC 2055'

7" @ 2353'

Miss 2636'

D&A

Aband.

ABANDONED

Kansas

Map No. _____ Sec. 28 Twp. 26 R. 4EWell No. 1 MannionRex & Morris Company

Contractor

SW SE SE

SECTION PLAT

			0

_____ Ft. from N. Line

330 Ft. from S. Line990 Ft. from E. Line

_____ Ft. from W. Line

Butler County

Location X

Rig up _____

Drilling and Remarks:

RECORD

Cased _____ in., _____ ft.

Sand _____

Gas _____

Oil _____

Total Depth _____

PRODUCTION

1st 24 hrs. Nat. _____

1st 24 hrs. after shot _____

Gas _____ Cu. Ft.

Dry Hole _____

Abandoned _____

Date

MAR 22 1950

19

J. E. TYRA Scout

Kansas

Wildcat

Map No. _____ Sec. 28 Twp. 26 R. 4EWell No. 1 MannionRex & Morris Company

Contractor

SW SE SE


SECTION PLAT

E. 1282

_____ Ft. from N. Line

330 Ft. from S. Line990 Ft. from E. Line

_____ Ft. from W. Line

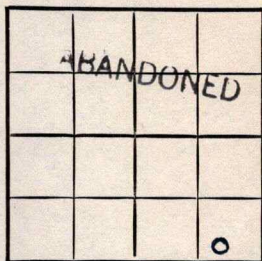

Butler County

Location _____

Rig up _____

Drilling and Remarks:

15 1/2" @ 19013" @ 87510" @ 13658" @ 1813A.C. 20557" @ 2353

RECORD

Cased _____ in., _____ ft.

Sand _____

Gas _____

Oil _____

Total Depth 2900

PRODUCTION

1st 24 hrs. Nat. _____

1st 24 hrs. after shot _____

Gas _____ Cu. Ft.

Dry Hole _____

Abandoned _____

Date

min 2636 D & A

MAY 3

1950

19

J. E. TYRA

Scout