

Map No. _____ Sec. 3 Twp. 26 R. 8

Well No. 9. Full Farm _____

Tidal Oil Company _____

NORTH

SOUTH

WEST

EAST

COMPLETED

o

Location _____

Rig Up _____

Drilling Remarks:

Drilling Remarks:

RECORD

PRODUCTION

Cased _____ in. _____ ft.

1st 24 hrs. Nat. _____

Sand _____

1st 24 hrs. after shot _____

Gas _____

Gas _____ cu. ft.

Oil _____

Dry Hole _____

Total Depth _____

Abandoned _____

Map No. 117 Sec. 13 Twp. 26 R. 8

Well No. 9 Bull

Tridul Oil _____ Company

Contractor

NORTH

WEST

EAST

SOUTH

Location _____

Rig up_____

Drilling and Remarks:

RECORD

Cased _____ in., _____ ft.

Sand

Gas -----

Oil _____

Total Depth.....

PRODUCTION

1st 24 hrs. Nat. -----

1st 24 hrs. after shot-----

Gas.....Cu. Ft.


Dry Hole.....

Abandoned.....

Date _____

7/15 1918 Oyle Scout

Map No. _____ Sec. 3 Twp. 26 R. 8
Well No. 9 Hull
Tidal Oil Company
Contractor _____

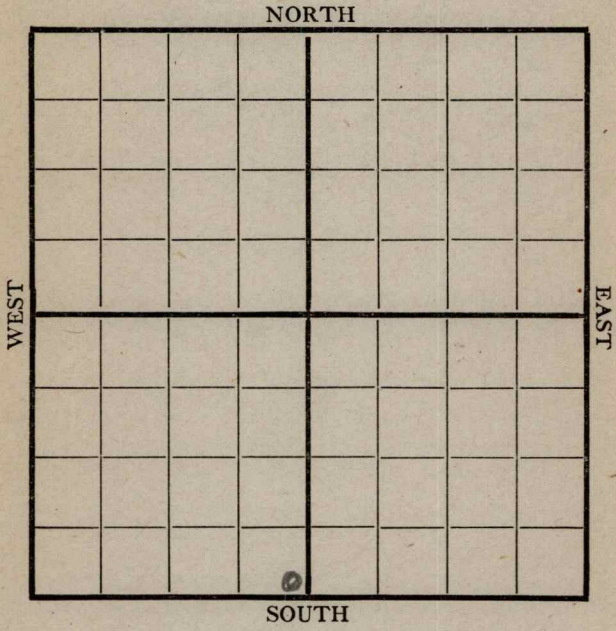

	RECORD
Location _____	Cased _____ in., _____ ft.
Rig up ☒	Sand _____
Drilling and Remarks:	Gas _____
	Oil _____
	Total Depth _____
	=====
	PRODUCTION
	1st 24 hrs. Nat. _____
	1st 24 hrs. after shot _____
	Gas _____ Cu. Ft.
	Dry Hole _____
	Abandoned _____

Date 7/27 1918 C. L. G. L. Scout

Map No. _____ Sec. 3 Twp. 26 R. 8Well No. 9 HullTidal Oil Company

Contractor _____

NORTH

WEST

EAST

SOUTH

RECORD

Location _____

Cased _____ in., _____ ft.

Sand _____

Gas _____

Oil _____

Total Depth _____

PRODUCTION

1st 24 hrs. Nat. _____

1st 24 hrs. after shot _____

Gas _____ Cu. Ft.

Dry Hole _____

Abandoned _____

Drilling and Remarks:

250' ✓
 250' ✓

Date

8/3

191

8

Cyle

Scout

Map No. _____ Sec. 3 Twp. 26 R. 8Well No. 9 HullTidal Oil CompanyHutch & Gregory Contractor

NORTH

WEST

EAST

SOUTH

Location _____

Rig up _____

Drilling and Remarks:

Spudding

RECORD

Cased _____ in., _____ ft.

Sand _____

Gas _____

Oil _____

Total Depth _____

PRODUCTION

1st 24 hrs. Nat. _____

1st 24 hrs. after shot _____

Gas _____ Cu. Ft.

Dry Hole _____

Abandoned _____

Date

8/8 1918Oyle Scout


Map No. _____ Sec. 3 Twp. 26 R. 8Well No. 9 Hull
Tidal Oil Company _____

Contractor _____

NORTH

WEST

EAST

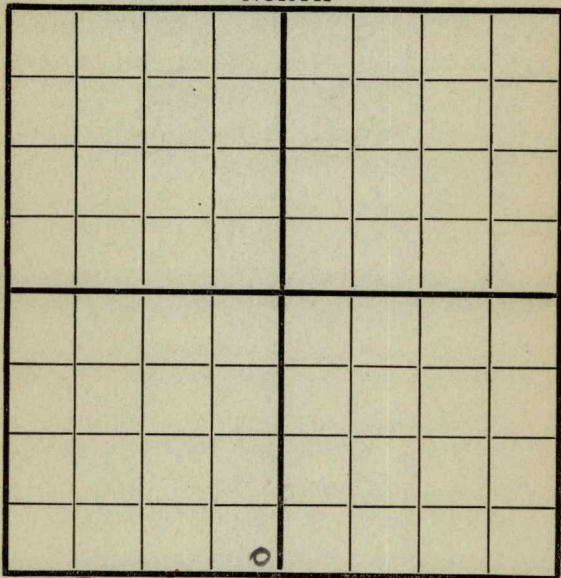

SOUTH

250' x 8'

RECORD

Location _____

Cased _____ in., _____ ft.

Rig up _____

Sand _____

Drilling and Remarks:

Gas _____

Oil _____

Total Depth _____

PRODUCTION

1st 24 hrs. Nat. _____

1st 24 hrs. after shot _____

Gas _____ Cu. Ft.

Dry Hole _____

Abandoned _____

Date

8/17 1918 Pyle Scout


Map No. _____ Sec. 3 Twp. 26 R. 8Well No. 9 HullTidal Oil Company

Contractor _____

NORTH

WEST

EAST

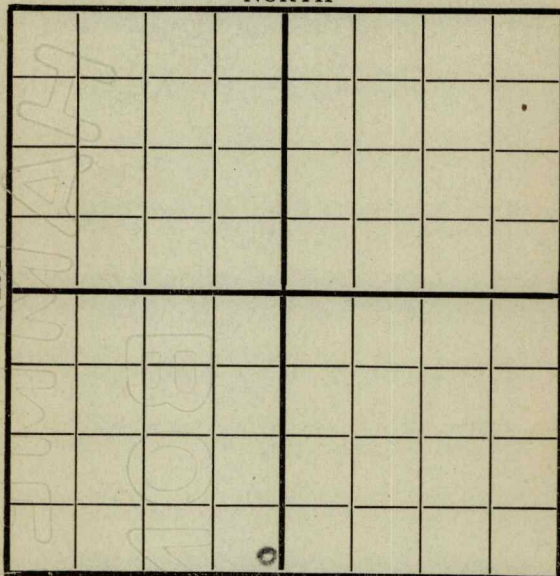

SOUTH

250' ASL

Location _____

Rig up _____

Drilling and Remarks:

450'

RECORD

Cased _____ in., _____ ft.

Sand _____

Gas _____

Oil _____

Total Depth _____

PRODUCTION

1st 24 hrs. Nat. _____

1st 24 hrs. after shot _____

Gas _____ Cu. Ft.

Dry Hole _____

Abandoned _____

Date

8/24 1918

Pyle

Scout

Map No. K15 Sec. 3 Twp. 26^S R. 8^E

Well No. 9 Kull
Tidal Oil Company

Company

Contractor

NORTH

WEST

EAST

SOUTH

Location

Rig up.

Drilling and Remarks:

RECORD

Cased _____ in., _____ ft.

Sand

Gas

Oil

Total Depth

PRODUCTION

1st 24 hrs. Nat.

1st 24 hrs. after shot

Gas _____ Cu. Ft. _____

Dry Hole.

Abandoned

Date _____

191

Pyle

Scout


Map No. K15 Sec. 3 Twp. 26 ^S 8 ^EWell No. 9 Hull
Tidal Oil Company

Contractor

NORTH

WEST

EAST

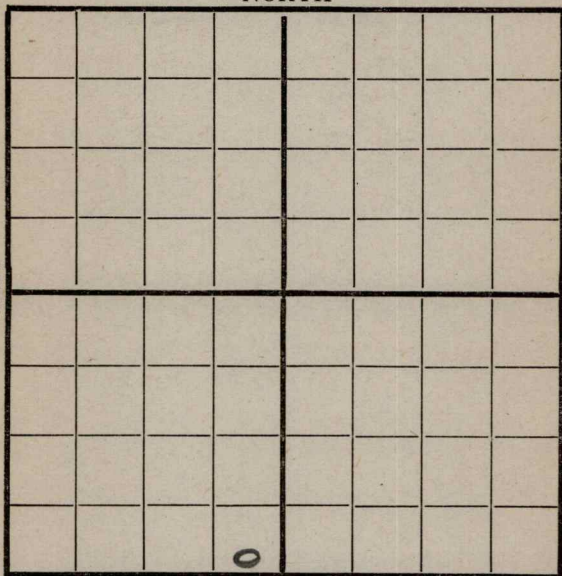

SOUTH

Location _____

Rig up _____

Drilling and Remarks:

250 from STE12 1/2 @ 965

RECORD

Cased _____ in., _____ ft.

Sand _____

Gas _____

Oil _____

Total Depth _____

PRODUCTION

1st 24 hrs. Nat. _____

1st 24 hrs. after shot _____

Gas _____ Cu. Ft.

Dry Hole _____

Abandoned _____

Date


9/61915

Pyle

Scout

Map No. 1515 Sec. 3 Twp. 26 R. 8Well No. 9 Hull
Tidal Oil Company

Contractor

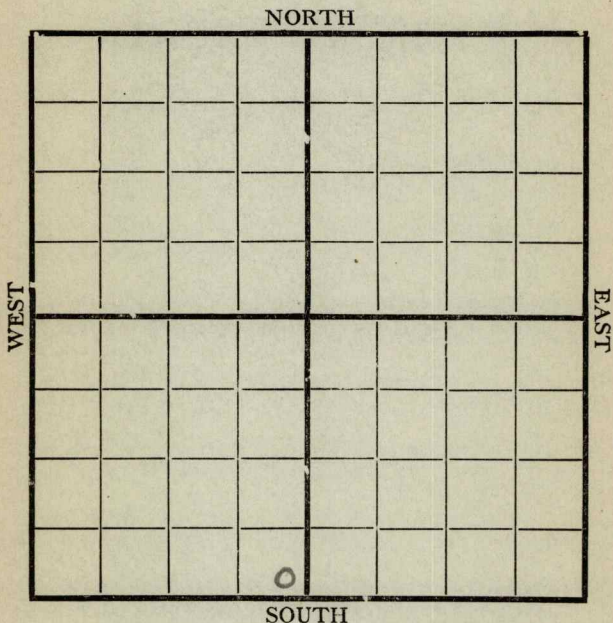Location 250 S-E

Rig up _____

Drilling and Remarks:

D 10 @
1000'
for water

RECORD

Cased _____ in., _____ ft.

Sand _____

Gas _____

Oil _____

Total Depth _____

PRODUCTION

1st 24 hrs. Nat. _____

1st 24 hrs. after shot _____

Gas _____ Cu. Ft.

Dry Hole _____

Abandoned _____

Date

9/1
20 1918Pyle Scout

Map No. K 15 Sec. 3 Twp. 26 ^S 8 ^EWell No. 9 Hull
Tidal Oil Company

Contractor

NORTH

WEST

EAST

SOUTH

Location 250 S-E

Rig up. _____

Drilling and Remarks:

DD @
1000' for
water

RECORD

Cased _____ in., _____ ft.

Sand _____

Gas _____

Oil _____

Total Depth _____

PRODUCTION

1st 24 hrs. Nat. _____

1st 24 hrs. after shot _____

Gas _____ Cu. Ft.

Dry Hole _____

Abandoned _____

Date

9/27 1918

Pyle

Scout


Map No. 15 Sec. 3 Twp. 26 R. 8

Well No. 9 Shull Farm
Tidal Oil Company

NORTH

WEST

EAST

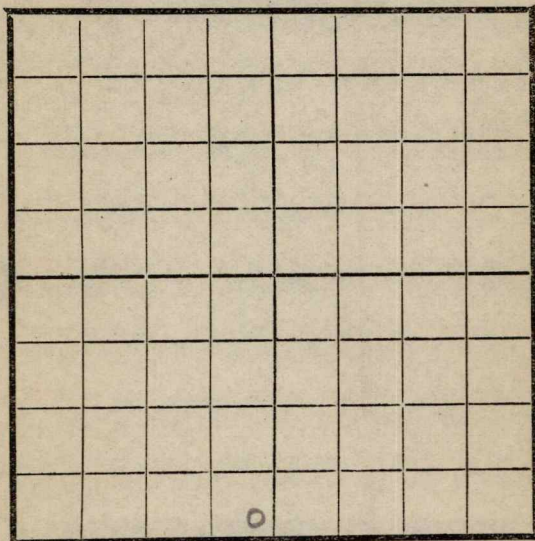

SOUTH

Location 250 S 7 E

Rig Up -----

Drilling and remarks

*SD for
water @
1000'*

RECORD

Cased ----- in. ----- Ft.
 Sand -----
 Gas -----
 Oil -----
 Total Depth -----

PRODUCTION

1st 24 hrs. Nat. -----
 1st 24 hrs. after shot -----
 Gas ----- Cu. Ft.
 Dry Hole -----
 Abandoned -----

Date

9/30, 1918

Pyle


Scout

Map No. K15 Sec. 3 Twp. 26 R. 8
 Well No. 9, Hull Farm
Tidal Oil Company

NORTH

WEST

EAST

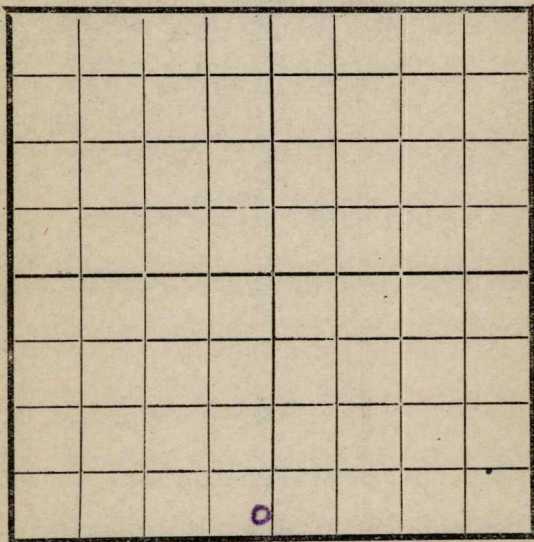

SOUTH

Location 250 S7E
 Rig Up _____
 Drilling and remarks

D 10 @
1000'

RECORD

Cased _____ in. _____ Ft.
 Sand _____
 Gas _____
 Oil _____
 Total Depth _____

PRODUCTION

1st 24 hrs. Nat. _____
 1st 24 hrs. after shot _____
 Gas _____ Cu. Ft.
 Dry Hole _____
 Abandoned _____

Date

10/7, 1918

Bye

Scout


Map No. K15 Sec. 3 Twp. 26 R. 8Well No. 9 Hull
Tidal Oil Company

Contractor

NORTH

WEST

EAST

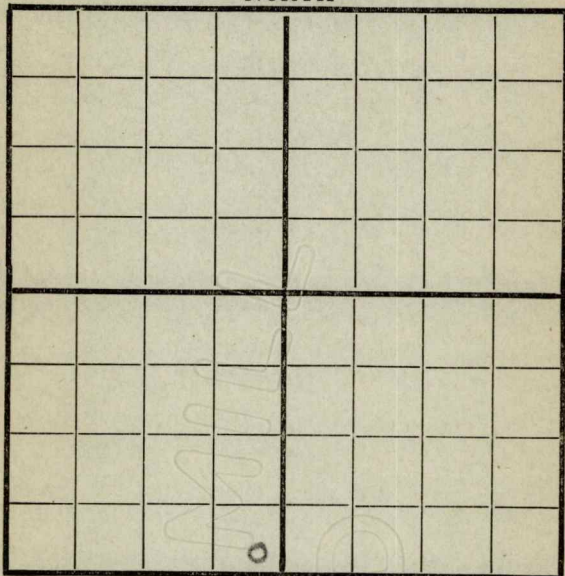

SOUTH

Location 250 S-E

Rig up

Drilling and Remarks:

1050'

RECORD

Cased _____ in., _____ ft.

Sand _____

Gas _____

Oil _____

Total Depth _____

PRODUCTION

1st 24 hrs. Nat. _____

1st 24 hrs. after shot _____

Gas _____ Cu. Ft.

Dry Hole _____

Abandoned _____

Date


10/14 1918

Pyle

Scout

Map No. K15 Sec. 3 Twp. 26 R. 8Well No. 9 Hull
Tidal Oil Company

Contractor

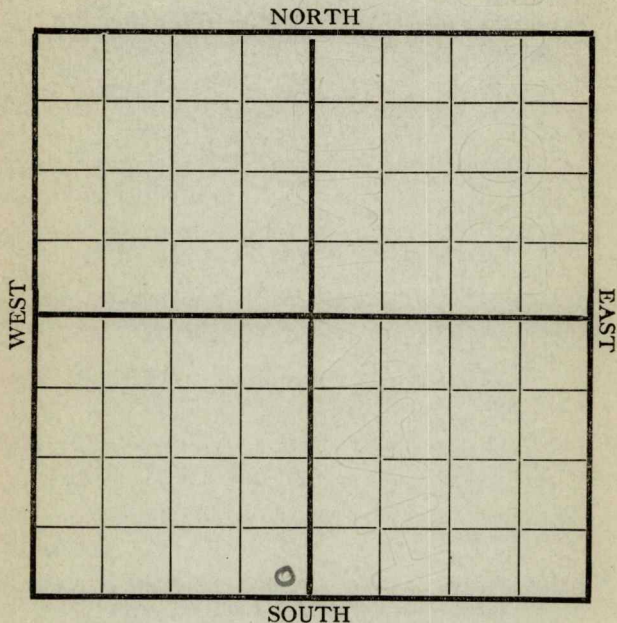Location 250 S-E

Rig up _____

Drilling and Remarks:

11 @ 1070'**RECORD**

Cased _____ in., _____ ft.

Sand _____

Gas _____

Oil _____

Total Depth _____

PRODUCTION

1st 24 hrs. Nat. _____

1st 24 hrs. after shot _____

Gas _____ Cu. Ft.

Dry Hole _____

Abandoned _____

Date

10-25 1918 Pyle ScoutBy McCrabb


Map No. 1515 Sec. 3 Twp. 26 R. 8Well No. 9 HullTidal Oil Company

Contractor

NORTH

WEST

EAST

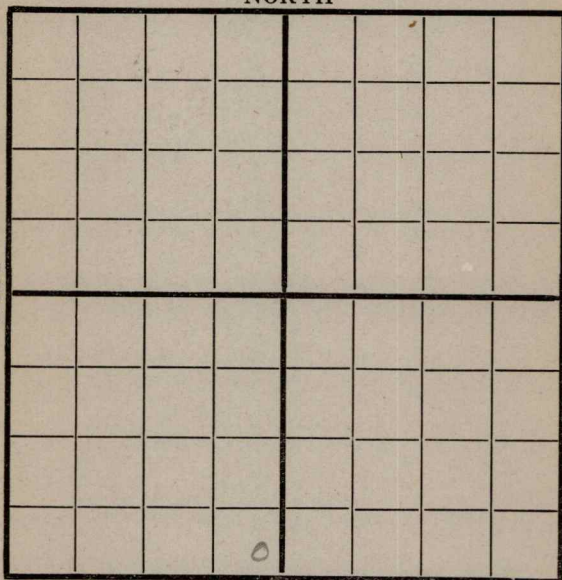

SOUTH

Location 250 S-E

Rig up

Drilling and Remarks:

8" @ 1435

RECORD

Cased _____ in., _____ ft.

Sand _____

Gas _____

Oil _____

Total Depth _____

PRODUCTION

1st 24 hrs. Nat. _____

1st 24 hrs. after shot _____

Gas _____ Cu. Ft.

Dry Hole _____

Abandoned _____

Date

Pyle

191

Scout

Map No. K 15 Sec. 3 Twp. 26 R. 8
 Well No. 9 Hull
Tidal Oil Company
 Contractor

NORTH							
WEST							
SOUTH							

Location <u>250-S-E</u>	RECORD
Rig up _____	Cased _____ in., _____ ft.
Drilling and Remarks:	Sand _____
	Gas _____
	Oil _____
	Total Depth _____
	PRODUCTION
	1st 24 hrs. Nat. _____
	1st 24 hrs. after shot _____
	Gas _____ Cu. Ft.
	Dry Hole _____
	Abandoned _____


Date 11/12 1918 **Pyle** Scout

Map No. K15 Sec. 3 Twp. 26 R. 8
 Well No. 9 Hull
Tidal Oil Company
 Contractor

NORTH

WEST

EAST

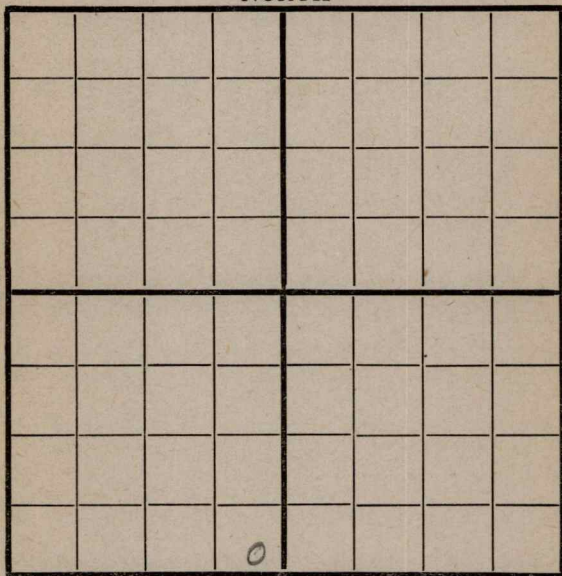

SOUTH

250 S-E

Location _____

Rig up _____

Drilling and Remarks:

RECORD

Cased _____ in., _____ ft.

Sand _____

Gas _____

Oil _____

Total Depth _____

PRODUCTION

1st 24 hrs. Nat. _____

1st 24 hrs. after shot _____

Gas _____ Cu. Ft.

Dry Hole _____

Abandoned _____

Date

11/181918Scout

Map No. K15 Sec. 3 Twp. 26 R. 8

Well No. 9. Hull
Tidal Oil Company

Company

Contractor

NORTH

WEST

FEAST

SOUTH

250 S-E

Location _____

Rig up-----

Drilling and Remarks:

RECORD

Cased _____ in., _____ ft.

Sand _____

Gas _____

Oil _____

Total Depth_____

PRODUCTION

1st 24 hrs. Nat. -----

1st 24 hrs. after shot-----

Gas.....Cu. Ft.

Dry Hole

Abandoned.....

Date _____

191

Scout

Pyle

Contractor

WEST

EAST

SOUTH

250 S-E

Location _____

Rig up _____

Drilling and Remarks:

RECORD

Cased _____ in., _____ ft.

Sand_____

Gas _____

Oil _____

Total Depth_____

PRODUCTION

1st 24 hrs. Nat. -----

1st 24 hrs. after shot_____

Gas_____Cu. Ft.

Dry Hole_____

Abandoned_____

Date _____

191

Scout


Map No. K15 Sec. 3 Twp. 26 R. 8Well No. 9 Hull
Tidal Oil Company

Contractor

NORTH

WEST

EAST

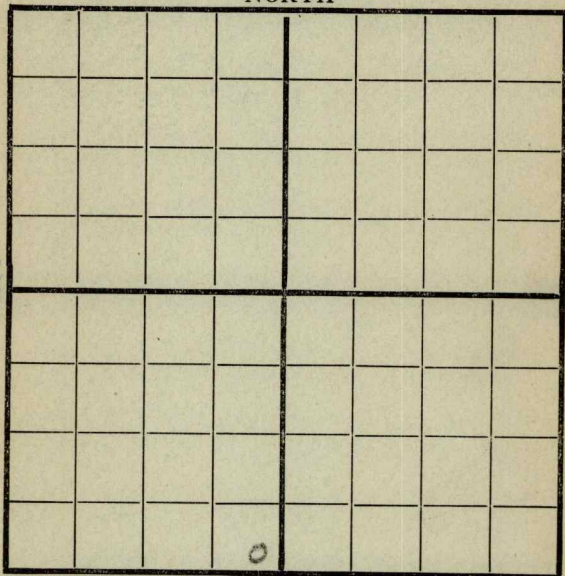

SOUTH

250 S-E

Location _____

Rig up _____

Drilling and Remarks:

2560'

RECORD

Cased _____ in., _____ ft.

Sand _____

Gas _____

Oil _____

Total Depth _____

PRODUCTION

1st 24 hrs. Nat. _____

1st 24 hrs. after shot _____

Gas _____ Cu. Ft.

Dry Hole _____

Abandoned _____

Date

12/9 1918

H. B.

Scout

Map No. K15 Sec. 3 Twp. 26 R. 8
 Well No. 9 Hull
Tidal Oil Company
 Contractor

NORTH

SOUTH

250 S-E

WEST

EAST

	RECORD
Location _____	Cased _____ in., _____ ft.
Rig up _____	Sand _____
Drilling and Remarks:	Gas _____
O 10 for orders @ 2587	Oil _____
	Total Depth _____
	PRODUCTION
	1st 24 hrs. Nat. _____
	1st 24 hrs. after shot _____
	Gas _____ Cu. Ft.
	Dry Hole _____
	Abandoned _____

Date 12/19 1918 Pyle Scout

Map No. K15 Sec. 13 Twp. 26 R. 8Well No. 9 - Gulf
Tidal Oil

Company

Contractor

NORTH

WEST

EAST

COMPLETED

SOUTH

2505-E

Location

Rig up

Drilling and Remarks:

RECORD

Cased _____ in., _____ ft.

Sand _____

Gas _____

Oil _____

Total Depth _____

PRODUCTION

1st 24 hrs. Nat. _____

1st 24 hrs. after shot _____

Gas _____ Cu. Ft.

Dry Hole 2680

Abandoned _____

Date

12/191826Cycle

Scout