

FORM 51 25M 3-49 PETROL


KANSAS

Butler

Section 32 Township 26 Range 4-E

Well No. #1 Corbin

Company Gross Supply

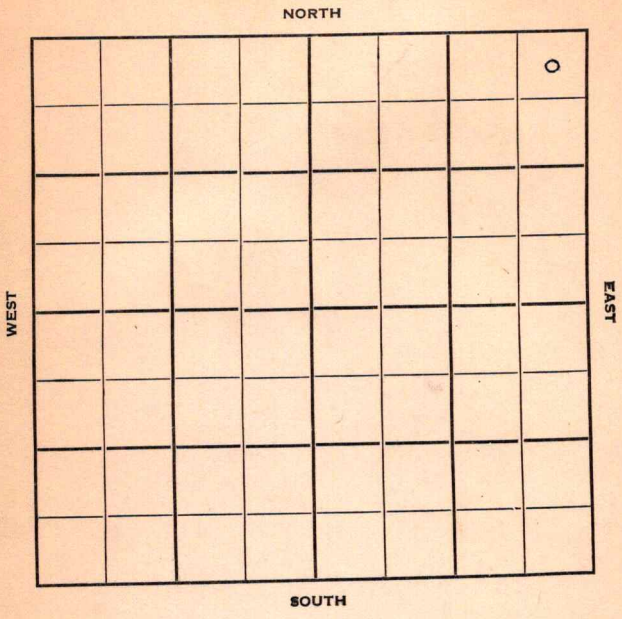

Butler

KANSAS

Sec. 32 Twp. 26 R. 4E

Well No. #1 Corbin Farm

Gross Supply Company

Contractor


330' Ft. from N. Line

Ft. from S. Line

330' Ft. from E. Line

Ft. from W. Line

NE NE NE

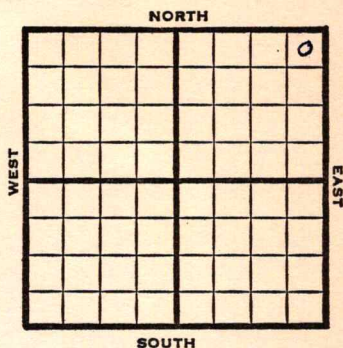

1950

Elev 1249

REPORT

6/28 Spud 6-22-50
8-5/8" @ 105'
Drlg. 1385'

7/12 8 5/8" @ 105'
Chat 2642
TD 2868
Simp 2861
D&A

Viola 2847

ABANDONED

Map No. _____ Sec. 32 Twp. 26 R. 4EWell No. 1 Corbin

Gross Supply _____ Company _____

Contractor _____

NE NE NE

SECTION PLAT

330 Ft. from N. Line

_____ Ft. from S. Line

330 Ft. from E. Line

_____ Ft. from W. Line

			0

FIRST REPORT

Butler County

Location _____

Rig up _____

Drilling and Remarks:

Spud 6-22-50

8 5/8" @ 105

drlg. 1385

RECORD

Cased _____ in., _____ ft.

Sand _____

Gas _____

Oil _____

Total Depth _____

PRODUCTION

1st 24 hrs. Nat. _____

1st 24 hrs. after shot _____

Gas _____ Cu. Ft.

Dry Hole _____

Abandoned _____

Date

JUN 28 1950 19

J. E. TYRA Scout

Kansas

Map No. _____ Sec. 32 Twp. 26 R. 4EWell No. 1 Corbin

_____ Gross Supply _____ Company

_____ Contractor

NE NE NE

E1. 1249
SECTION PLAT330 Ft. from N. Line

_____ Ft. from S. Line

330 Ft. from E. Line

_____ Ft. from W. Line



Butler County

Location _____

Rig up _____

Drilling and Remarks:

8 5/8" @ 105

Chat. 2642

Viola 2847

TD 2868

Simp. 2861

D. & A

RECORD

Cased _____ in., _____ ft.

Sand _____

Gas _____

Oil _____

Total Depth 2868

PRODUCTION

1st 24 hrs. Nat. _____

1st 24 hrs. after shot _____

Gas _____ Cu. Ft.

Dry Hole _____

Abandoned _____

Date

JUL 12 1950 19 J. E. TYRA Scout