


Section 12 Township 26 Range 8E

Well No. 1 - Moore

Company Kansas Oil Co., Inc.

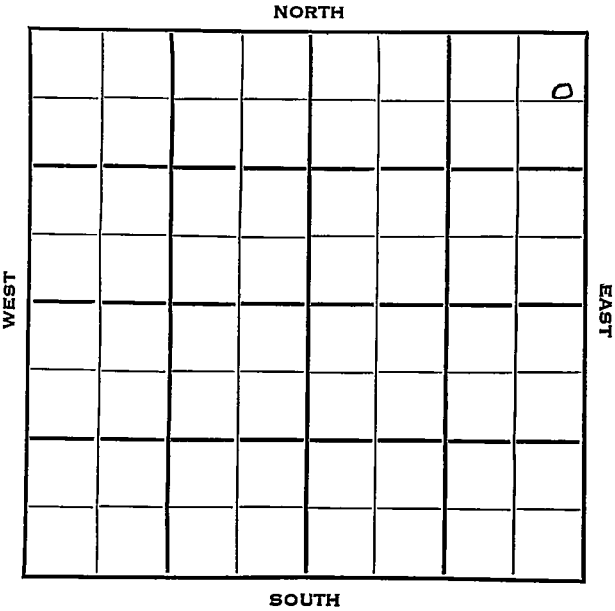

KANSAS ✓

Sec. 12 Twp. 26 R. 8E

Well No. 1 Moore Farm

Kansas Oil Co., Inc. Company

Sunflower Drlg. Contractor


550 Ft. from N. Line

Ft. from S. Line

330 Ft. from E. Line

Ft. from W. Line

NE NE NE

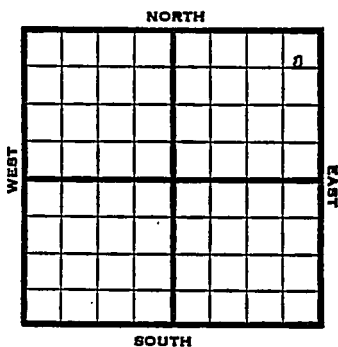

1952 ELEV. - REPORT

12/30 Spudding 12/18/52, 8" @ 85 Drlg. 2300

1953

1/7 Spud 12-18-52

D&A

TD 2540

8" @85

Bart 2414, Miss 2511

TD 2540

D&A

ABANDONED

County Greenwood State Kansas
 Sec. 12 (Blk.) 26 (Sur.) 8E Map No.
 Operator Kansas Oil Co., Inc.
 Well No. 1 Farm Moore
 Elev. _____ Location NE NE NE

FIRST REPORT

550 Ft. From N Line NE
330 Ft. From E Line Quarter
 1st. Report DEC 30 1952
 Completion _____
 Remarks _____
Sunflower Drlg. - Contr.
 Spudding Date 12-18-52

Drlg. Data

8" @ 85 drlg. 2300

J. G. McGEHEE

County Greenwood State Kansas
 Sec. 12 (Blk.) 26 (Sur.) 8E Map No.
 Operator Kansas Oil Co., Inc.
 Well No. 1 Farm Moore
 Elev. Location NE NE NE

							o

550 Ft. From N Line NE330 Ft. From E Line Quarter1st. Report Completion JAN 7 1953Remarks Sunflower Drlg. - Contr.Spudding Date 12-18-52Drlg. Data D & A TD 25408" @ 85 Bart. 2414 Miss. 2511TD 2540D & A