


Map No. _____ Sec. 12 Twp. 26 R. 8
 Well No. 1 Susan Voel Farm
7 Flint Hill Pet Company

NORTH

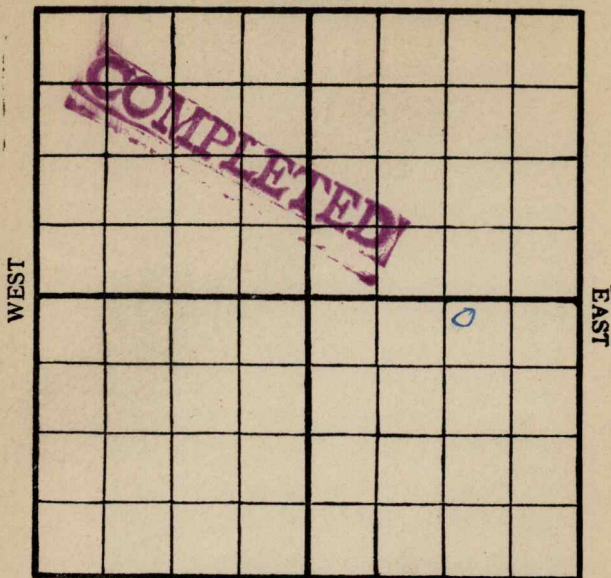

SOUTH

Location _____

Rig Up _____

Drilling Remarks:

Drilling Remarks:

RECORD

PRODUCTION

Cased _____ in. _____ ft.

1st 24 hrs. Nat. _____

Sand _____

1st 24 hrs. after shot _____

Gas _____

Gas _____ cu. ft.

Oil _____


Dry Hole _____

Total Depth _____

Abandoned _____

Map No. _____ Sec. 12 Twp. 26 R. 8
 Well No. 1 Vase Farm _____
Flint Hill Pet Company _____

NORTH

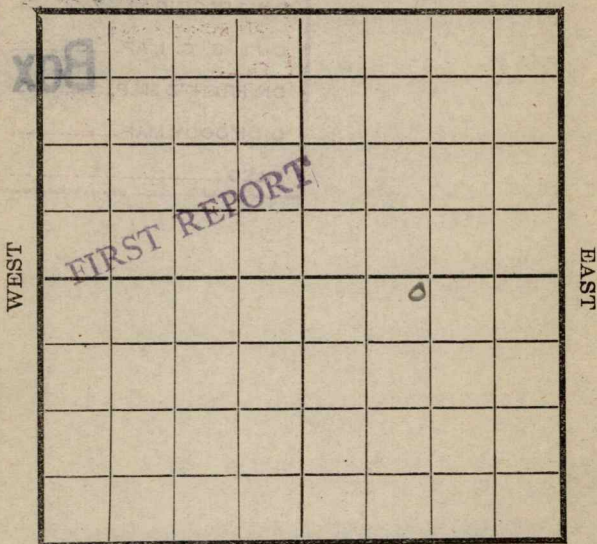

SOUTH

Location _____
 Rig Up ☒ _____
 Drilling and remarks _____

RECORD

Cased _____ in. _____ Ft.
 Sand _____
 Gas _____
 Oil _____
 Total Depth _____

PRODUCTION

1st 24 hrs. Nat. _____
 1st 24 hrs. after shot _____
 Gas _____ Cu. Ft.
 Dry Hole _____
 Abandoned _____

Date

11/9, 1917 Pyle Scout

Map No. _____ Sec. 12 Twp. 26 R. 5Well No. 208 Farm _____
Flint Hill Company _____

NORTH

WEST

EAST

SOUTH

Location _____

Rig Up _____

Drilling and remarks _____

RECORD

Cased _____ in. _____ Ft.

Sand _____

Gas _____

Oil _____

Total Depth _____

PRODUCTION

1st 24 hrs. Nat. _____

1st 24 hrs. after shot _____

Gas _____ Cu. Ft.

Dry Hole _____

Abandoned _____


Date

1/14, 1917 Pyle Scout

Map No. _____ Sec. 12 Twp. 26 R. 8Well No. 1 Nose Farm _____Glint Hill Company _____

NORTH

WEST

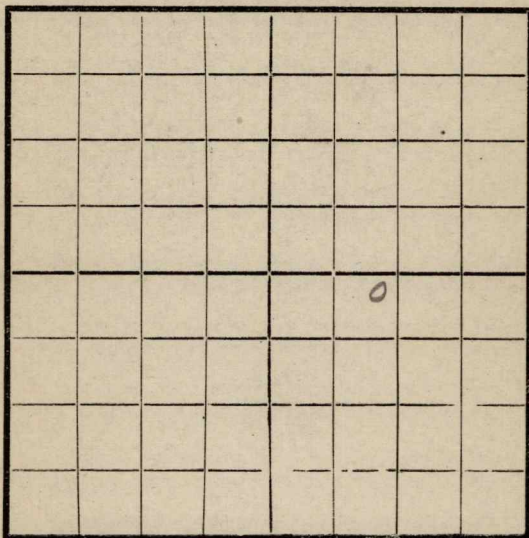

EAST

SOUTH

Location _____

Rig Up ✓ _____

Drilling and remarks _____

RECORD

Cased _____ in. _____ Ft.

Sand _____

Gas _____

Oil _____

Total Depth _____

PRODUCTION

1st 24 hrs. Nat. _____

1st 24 hrs. after shot _____

Gas _____ Cu. Ft.

Dry Hole _____

Abandoned _____

Date

11/24, 1917 Pryle Scout

Map No. _____ Sec. 12 Twp. 24 R. 8Well No. 1200 Farm _____
Flinn Hill Pub Company

NORTH

WEST

EAST

SOUTH

Location _____

Rig Up ☒

Drilling and remarks _____

RECORD

Cased _____ in _____ Ft.

Sand _____

Gas _____

Oil _____

Total Depth _____

PRODUCTION

1st 24 hrs. Nat. _____

1st 24 hrs. after shot _____

Gas _____ Cu. Ft.

Dry Hole _____

Abandoned _____

Date

11/29, 1917 Pyle Scout

Map No. _____ Sec. 17 Twp. 26 R. 8Well No. 1 Vase Farm _____Flint Hill Pub Company _____

NORTH

WEST

EAST

SOUTH

RECORD

Location _____

Cased _____ in. _____ Ft.

Rig Up _____

Sand _____

Drilling and remarks

Gas _____

Oil _____

Total Depth _____

PRODUCTION

1st 24 hrs. Nat. _____

1st 24 hrs. after shot _____

Gas _____ Cu. Ft.

Dry Hole _____

Abandoned _____

Date


12/5, 1917 Pyle Scout

Map No. _____ Sec. 12 Twp. 24 R. 8
Well No. 1 Vase Farm _____
Flint Hill Company

NORTH

WEST

EAST

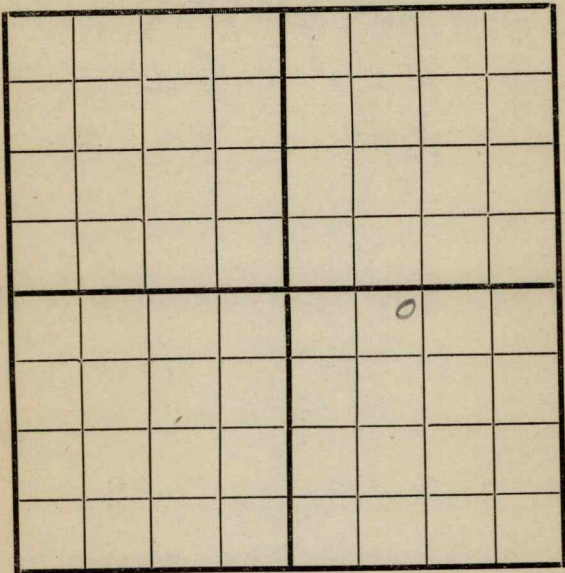

SOUTH

Location _____
Rig Up _____
Drilling and remarks

spudding

RECORD

Cased _____ in. _____ Ft.
Sand _____
Gas _____
Oil _____
Total Depth _____

PRODUCTION


1st 24 hrs. Nat. _____
1st 24 hrs. after shot _____
Gas _____ Cu. Ft.
Dry Hole _____
Abandoned _____

Date

1/12, 1918 Pyle Scout

Map No. K15 Sec. 12 Twp. 26 R. 8
 Well No. 1 Susan Vase Farm
Flint Hill. O & B. Company

NORTH

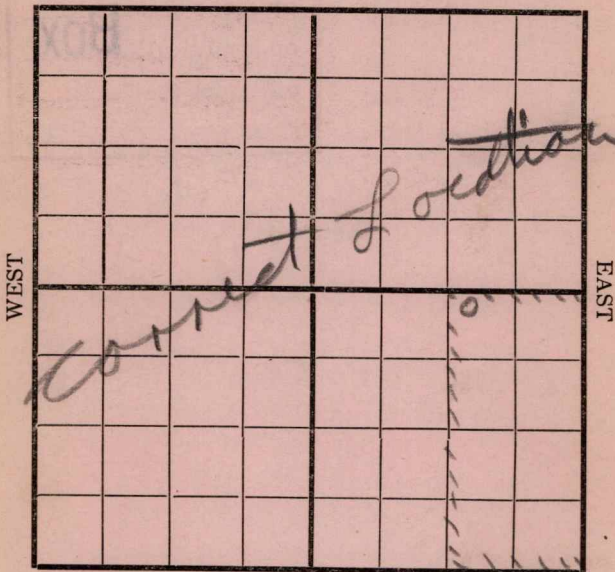

SOUTH

Location _____
 Rig Up ☒
 Drilling and remarks _____

RECORD

Cased _____ in. _____ Ft.
 Sand _____
 Gas _____
 Oil _____
 Total Depth _____

PRODUCTION

1st 24 hrs. Nat. _____
 1st 24 hrs. after shot _____
 Gas _____ Cu. Ft.
 Dry Hole _____
 Abandoned _____


Date 1/26, 1918 Oyle Scout

Map No. _____ Sec. 12 Twp. 26 R. 8
 Well No. 1 Susan Vose Farm
Flint Hill Company

NORTH

WEST

EAST

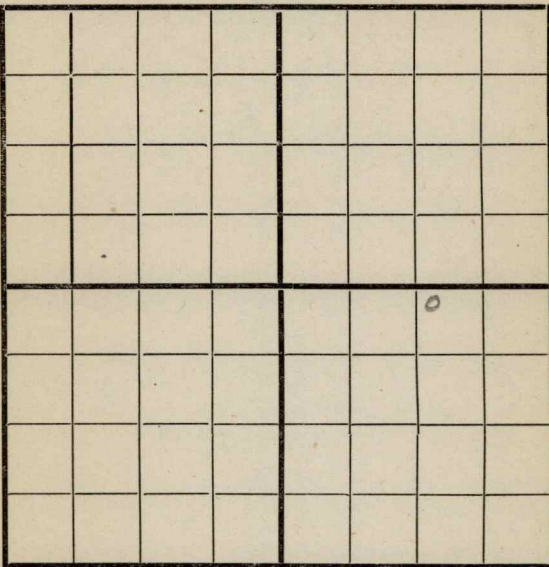

SOUTH

Location _____
 Rig Up _____
 Drilling and remarks _____

RECORD

Cased _____ in. _____ Ft.
 Sand _____
 Gas _____
 Oil _____
 Total Depth _____


PRODUCTION

1st 24 hrs. Nat. _____
 1st 24 hrs. after shot _____
 Gas _____ Cu. Ft.
 Dry Hole _____
 Abandoned _____

Date 2/1, 1918 Pyle Scout

Map No. _____ Sec. 12 Twp. 26 R. 8
 Well No. 1 Vose Farm
Flint Hill Company

NORTH

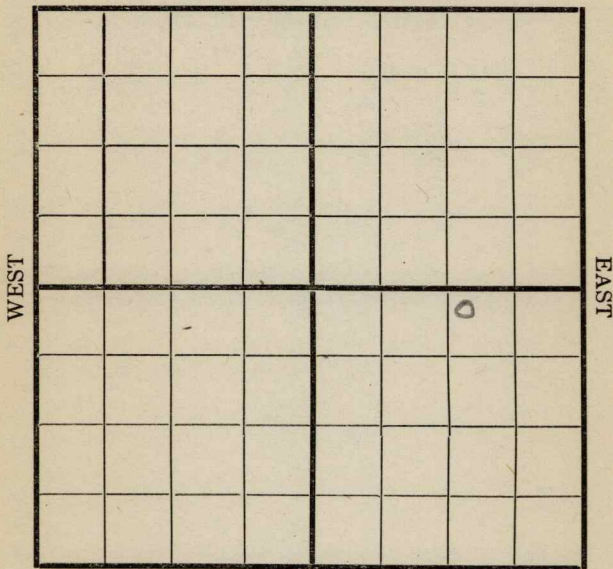

SOUTH

Location _____
 Rig Up _____
 Drilling and remarks _____

RECORD

Cased _____ in. _____ Ft.
 Sand _____
 Gas _____
 Oil _____
 Total Depth _____

PRODUCTION


1st 24 hrs. Nat. _____
 1st 24 hrs. after shot _____
 Gas _____ Cu. Ft.
 Dry Hole _____
 Abandoned _____

Date 2/7, 1918 Oyle Scout

Map No. _____ Sec. 12 Twp 26 R. 8Well No. 1 Susan Rose FarmFlint Hill Company

NORTH

WEST

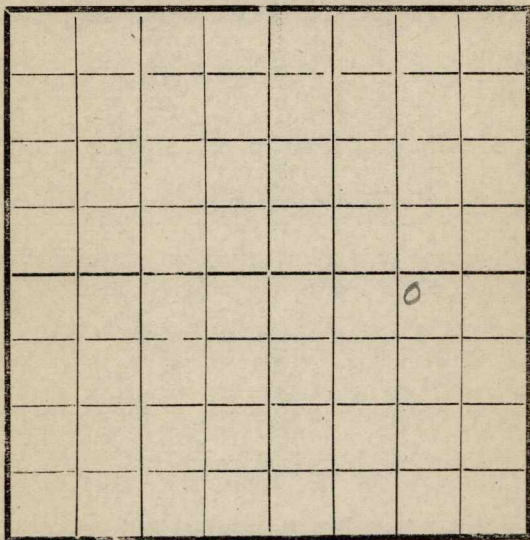

EAST

SOUTH

Location _____

Rig Up _____

Drilling and remarks

D. D.
75'

RECORD

Cased _____ in. _____ Ft.

Sand _____

Gas _____

Oil _____

Total Depth _____

PRODUCTION

1st 24 hrs. Nat. _____

1st 24 hrs. after shot _____

Gas _____ Cu. Ft.

Dry Hole _____

Abandoned _____


Date

2/14 1918 *Oye* Scout

Map No. _____ Sec. 12 Twp. 24 R. 8
 Well No. 1 Wose Farm _____
Flinch Hill Company _____

NORTH

WEST

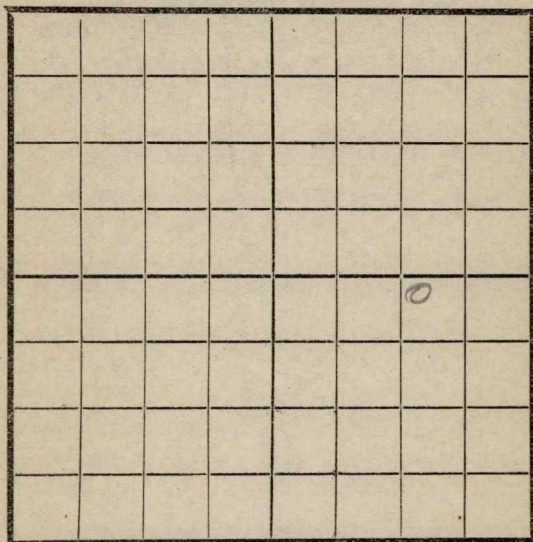

EAST

SOUTH

Location _____
 Rig Up _____
 Drilling and remarks _____

D.O.
@
75

RECORD

Cased _____ in. _____ Ft.
 Sand _____
 Gas _____
 Oil _____
 Total Depth _____

PRODUCTION

1st 24 hrs. Nat. _____
 1st 24 hrs. after shot _____
 Gas _____ Cu. Ft.
 Dry Hole _____
 Abandoned _____

Date

2/8, 1918 Cyph Scout
22


Map No. _____ Sec. 12 Twp. 26 R. 8

Well No. 1 2000 Farm _____

Flint Hill Company _____

NORTH

WEST

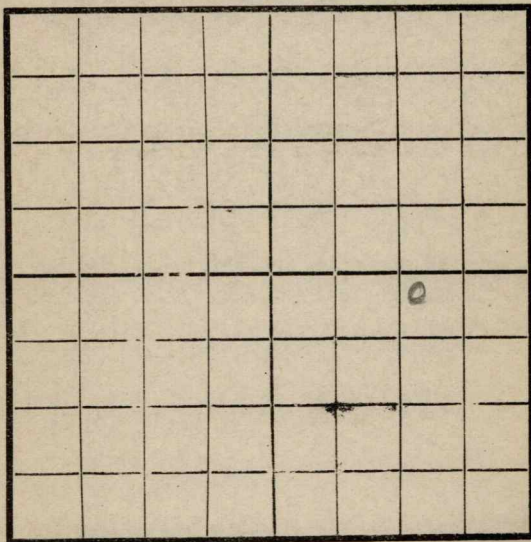

EAST

SOUTH

Location _____

Rig Up _____

Drilling and remarks

D. D. @
75

RECORD

Cased _____ in _____ Ft

Sand _____

Gas _____

Oil _____

Total Depth _____

PRODUCTION

1st 24 hrs. Nat. _____

1st 24 hrs. after shot _____

Gas _____ Cu. Ft

Dry Hole _____

Abandoned _____

Date

3/2, 1918 Pyle Scout _____


Map No. _____ Sec. 12 Twp. 26 R. 8

Well No. 1 Vose Farm

Flint Hill Company

NORTH

WEST

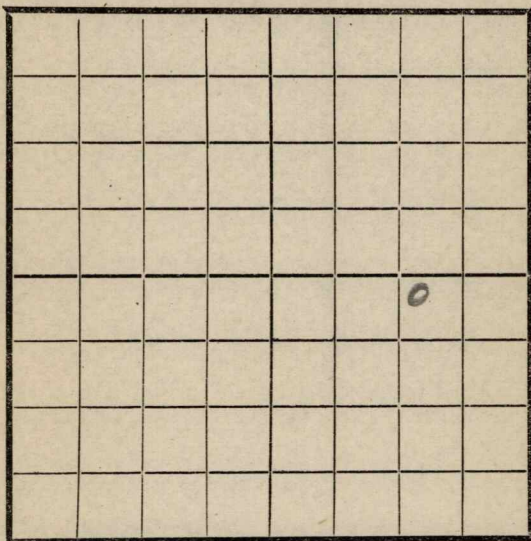

EAST

SOUTH

Location _____

Rig Up _____

Drilling and remarks

200'

RECORD

Cased _____ in. _____ Ft.

Sand _____

Gas _____

Oil _____

Total Depth _____

PRODUCTION

1st 24 hrs. Nat. _____

1st 24 hrs. after shot _____

Gas _____ Cu. Ft.

Dry Hole _____

Abandoned _____

Date

3/16, 1918


Pyle

Scout

Map No. _____ Sec. 12 Twp. 24 R. 8Well No. 1 Vose Farm _____Lehigh Hill Company _____

NORTH

WEST

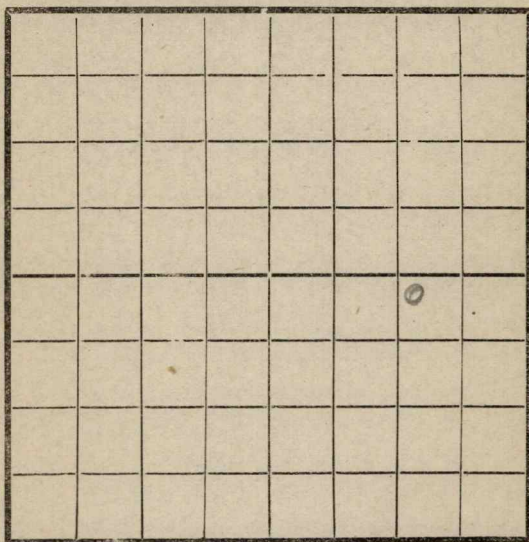

EAST

SOUTH

Location _____

Rig Up _____

Drilling and remarks

350'

RECORD

Cased _____ in _____ Ft.

Sand _____

Gas _____

Oil _____

Total Depth _____

PRODUCTION

1st 24 hrs. Nat. _____

1st 24 hrs. after shot _____

Gas _____ Cu. Ft.

Dry Hole _____

Abandoned _____


Date

3/8, 1918 Oyle Scout22

Map No. _____ Sec. 12 Twp. 26 R. 8Well No. 1 Vase FarmFlint Hill Company

NORTH

WEST

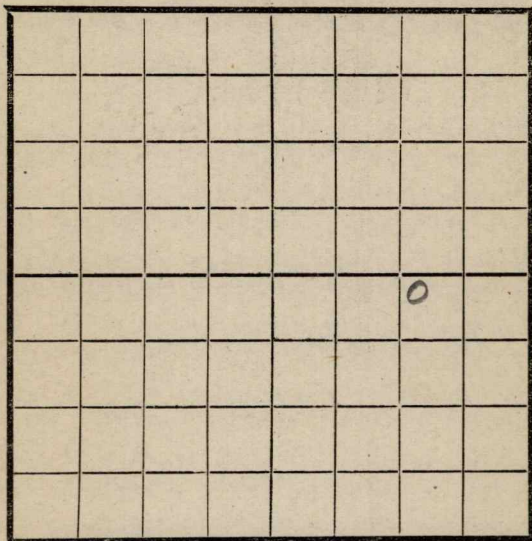

EAST

SOUTH

RECORD

Location _____

Cased _____ in. _____ Ft.

Rig Up _____

Sand _____

Drilling and remarks

Gas _____

Oil _____

Total Depth _____

PRODUCTION

1st 24 hrs. Nat. _____

1st 24 hrs. after shot _____

Gas _____ Cu. Ft.

Dry Hole _____

Abandoned _____

Date


3/30, 1918 Oyle Scout

Map No. _____ Sec. 17 Twp. 26 R. 8

Well No. 1 Case Farm _____
Flint Hill Company _____

NORTH

WEST

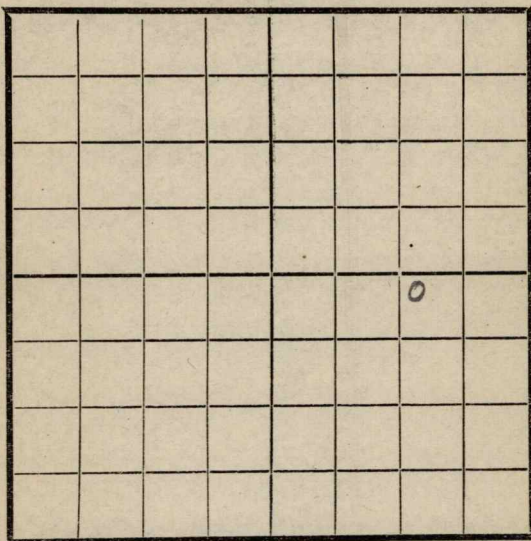

EAST

SOUTH

Location _____

Rig Up _____

Drilling and remarks

900

RECORD

Cased _____ in. _____ Ft.

Sand _____

Gas _____

Oil _____

Total Depth _____

PRODUCTION

1st 24 hrs. Nat. _____

1st 24 hrs. after shot _____

Gas _____ Cu. Ft.

Dry Hole _____

Abandoned _____


Date

4/8, 1918 Cape Scout

Map No. _____ Sec. 12 Twp. 24 R. 8Well No. 1 Vose Farm
Flint Hill Oil Company

NORTH

WEST

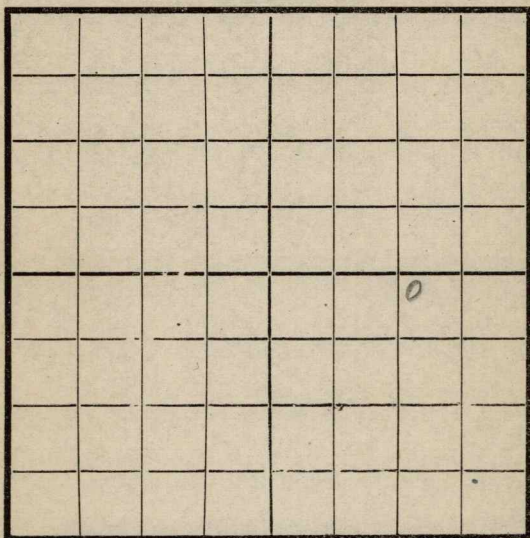

EAST

SOUTH

Location _____

Rig Up _____

Drilling and remarks

1500'

RECORD

Cased _____ in. _____ Ft.

Sand _____

Gas _____

Oil _____

Total Depth _____

PRODUCTION

1st 24 hrs. Nat. _____

1st 24 hrs. after shot _____

Gas _____ Cu. Ft.

Dry Hole _____

Abandoned _____

Date

4/8, 191813

Scout

Orya


Map No. _____ Sec. 12 Twp. 26 R. 8

Well No. 1 Case Farm _____

Flint Hill Company _____

NORTH

WEST

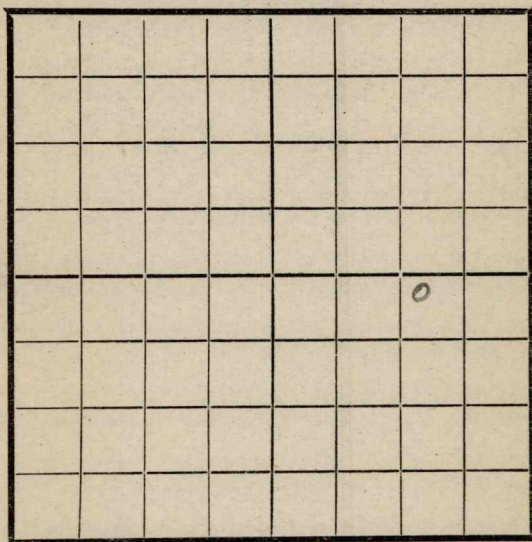

EAST

SOUTH

Location _____

Rig Up _____

Drilling and remarks

D. D. C.
1500'

RECORD

Cased _____ in. _____ Ft.

Sand _____

Gas _____

Oil _____

Total Depth _____

PRODUCTION

1st 24 hrs. Nat. _____

1st 24 hrs. after shot _____

Gas _____ Cu. Ft.

Dry Hole _____

Abandoned _____

Date

4/8, 1918 Oyle Scout

Map No. _____ Sec. 12 Twp. 26 R. 8Well No. 1 Vose Farm _____Flint Hill Oil Company _____

NORTH

WEST

EAST

SOUTH

Location _____

Rig Up _____

Drilling and remarks

9. R. 10" @1100'

RECORD

Cased _____ in. _____ Ft.

Sand _____

Gas _____

Oil _____

Total Depth _____

PRODUCTION

1st 24 hrs. Nat. _____

1st 24 hrs. after shot _____

Gas _____ Cu. Ft.

Dry Hole _____

Abandoned _____

Date


4/26, 1918 Cyle Scout

Map No. _____ Sec. 12 Twp. 26 R. 8
 Well No. 1 Vase Farm _____
Flint Kill Out Company _____

NORTH

WEST

EAST

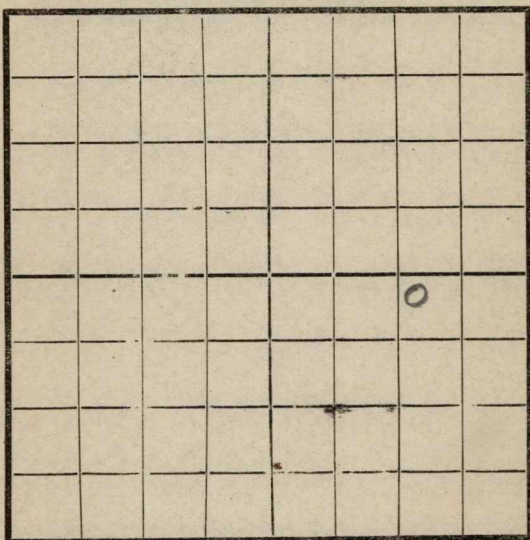

SOUTH

Location _____
 Rig Up _____
 Drilling and remarks _____

1400'

RECORD

Cased _____ in. _____ Ft.
 Sand _____
 Gas _____
 Oil _____
 Total Depth _____

PRODUCTION


1st 24 hrs. Nat. _____
 1st 24 hrs. after shot _____
 Gas _____ Cu. Ft.
 Dry Hole _____
 Abandoned _____

Date 5/4, 1918 Pyle Scout

Map No. _____ Sec. 12 Twp. 26 R. 8
 Well No. 1 Susan Vose Farm
Flint Hill Company

NORTH

WEST

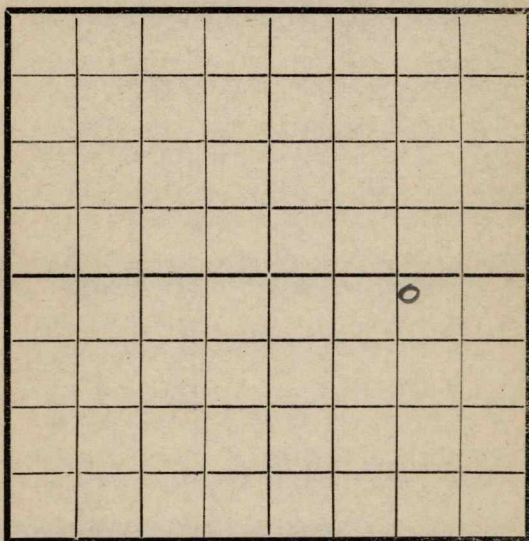

EAST

SOUTH

Location _____

Rig Up _____

Drilling and remarks

1260'

RECORD

Cased _____ in. _____ Ft.

Sand _____

Gas _____

Oil _____

Total Depth _____

PRODUCTION

1st 24 hrs. Nat. _____

1st 24 hrs. after shot _____

Gas _____ Cu. Ft.

Dry Hole _____

Abandoned _____

Date


5/11, 1918 Pyle Scout

Map No. # _____ Sec. 12 Twp. 26 R. 8
 Well No. 1 Susan Vase
Flint Hill Company _____
 Contractor _____

NORTH

WEST

EAST

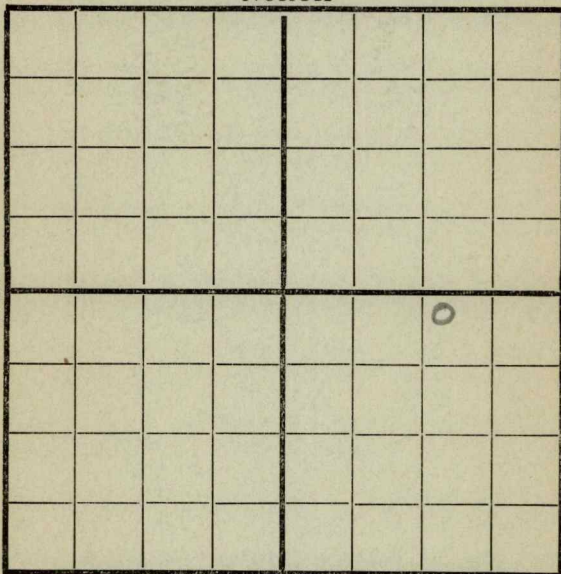

SOUTH

Location _____

Rig up _____

Drilling and Remarks:

D. 10 @

1300

RECORD

Cased _____ in., _____ ft.

Sand _____

Gas _____

Oil _____

Total Depth _____

PRODUCTION

1st 24 hrs. Nat. _____

1st 24 hrs. after shot _____

Gas _____ Cu. Ft.

Dry Hole _____

Abandoned _____

Date

5/18

191

S. Pyle

Scout

Map No. _____ Sec. 12 Twp. 26 R. 8Well No. 1 VaseFlint Hill _____ Company_____
Contractor

NORTH

WEST

EAST

SOUTH

Location _____

Rig up _____

Drilling and Remarks:

1350'

RECORD

Cased _____ in., _____ ft.

Sand _____

Gas _____

Oil _____

Total Depth _____

PRODUCTION

1st 24 hrs. Nat. _____

1st 24 hrs. after shot _____

Gas _____ Cu. _____

Dry Hole _____

Abandoned _____


Date

5/24 1918 Cycle

Map No. _____ Sec. 12 Twp. 26 R. 8Well No. 1 Susan VoseFlinn Hill Company _____

Contractor _____

NORTH

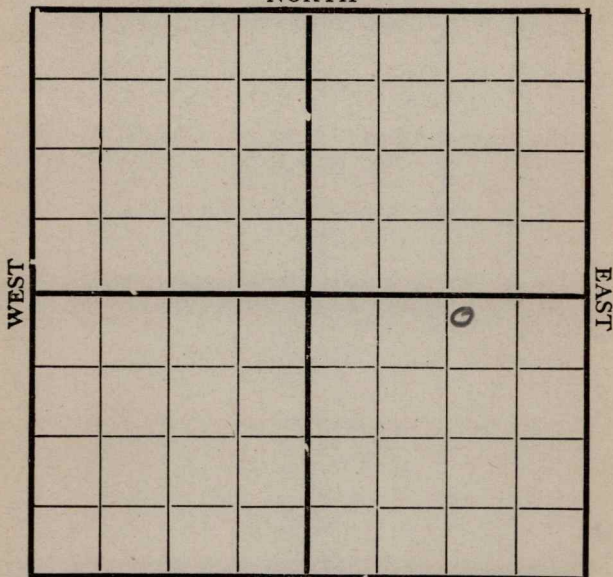

SOUTH

Location _____

Rig up _____

Drilling and Remarks:

1350'**RECORD**

Cased _____ in., _____ ft.

Sand _____

Gas _____

Oil _____

Total Depth _____

PRODUCTION

1st 24 hrs. Nat. _____

1st 24 hrs. after shot _____

Gas _____ Cu. Ft.

Dry Hole _____

Abandoned _____

Date

5/31 1918Cyle Scout

Map No. _____ Sec. 12 Twp. 26 R. 8
 Well No. 1 Susan Vase
Flint Hill Company _____
 Contractor _____

NORTH

WEST

EAST

SOUTH

Location _____

Rig up _____

Drilling and Remarks:

S. D. @
 1450'

RECORD

Cased _____ in., _____ ft.

Sand _____

Gas _____

Oil _____

Total Depth _____

PRODUCTION

1st 24 hrs. Nat. _____

1st 24 hrs. after shot _____

Gas _____ Cu. Ft.

Dry Hole _____

Abandoned _____

Date

191

Scout


Map No. _____ Sec. 12 Twp. 26 R. 8Well No. 1 Susan VaseFlint Hill Company _____

Contractor _____

NORTH

WEST

EAST

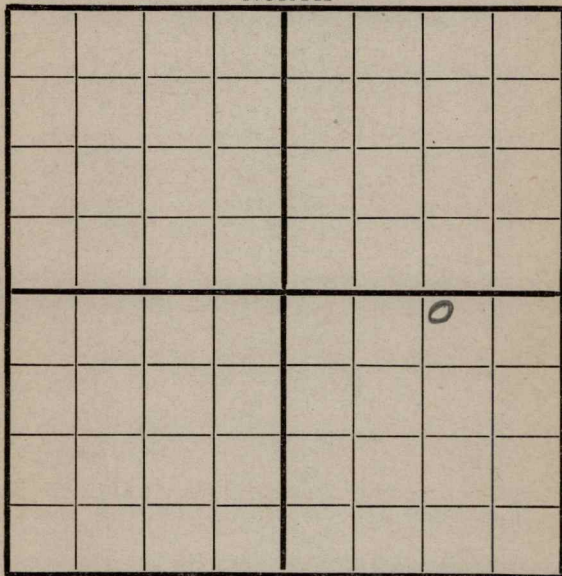

SOUTH

Location _____

Rig up _____

Drilling and Remarks:

1800'

RECORD

Cased _____ in., _____ ft.

Sand _____

Gas _____

Oil _____

Total Depth _____

PRODUCTION

1st 24 hrs. Nat. _____

1st 24 hrs. after shot _____

Gas _____ Cu. Ft.

Dry Hole _____

Abandoned _____

Date

6/4 1918 Dyle Scout

Map No. _____ Sec. 12 Twp. 36 R. 8
 Well No. 1 Susan Rose
Flinch Hill _____ Company _____ Contractor _____

NORTH							
WEST							
SOUTH							

Location _____ Rig up _____ Drilling and Remarks: <u>D.O @</u> <u>1800'</u>	RECORD
	Cased _____ in., _____ ft. Sand _____ Gas _____ Oil _____ Total Depth _____
	PRODUCTION
	1st 24 hrs. Nat. _____
	1st 24 hrs. after shot _____
	Gas _____ Cu. Ft.
	Dry Hole _____
	Abandoned _____

Date 4/21 1915 Oyle Scout

Map No. _____ Sec. 12 Twp. 26 R. 8Well No. 1 VaseFlint Hill Oil Company

Contractor _____

NORTH

WEST

EAST

SOUTH

Location _____

Rig up _____

Drilling and Remarks:

Set 6 1/4" @
1800'

RECORD

Cased _____ in., _____ ft.

Sand _____

Gas _____

Oil _____

Total Depth _____

PRODUCTION

1st 24 hrs. Nat. _____

1st 24 hrs. after shot _____

Gas _____ Cu. Ft.

Dry Hole _____

Abandoned _____


Date

6/28 1918 Cyke Scout

Map No. _____ Sec. 12 Twp. 26 R. 8
Well No. 1 Vase Farm _____
Shunt Hill Oil Company

NORTH

WEST

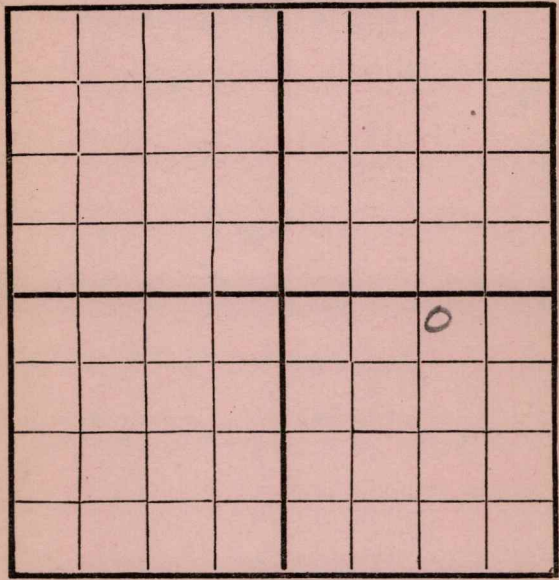

EAST

SOUTH

Location _____
Rig Up _____
Drilling and remarks

2017'

RECORD

Cased _____ in. _____ Ft.
Sand _____
Gas _____
Oil _____
Total Depth _____

PRODUCTION

1st 24 hrs. Nat. _____
1st 24 hrs. after shot _____
Gas _____ Cu. Ft.
Dry Hole _____
Abandoned _____

Date 7/6, 1918 Cylin Scout

Map No. _____ Sec. 12 Twp. 26 R. 8
 Well No. 1 Case
Trinity Hill Pet. Company
 Contractor _____

NORTH							
WEST							
SOUTH							
EAST							

Location _____ Rig up _____ Drilling and Remarks: <u>N. R. 6 1/4</u> <u>@ 1960'</u>	RECORD Cased _____ in., _____ ft. Sand _____ Gas _____ Oil _____ Total Depth _____ PRODUCTION 1st 24 hrs. Nat. _____ 1st 24 hrs. after shot _____ Gas _____ Cu. Ft. Dry Hole _____ Abandoned _____
---	---

Date 7/13 1918 J. L. Scout

Map No. _____ Sec. 12 Twp. 26 R. 8

Well No. _____


Frank Hill _____ Company

_____ Contractor

NORTH

WEST

EAST

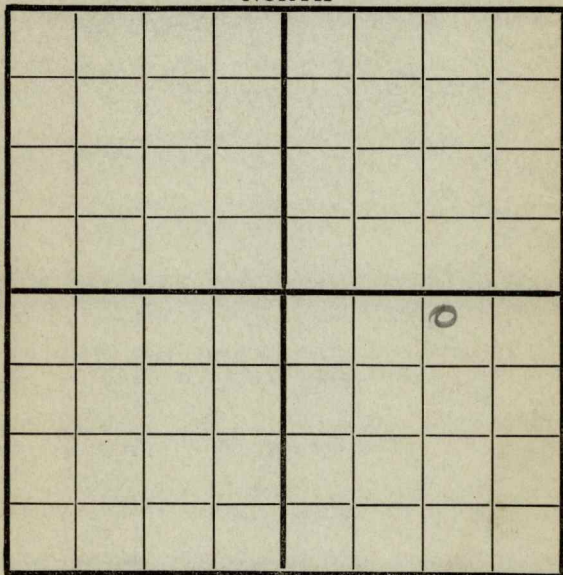

SOUTH

Location _____

Rig up _____

Drilling and Remarks:

N. F. H.
@
2100'

RECORD

Cased _____ in., _____ ft.

Sand _____

Gas _____

Oil _____

Total Depth _____

PRODUCTION

1st 24 hrs. Nat. _____

1st 24 hrs. after shot _____

Gas _____ Cu. Ft.

Dry Hole _____

Abandoned _____

Date

7/20 1918

Oyle Scout

Map No. _____ Sec. 12 Twp. 26 R. 8Well No. 1 CaseFlint Hill Out Company

Contractor _____

NORTH

WEST

EAST

SOUTH

Location _____

Rig up _____

Drilling and Remarks:

RECORD

Cased _____ in., _____ ft.

Sand _____

Gas _____

Oil _____

Total Depth _____

PRODUCTION

1st 24 hrs. Nat. _____

1st 24 hrs. after shot _____

Gas _____ Cu. Ft.

Dry Hole _____

Abandoned _____

Date

191

Scout

Map No. _____ Sec. 12 Twp. 26 R. 8
 Well No. 1 Susan Rose
Flinch Hill Company _____
 Contractor _____

NORTH							
WEST							
SOUTH							

Location 250' N
 Rig up 1070' E
 Drilling and Remarks:

D. 10 @
2500'

RECORD

Cased _____ in., _____ ft.
 Sand _____
 Gas _____
 Oil _____
 Total Depth _____

PRODUCTION

1st 24 hrs. Nat. _____
 1st 24 hrs. after shot _____
 Gas _____ Cu. Ft.
 Dry Hole _____
 Abandoned _____


Date 8/3 1918 Cyle Scout

Map No. K 15 Sec. 12 Twp. 26 R. 8
 Well No. 1 Susan Rose
Flint Hill Pit Company _____ Contractor _____

NORTH

WEST

EAST

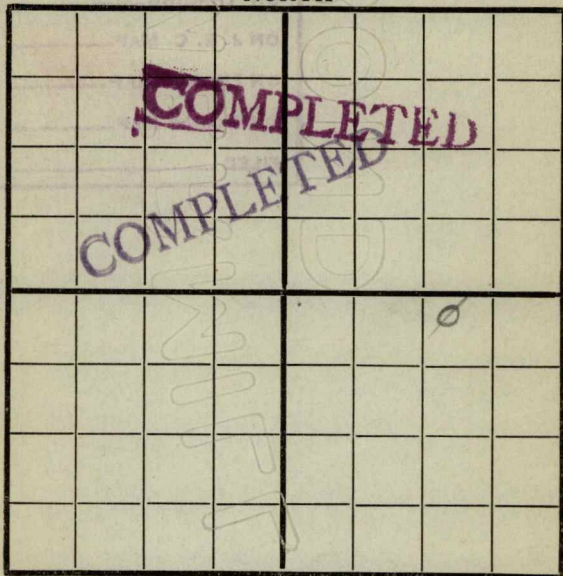

SOUTH

Location _____

Rig up _____

Drilling and Remarks:

RECORD

Cased _____ in., _____ ft.

Sand _____

Gas _____

Oil _____

Total Depth _____

PRODUCTION

1st 24 hrs. Nat. _____

1st 24 hrs. after shot _____

Gas _____ Cu. Ft.

Dry Hole 2570 _____

Abandoned _____

Date

8/15 1918 Cyle Scout