


Map No. \_\_\_\_\_ Sec. 19 Twp. 26 R. 5  
 Well No. 13 Houston Farm \_\_\_\_\_  
Empire G. & L. Company

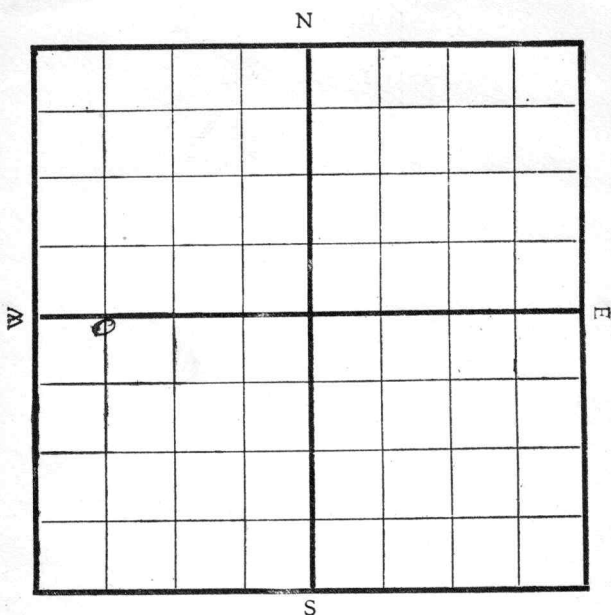

Location \_\_\_\_\_

Drilling Remarks:

Rig Up \_\_\_\_\_

Drilling Remarks:

COMPLETED

## RECORD

Cased \_\_\_\_\_ in. \_\_\_\_\_ ft.

Sand \_\_\_\_\_

Gas \_\_\_\_\_

Oil \_\_\_\_\_

Total Depth \_\_\_\_\_

## PRODUCTION

1st 24 hrs. Nat. \_\_\_\_\_

1st 24 hrs. after shot \_\_\_\_\_

Gas \_\_\_\_\_ cu. ft.

Dry Hole \_\_\_\_\_

Abandoned \_\_\_\_\_

Map No. \_\_\_\_\_ Sec. 19 Twp. 26 R. 5

Well No. 13. Houston Farm  
Empire Gas & Oil Co. Company


Contractor \_\_\_\_\_  
SW Quarter

196 Ft. from N. Line

\_\_\_\_\_ Ft. from S. Line

\_\_\_\_\_ Ft. from E. Line

660 Ft. from W. Line

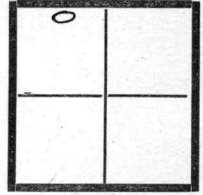

REPORT

FIRST REPORT

10/19/19  
10/29  
11/1/19  
4/14

Pz up.  
R.  
Sand 2619-37 2 bbls  
Pumped off 1 hr.

COMPLETED

Map No. K 14 Sec. 19 Twp. 26 R. 5Well No. 13 HoustonEmpire Company

Contractor

## SECTION PLAT

196 Ft. from N. Line

Ft. from S. Line

Ft. from E. Line

660 Ft. from W. Line

|  |  |  |  |
|--|--|--|--|
|  |  |  |  |
|  |  |  |  |
|  |  |  |  |
|  |  |  |  |

Location

Rig up ☒

Drilling and Remarks:

## RECORD

Cased \_\_\_\_\_ in., \_\_\_\_\_ ft.

Sand \_\_\_\_\_

Gas \_\_\_\_\_

Oil \_\_\_\_\_

Total Depth \_\_\_\_\_

## PRODUCTION

1st 24 hrs. Nat. \_\_\_\_\_

1st 24 hrs. after shot \_\_\_\_\_

Gas \_\_\_\_\_ Cu. Ft.

Dry Hole \_\_\_\_\_

Abandoned \_\_\_\_\_


Date

Pyle

10/29 1919

Scout

Map No. K14 Sec. 19 Twp. 26 R. 5  
 Well No. 13 Houston Farm  
Empire Company  
 Date Started \_\_\_\_\_ Ft. from N 196 S 668 E \_\_\_\_\_ W \_\_\_\_\_ line  
**NORTH**

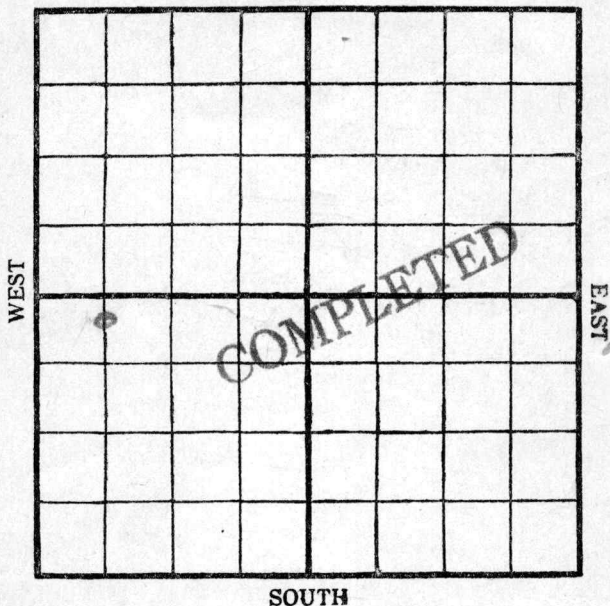

Cased \_\_\_\_\_ In. \_\_\_\_\_ Ft.

Sand 2619 - 37

Pay { Gas \_\_\_\_\_

{ Oil \_\_\_\_\_

Total Depth \_\_\_\_\_

Production Remarks

2 bbls  
Pumped off 1 hr

Condition of Well on this date \_\_\_\_\_

4/14

**Pyle**

Scout