

WEST

EAST


SOUTH COMPLETED

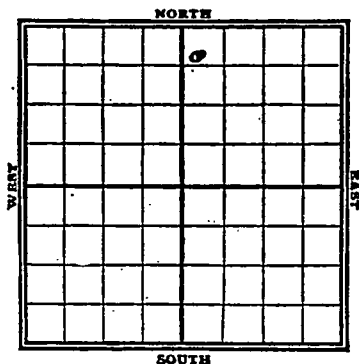
[illegible][illegible]

1st 24 hrs. Nat. _____
1st 24 hrs. after shot _____
Gas _____ cu. ft.
Dry Hole _____
Abandoned _____


_____ Ft. from S. Line

_____ Ft. from E. Line

200 Ft. from W. Line

Date

REPORT

FIRST DEPT.

1940

8/13

Timber

8/21

Rig

7/27

Run up

9/13

Spud

9/11

all @ 1040'

22

2 @ 1465'

29

✓ 2040

10/10

2389-2423-2453-2512

300 bbb.

K15

State _____ County _____

Sec. 16 Twp. 26 N-S; Rge. 8 E-WWell No. 3 Dickinson FarmTidal & Southern Company

NORTH

WEST

EAST

FIRST REPORT

SOUTH

600 N

200 W

Location _____

Cased _____ in. _____ ft.

Rig up _____ Mach. _____

Productive Horizons

From _____ To _____

Drilling at _____

Fishing at _____

U. R. to _____

S. D. at _____

Natural production _____ Bbls. per _____ hours

Pumping _____ Gas _____ Cu. ft. per 24 hours

Gauge press. _____ lbs. Total depth _____

Were samples collected _____

Remarks:

Pyle

Map No. K15 Sec. 16 Twp. 26 R. 8Well No. 3 DickinsonTidal & Southern Company

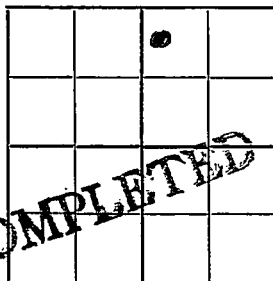
Contractor

SECTION PLAT

600 Ft. from N. Line

_____ Ft. from S. Line

_____ Ft. from E. Line

200 Ft. from W. Line

Location _____

Rig up _____

Drilling and Remarks:

Sands { 2389-2423
2453-2512

RECORD

Cased _____ in., _____ ft.

Sand _____

Gas _____

Oil _____

Total Depth _____

PRODUCTION

1st 24 hrs. Nat. 300 bbls

1st 24 hrs. after shot _____

Gas _____ Cu. Ft.

Dry Hole _____

Abandoned _____

Date

10/20 1920

Pyle Scout