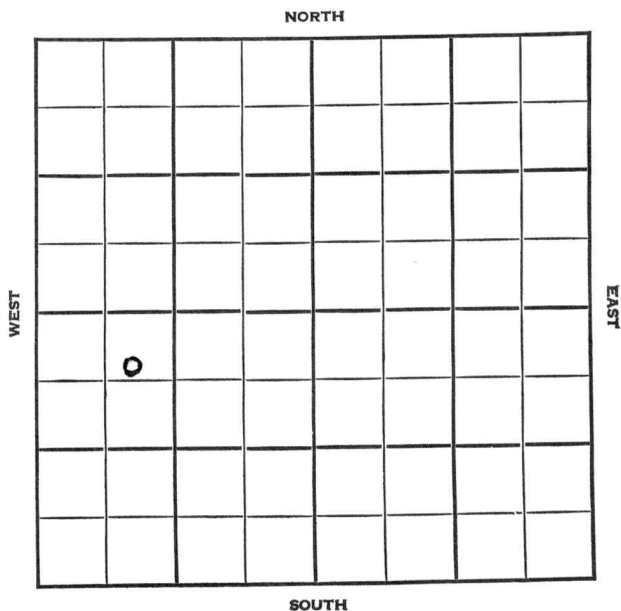


Section 19 Township 26 Range 5-EWell No. #22 HoustonCompany Cities Service

Butler
5E

Sec. 19 Twp. 26 R. _____

Well No. #22 Houston Farm _____

Cities Service Company _____

Miscellaneous


600' Ft. from N. Line

_____ Ft. from S. Line

_____ Ft. from E. Line

800' Ft. from W. Line

C E L NW SW

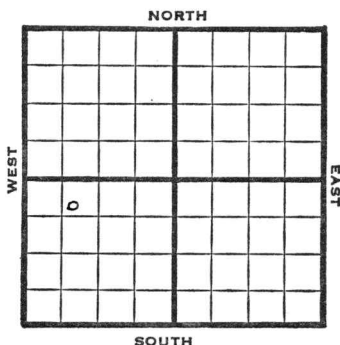

1948 El 1368'

REPORT

5/5 8" @ 82'
WOC

5/12 KC 2095'
Drlg. 2558'

5/19 Viola 2631'
TD 2633'
5" @ 2632'

5/26 TD 2705'

6/1 Simpson 2629'
Arbuckle 2702'
PB 2675'
3 qts. 2639-75'
CO

6/9 "

6/16 "

6/23 T^u 2705'
Arb. 2702'
5"@ 2032'
Pump 12 oil / 16 W pot
38° Gr.
Comp

COMPLETED

Map No. _____ Sec. 19 Twp. 26 R. 5E

Well No. 22 Houston

Cities Service Company

FIRST REPORT Contractor

C E L NW SW

SECTION PLAT

600 Ft. from N. Line

_____ Ft. from S. Line

_____ Ft. from E. Line

800 Ft. from W. Line

Butler County

Location _____

Rig up _____

Drilling and Remarks:

8" @ 82 WOC

RECORD

Cased _____ in., _____ ft.

Sand _____

Gas _____

Oil _____

Total Depth _____

PRODUCTION

1st 24 hrs. Nat. _____

1st 24 hrs. after shot _____

Gas _____ Cu. Ft.

Dry Hole _____

Abandoned _____

Date

MAY 5 1948

19

S. J. LEWIS Scout

Form 26—200 Bks.—1-48—Palace
Kansas

Map No. 14 Sec. 19 Twp. 26 R. 5E

Well No. 22 Houston

Cities Service Company

COMPLETE

Contractor

C E L NW SW

E 1/368
SECTION PLAT

600 Ft. from N. Line

 Ft. from S. Line

 Ft. from E. Line

800 Ft. from W. Line

Butler County

Location

Rig up

Drilling and Remarks:

Art 2702

5" 2632

Pump 12 oil + 16 W
BD

38° S

RECORD

Cased in., ft.

Sand

Gas

Oil

Total Depth 2705

PRODUCTION

1st 24 hrs. Nat.

1st 24 hrs. after shot

Gas Cu. Ft.

Dry Hole

Abandoned

Date

JUN 23 1948 19

S. J. LEWIS

Scout