


Map No. _____ Sec. 3 Twp. 26 R. 5Well No. 5- Criner Farm __________
Carter Company _____

NORTH

WEST

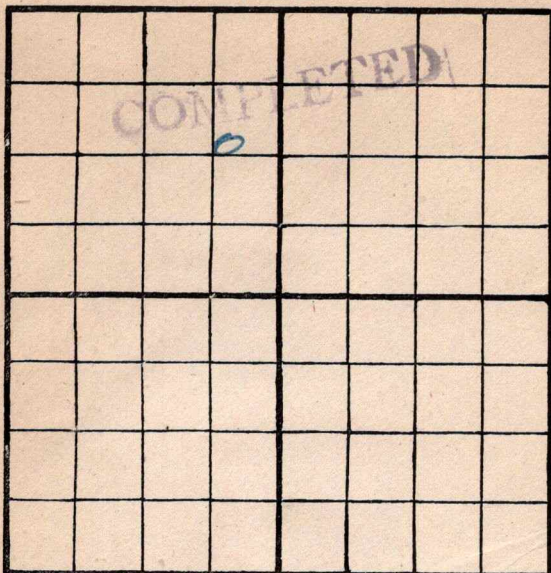

EAST

SOUTH

Location _____

Rig Up _____

Drilling Remarks:

Drilling Remarks:

RECORD

Cased _____ in. _____ ft.

Sand _____

Gas _____

Oil _____

Total Depth _____

PRODUCTION

1st 24 hrs. Nat. _____

1st 24 hrs. after shot _____

Gas _____ cu. ft

Dry Hole _____


Abandoned _____

Map No. L-1004 K-14 Sec. 3 Twp. 76 R. 5
 Well No. 5. Criner Farm
Carter Company

NORTH

WEST

EAST

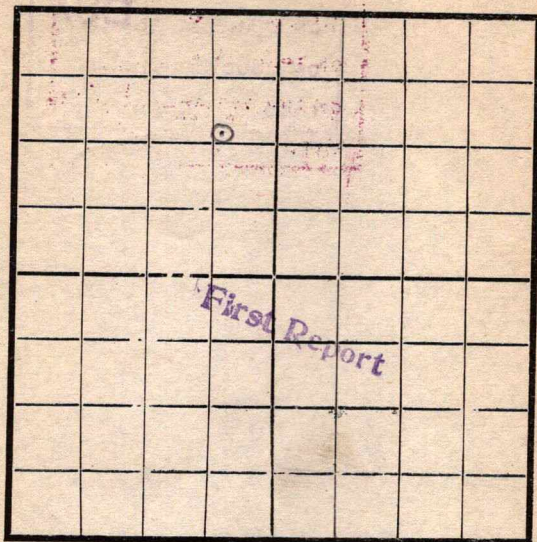

SOUTH

Location -----
 Rig Up ☒ -----
 Drilling and remarks -----

RECORD

Cased ----- in. ----- Ft. 1
 Sand -----
 Gas -----
 Oil -----
 Total Depth -----

PRODUCTION

1st 24 hrs. Nat. -----
 1st 24 hrs. after shot -----
 Gas ----- Cu. Ft. 5
 Dry Hole -----
 Abandoned -----

Date

8-23, 1917

Lantz

Scout

Map No. _____ Sec. 3 Twp. 26 R. 5

Well No. 5 Quince Farm _____
Porter Company _____

NORTH

WEST

EAST

SOUTH

Location _____

Rig up _____

Drilling and remarks:

2150

RECORD

Cased _____ in. _____ Ft.

Sand _____

Gas _____

Oil _____

Total Depth _____

PRODUCTION

1st 24 hrs. Nat. _____

1st 24 hrs. after shot _____

Gas _____ Cu. Ft.

Dry Hole _____

Abandoned _____


Date

10/9, 1917, Landry Scout

Map No. _____ Sec. 3 Twp. 26 R. 5
 Well No. 5 Criner Farm _____
Carter Company _____

NORTH

WEST

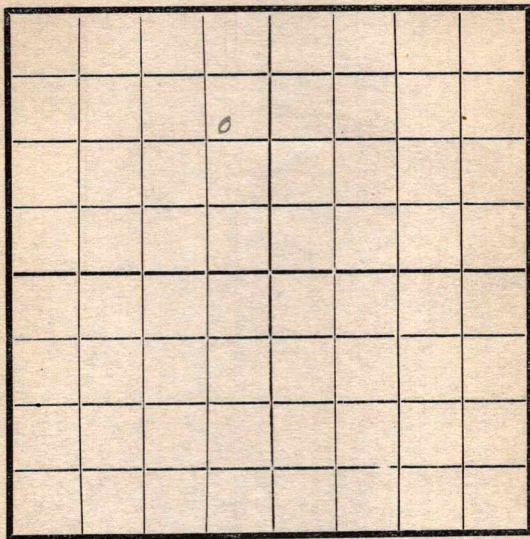

EAST

SOUTH

Location _____
 Rig Up _____
 Drilling and remarks

2285

RECORD

Cased _____ in. _____ Ft.
 Sand _____
 Gas _____
 Oil _____
 Total Depth _____

PRODUCTION

1st 24 hrs. Nat. _____
 1st 24 hrs. after shot _____
 Gas _____ Cu. Ft.
 Dry Hole _____
 Abandoned _____

Date


10/7, 1917 Carter Scout

Map No. _____ Sec. 3 Twp. 26 R. 5Well No. 5 Criner Farm _____

Company _____

NORTH

WEST

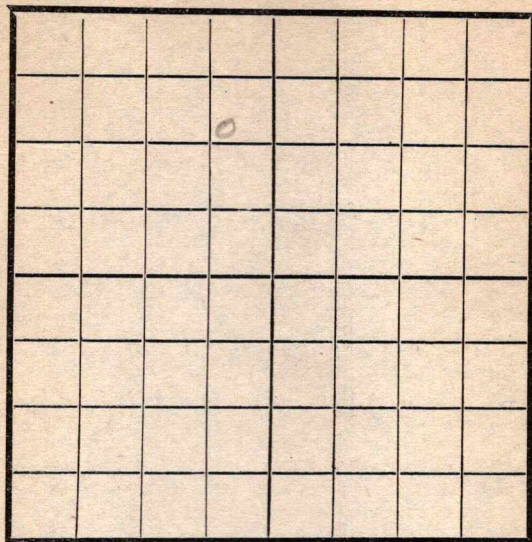

EAST

SOUTH

Location _____

Rig Up _____

Drilling and remarks

2310

RECORD

Cased _____ in. _____ Ft.

Sand _____

Gas _____

Oil _____

Total Depth _____

PRODUCTION

1st 24 hrs. Nat. _____

1st 24 hrs. after shot _____

Gas _____ Cu. Ft.

Dry Hole _____

Abandoned _____

Date


10/24, 1917Scout Cordiff

Map No. _____ Sec. 3 Twp. 26 R. 5
 Well No. 5 Crimmer Farm _____
Carter Company _____

NORTH

WEST

EAST

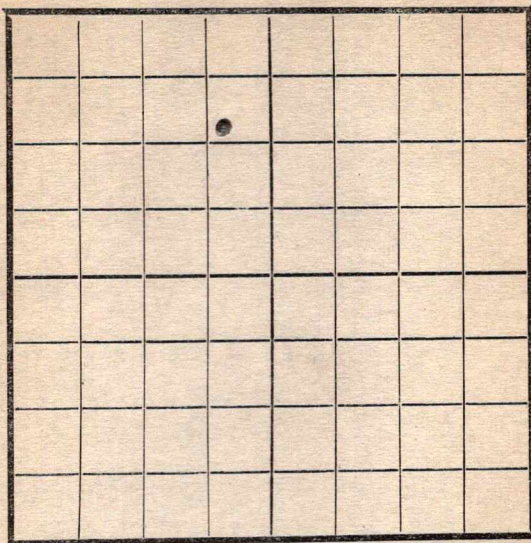

SOUTH

RECORD

Location _____
 Rig Up _____
 Drilling and remarks _____

Cased _____ in. _____ Ft.
 Sand _____
 Gas _____
 Oil _____
 Total Depth _____

PRODUCTION

1st 24 hrs. Nat. _____
 1st 24 hrs. after shot _____
 Gas _____ Cu. Ft.
 Dry Hole _____
 Abandoned _____

S. N. 2310'

Date

11-3, 1917 Pyle Scout

Map No. _____ Sec. 3 Twp. 26 R. 5Well No. 5 Crimmer Farm _____Easter Company _____

NORTH

WEST

EAST

SOUTH

Location _____

Rig Up _____

Drilling and remarks

fishing
2315

RECORD

Cased _____ in. _____ Ft.

Sand _____

Gas _____

Oil _____

Total Depth _____

PRODUCTION

1st 24 hrs. Nat. _____

1st 24 hrs. after shot _____

Gas _____ Cu. Ft.

Dry Hole _____

Abandoned _____


Date

11/7 1917Pyle Scout

Map No. _____ Sec. 3 Twp. 26 R. 5
 Well No. 5 Crinet Farm _____
Carter Company _____

NORTH

WEST

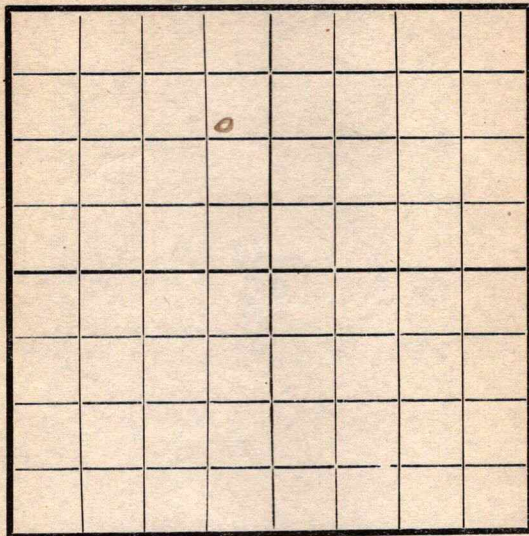

EAST

SOUTH

Location _____

Rig Up _____

Drilling and remarks

Set 6"
@ 2533'

RECORD

Cased _____ in _____ Ft.

Sand _____

Gas _____

Oil _____

Total Depth _____

PRODUCTION

1st 24 hrs. Nat. _____

1st 24 hrs. after shot _____

Gas _____ Cu. Ft.

Dry Hole _____

Abandoned _____


Date

11/4, 191*7* *Pyle* Scout _____

Map No. _____ Sec. 3 Twp. 26 R. 5
 Well No. 5 Criner Farm _____
Carter Company _____

NORTH

WEST

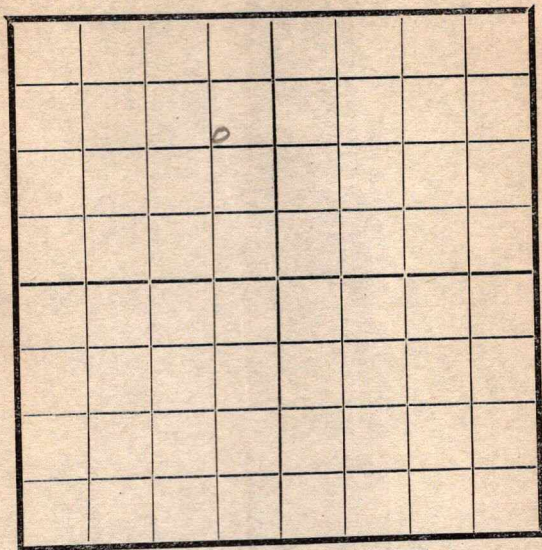

EAST

SOUTH

Location _____
 Rig Up _____
 Drilling and remarks

2700'

RECORD

Cased _____ in _____ Ft.
 Sand _____
 Gas _____
 Oil _____
 Total Depth _____

PRODUCTION

1st 24 hrs. Nat. _____
 1st 24 hrs. after shot _____
 Gas _____ Cu. Ft.
 Dry Hole _____
 Abandoned _____

Date


11/22, 1917

Pyle Scout

Map No. _____ Sec. 3 Twp. 26 R. 5Well No. 5 Criner Farm
Carlier Company

NORTH

WEST

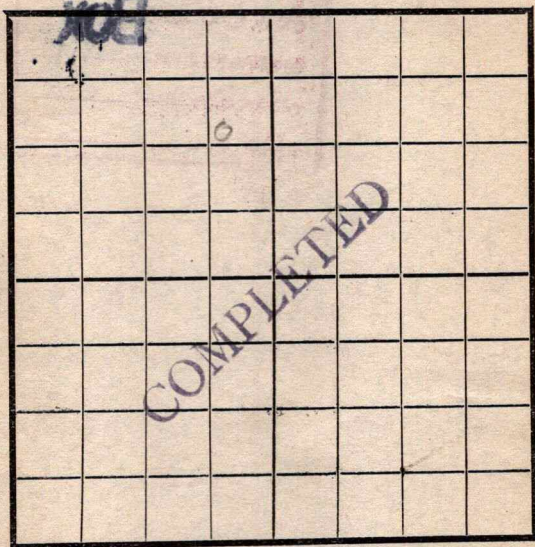

EAST

SOUTH

Location _____

Rig Up _____

Drilling and remarks _____

RECORD

Cased _____ in _____ Ft.

Sand 2763-2780

Gas _____

Oil 30 bbls

Total Depth _____

PRODUCTION

1st 24 hrs. Nat. _____

1st 24 hrs. after shot _____

Gas _____ Cu. Ft.

Dry Hole _____

Abandoned _____

Date

11/28, 1917 Dyer Scout

3-24-5

