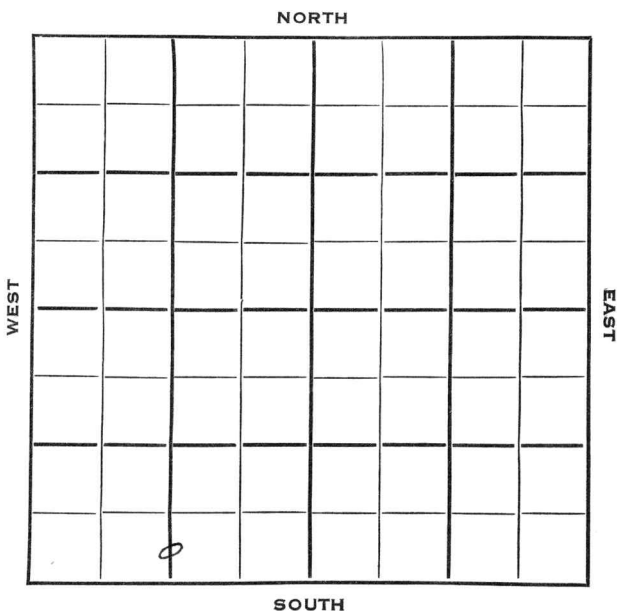



Section 19 Township 26 Range 5EWell No. #25 HoustonCompany Cities Service Company

Butler

KANSAS

Sec. 19 Twp. 26 R. 5EWell No. #25 Houston FarmCities Service Oil Company Company Contractor Ft. from N. Line126 Ft. from S. Line Ft. from E. Line1230 Ft. from W. Line

C S/2 S/2 SW

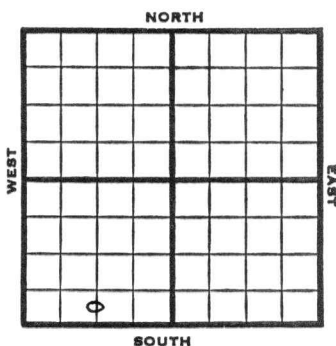

1953 Elev. 1346' REPORT


3/11 10" @ 126  
Drlg. 1723

4/8 TD 2690'  
 10" @ 126  
 Viola 2629, Simp 2648  
 TD 2651  
 7" @ 2650  
 DD 2690, 2½ bo 5 bw 1 hr.  
 E/12 bo 120 bw 24 hrs.  
 60/2629-44, 1500A  
 Comp. 29 bopd 111 bw

COMPLETED

~~J. G. McGEHEE~~

County Butler State Kansas  
 Sec. 19 (Blk. 26 (Sur. 5E Map No.  
 (Twp. (Rge.)  
 Operator Cities Service  
 Well No. 25 Farm Houston  
 Elev. 1346 Location C S $\frac{1}{2}$  S $\frac{1}{2}$  SW

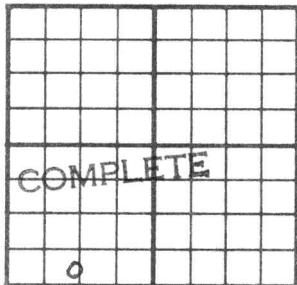

126 Ft. From S Line SW  
1230 Ft. From W Line Quarter

1st. Report

Completion APR 8 1959

Remarks

Spudding Date

Drlg. Data Oil well TD 2690

10" @ 126 Viola 2629 Simp. 2648

TD 2651 7" @ 2650 DD 2690 2 $\frac{1}{2}$  bo

5 bw 1 hr. P/ 12 bo 120 bw 24 hr.

60/ 2629-44 1500 A

Comp. 29 bopd 111 bw