
Form 51-10M-7-50-CroMac

Map No. K-15 Sec. 16 Twp. 26 R. 8

Well No. 3 Liggett Farm

Roysdon Et al Company

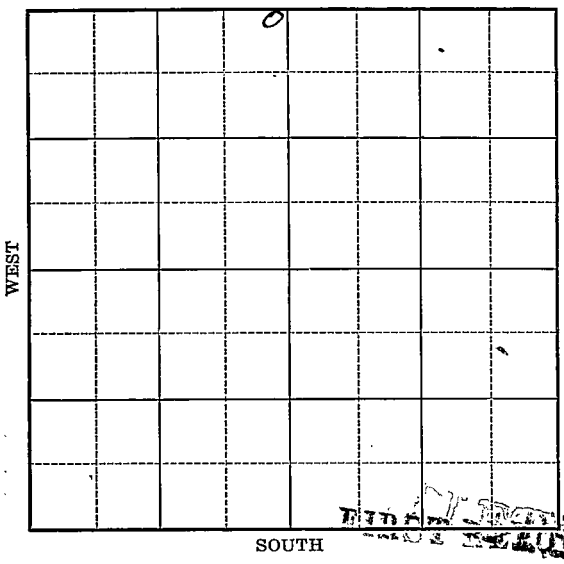


Location	Rig Up
Drilling Remarks:	Drilling Remarks:
RECORD	PRODUCTION
Cased ____ in. ____ ft.	1st 24 hrs. Nat.
Sand	1st 24 hrs. after shot
Gas	Gas ____ cu. ft.
Oil	Dry Hole
Total Depth	Abandoned

Form 252A—6M-3-20-CroMac

Map No. K. 11 Sec. 16 Twp. 26 R. 8

Well No. 2 Liggett Farm

Royse Et al Company

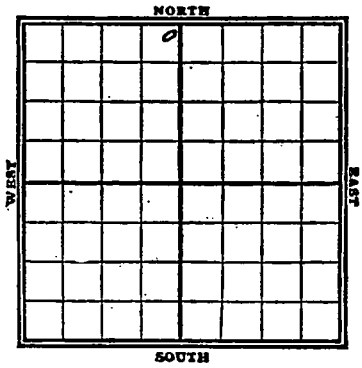

190 Ft. from N. Line

_____ Ft. from S. Line

200 Ft. srom E. Line

_____ Ft from W. Line

Date 1920	FREPORT REPORT
8/13	Rig up.
8/20	Tools
9/27	Ryan up
9/3	Spud
9/11	Dly 650
22	Spud 650'
29	Dly 30
1921	
1/21	2484- 2545'
	250 bbls.

COMPLETED


K15

State _____ County _____

Sec. 16 Twp. 26 N-S, Rge. 8 E-W

Well No. 2 Liggett Farm

Rogers et al Company

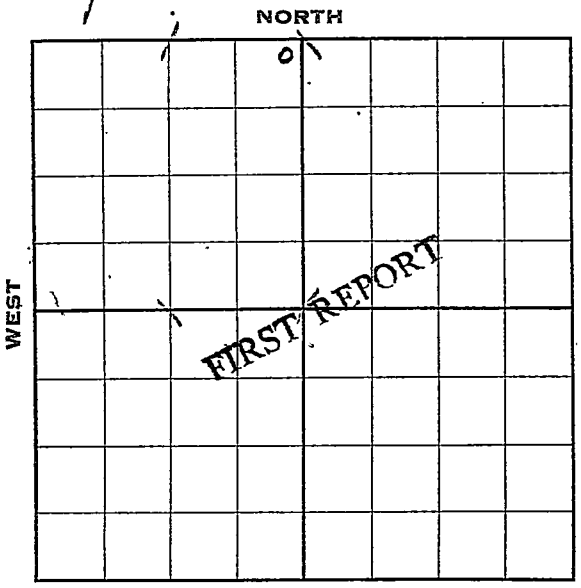

120 N 200 E

Location _____

Rig up ✓ Mach.

Drilling at _____

Fishing at _____

U. R. to _____

S. D. at _____

Cased _____ in. _____ ft.

Productive Horizons

From	To

Natural production _____ Bbls. per _____ hours

Pumping _____ Gas _____ Cu. ft. per 24 hours

Gauge press. _____ lbs. Total depth _____

Were samples collected _____

Remarks:

Pyle

8/13 1920

_____ Scout

S. C. 9-1M-11-19. 29023

(Over)

Form 26—1M—4-19—Mid-West


Map No. K15 Sec. 16 Twp. 26 R. 8

Well No. 2 Liggett

Rogers et al Company

Contractor

SECTION PLAT

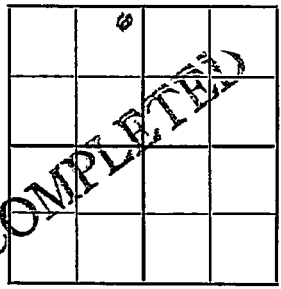

120 Ft. from N. Line

— Ft. from S. Line

200 Ft. from E. Line

Ft. from W. Line

Location

Rig up

Drilling and Remarks:

RECORD

Cased in., ft.

Sand 2484 - 2545

Gas

Oil

Total Depth

PRODUCTION

1st 24 hrs. Nat. 250 bbls

1st 24 hrs. after shot

Gas Cu. Ft.

Dry Hole

Abandoned

Date

11/21 1920 HBP Scout