


Map No. 75 Sec. 16 Twp. 26 R. 8
 Well No. 4 Leggett Farm
Merriman & Henderson Company

N

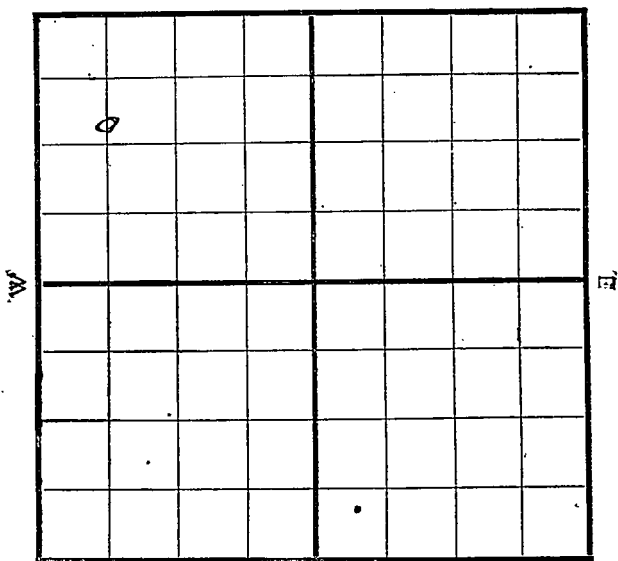

S

Location -----

Drilling Remarks:

Rig Up -----

Drilling Remarks:

RECORD

Cased ----- in. ----- ft.

Sand -----

Gas -----

Oil -----

Total Depth -----

PRODUCTION

1st 24 hrs. Nat. -----

1st 24 hrs. after shot -----

Gas ----- cu. ft.

Dry Hole -----

Abandoned -----

Map No. _____ Sec. 16 Twp. 26 R. 8Well No. 4 Sigelt Farm _____
Merriman & Funder Company

NORTH

1120 Ft. from N. Line

_____ Ft. from S. Line

_____ Ft. from E. Line

660 Ft. from W. Line

WEST

EAST

SOUTH

Date

REPORT

7/9/224/15 Sand dune2/4 220 12003/26 Sand 2490-2552. Shot
60 gts. Making 30 lbs.

Map No. K15 Sec. 16 Twp. 26 R. 8
 Well No. 4 Liggett
Merrimack & Feindless Company.
1120 from N. NORTH 660' from W.

WEST EAST

SOUTH

Spud Report

Location _____

Rig up _____

Drilling and Remarks:

RECORD

Cased _____ in., _____ ft.

Sand _____

Gas _____

Oil _____

Total Depth _____

PRODUCTION

1st 24 hrs. Nat. _____

1st 24 hrs. after shot _____

Gas _____ Cu. Ft.

Dry Hole _____

Abandoned _____

State KansasDate 1/15192 2Scout W. B.

Map No. K 15 Sec 16 Twp. 36 R. 8Well No. 4 LiggettMerriman-Field Company

Contractor

COMPLETED SECTION PLAT1120' Ft. from N. Line

_____ Ft. from S. Line

_____ Ft. from E. Line

660' Ft. from W. Line

6			

Location _____

Rig up _____

Drilling and Remarks:

sand 2490'
2552'
shot 609 to
making 30
ftls.

RECORD

Cased _____ in., _____ ft.

Sand _____

Gas _____

Oil _____

Total Depth _____

PRODUCTION

1st 24 hrs. Nat. _____

1st 24 hrs. after shot _____

Gas _____ Cu. Ft.

Dry Hole _____

Abandoned _____

Date

MAR 26 1922M. A. BENEAR

Scout