


Map No. KANSAS Sec. 19 Twp. 26 R. 8EWell No. 51-Overstreet Farm Mohawk Oil Company

NORTH

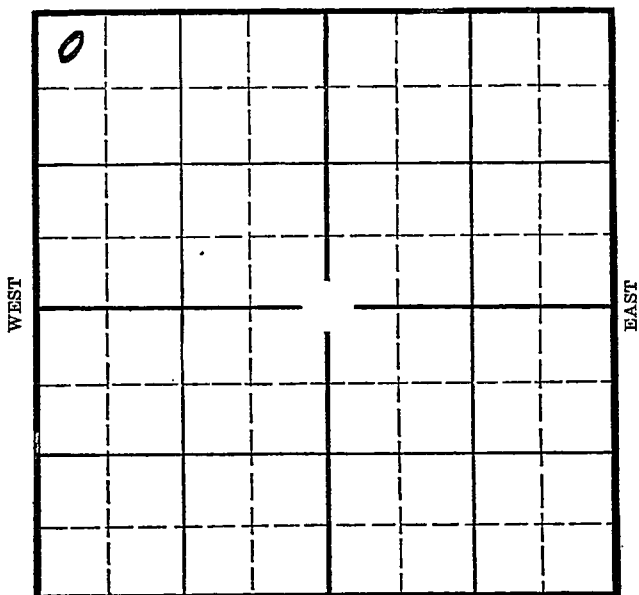

SOUTH

Location _____
Drilling Remarks _____Rig Up _____
Drilling Remarks _____

RECORD

Cased _____ in. _____ ft.

Sand _____

Gas _____

Oil _____

Total Depth _____

PRODUCTION

1st 24 hrs. Nat. _____

1st 24 hrs. after shot _____


Gas _____ cu. ft. _____

Dry Hole _____

Abandoned _____

Map No. KANSAS Sec. 19 Twp. 26 R. 8E
Well No. 1-Overstreet Farm
Mohawk Oil Company

330 Ft. from N. Line
 Ft. from S. Line
 Ft. from E. Line
330 Ft. from W. Line

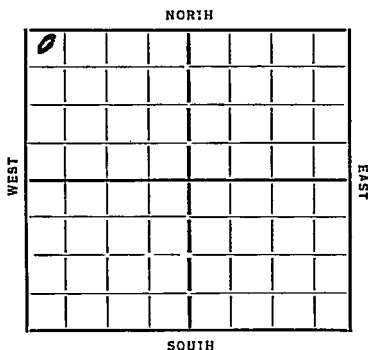

Date	REPORT
1935	
8/28	12" 555
9/6	dly 555
10/3	8" 1900 16C 2052 Run 6"
10/10	Oil 2058-67 40 Hbls
	Acidize
10/30	16 CC 2054
	Oil 2058-67
	TD 2067
	1000 acid
	100 Hbls.

COMPLETED

KANSAS

Map No. 15 Sec. 19 Twp. 26 R. 8 EWell No. 1- OverstreetMohawk Oil Company

Contractor

SECTION PLAT

0			

330 Ft. from N. Line

.....Ft. from S. Line

.....Ft. from E. Line

330 Ft. from W. Line

Location.....

Rig up.....

Drilling and Remarks:

12 1/2 555

RECORD

Cased.....in.,ft.

Sand.....

Gas.....

Oil.....

Total Depth.....

PRODUCTION

1st 24 hrs. Nat.....

1st 24 hrs. after shot.....

Gas.....Cu. Ft.

Dry Hole.....

Abandoned.....

Date

8-28-35 192ORVAL MANNSCHRECK
Scout

KANSAS

Map No. 15 Sec. 19 Twp. 26 R. 8 EWell No. 1-OverstreetMohawk oil Company

Contractor

COMPLETED

SECTION PLAT

330 Ft. from N. Line

Ft. from S. Line

Ft. from E. Line

330 Ft. from W. Line

0			

Location

Rig up

Drilling and Remarks:

1000 ft.100 bbls

RECORD

Cased in. ft.

Sand BCL 2054

Gas

Oil 2058-67Total Depth 2067

PRODUCTION

1st 24 hrs. Nat.

1st 24 hrs. after shot

Gas Cu. Ft.

Dry Hole

Abandoned

Date

10-30-35

192

ORVAL KANSCHRECK Scout