


Map No. _____ Sec. 20 Twp. 26 R. 8
 Well No. 2 Douley Farm
Cowpuncher's Oil Company

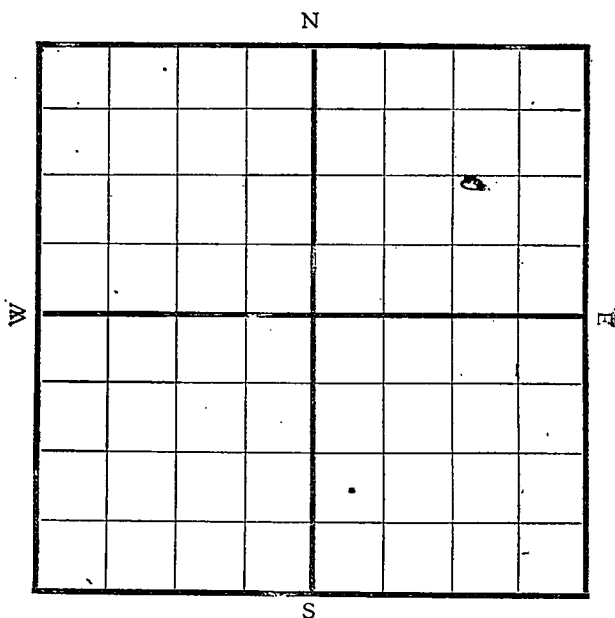

Location _____

Drilling Remarks:

Rig Up _____

Drilling Remarks:

COMPLETED

RECORD

Cased _____ in. _____ ft.

Sand _____

Gas _____

Oil _____

Total Depth _____

PRODUCTION

1st 24 hrs. Nat. _____

1st 24 hrs. after shot _____

Gas _____ cu. ft.

Dry Hole _____

Abandoned _____

Map No. _____ Sec. 20 Twp. 26 R. 8

Well No. 2 Dooley Farm


Cowpunches Oil Company

_____ Ft. from N. Line

1120 Ft. from S. Line

- 11.20 Ft. from E. Line

_____ Ft. from W. Line

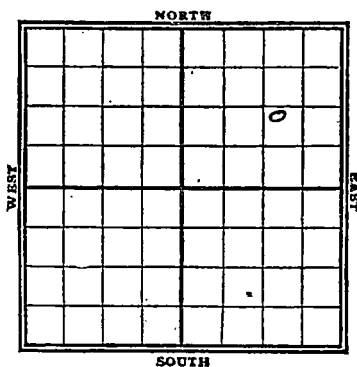

1920 Date	REPORT	FIRST REPORT
--------------	--------	--------------

3/8	Rig up.
12	

18	Rig
27	Rig

18	Rig
----	-----

27	Relig
----	-------

3/13	July 750
------	----------

30	✓	1/300
11		

4/10	50 1500.
------	----------

15	dry 2250
----	----------

24, Synd 2714 Short 150 ft
Set 15 fcs.

5/1 Band 2680-2714 T22 2780.

~~20/10~~ 150/20

COMPLETED

Map No. K15 Sec. 20 Twp. 26 R. 8
 Well No. 2 Dooley
Cowpunchers' Oil Company
 Contractor

SECTION PLAT

_____ Ft. from N. Line

1120 Ft. from S. Line

1120 Ft. from E. Line

_____ Ft. from W. Line

			o

FIRST REPORT

Location _____

Rig up ☒ _____

Drilling and Remarks:

RECORD

Cased _____ in., _____ ft.

Sand _____

Gas _____

Oil _____

Total Depth _____

PRODUCTION

1st 24 hrs. Nat. _____

1st 24 hrs. after shot _____

Gas _____ Cu. Ft.

Dry Hole _____

Abandoned _____

Date

Pyle

2/8 1920

Scout

Map No. K15 Sec. 20 Twp. 26 R. 8Well No. 2 WesleyCowhatchers Oil Company

Contractor

SECTION PLAT

Ft. from N. Line

1120 Ft. from S. Line1120 Ft. from E. Line

Ft. from W. Line

			e

COMPLETED

Location

Rig up

Drilling and Remarks:

Shot 150 qts

RECORD

Cased _____ in., _____ ft.

Sand 2680 - 2714

Gas _____

Oil _____

Total Depth 2730

PRODUCTION

1st 24 hrs. Nat. 20 bbls

1st 24 hrs. after shot _____

Gas _____ Cu. Ft.

Dry Hole _____

Abandoned _____

Date

5/1 191

Pyle

Scout