

Map No. _____ Sec. 3 Twp. 26 R. 5
Well No. 1 A - Proctor Farm _____
Hickory Company _____

NORTH

SOUTH

WEST EAST

COMPLETED

Location _____

Drilling Remarks:

RECORD

Cased _____ in. _____ ft.

Sand _____

Gas _____

Oil _____

Total Depth _____

Rig Up _____

Drilling Remarks:

PRODUCTION

1st 24 hrs. Nat. _____

1st 24 hrs. after shot _____

Gas _____ cu. ft

Dry Hole _____


Abandoned _____

Map No. _____ Sec. 3 Twp. 26 R. 5
 Well No. 2 Tract Farm _____
Kichory Company _____

NORTH

WEST

EAST

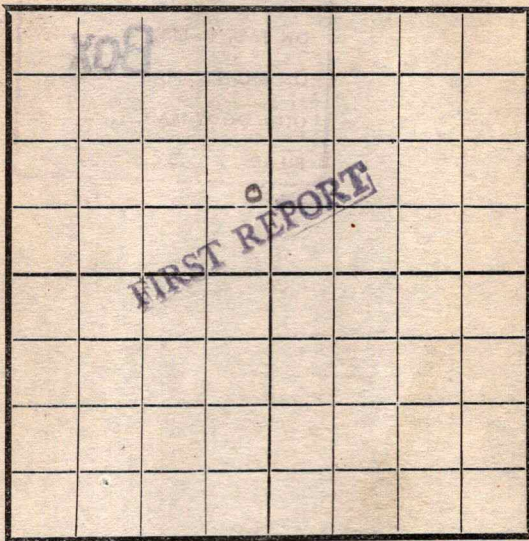

SOUTH

RECORD

Location _____
 Rig Up _____
 Drilling and remarks _____

Cased _____ in. _____ Ft.
 Sand _____
 Gas _____
 Oil _____
 Total Depth _____

PRODUCTION

1st 24 hrs. Nat. _____
 1st 24 hrs. after shot _____
 Gas _____ Cu. Ft.
 Dry Hole _____
 Abandoned _____


Date

11/6, 1917 Pyke Scout

Map No. _____ Sec. 3 Twp. 26 R. 5
 Well No. 2 Tract Farm _____
Hickory Company _____

NORTH

WEST

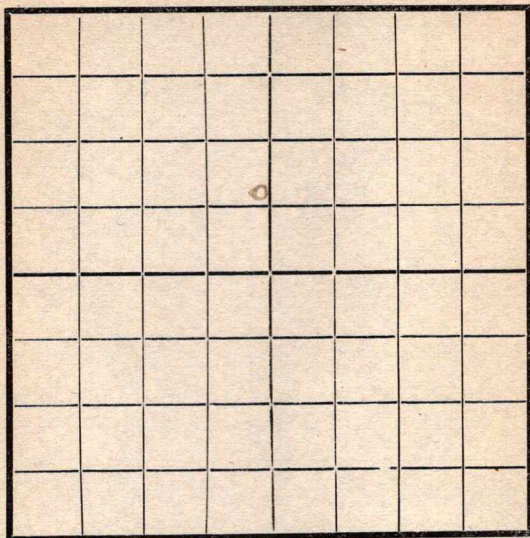

EAST

SOUTH

Location _____

Rig Up _____

Drilling and remarks

RECORD

Cased _____ in. _____ Ft.

Sand _____

Gas _____

Oil _____

Total Depth _____

PRODUCTION

1st 24 hrs. Nat. _____

1st 24 hrs. after shot _____

Gas _____ Cu. Ft.

Dry Hole _____

Abandoned _____

Date


11/14, 1917Pyle Scout

Map No. _____ Sec. 3 Twp. 26 R. 5Well No. 2 Track Farm _____

Company _____

NORTH

WEST

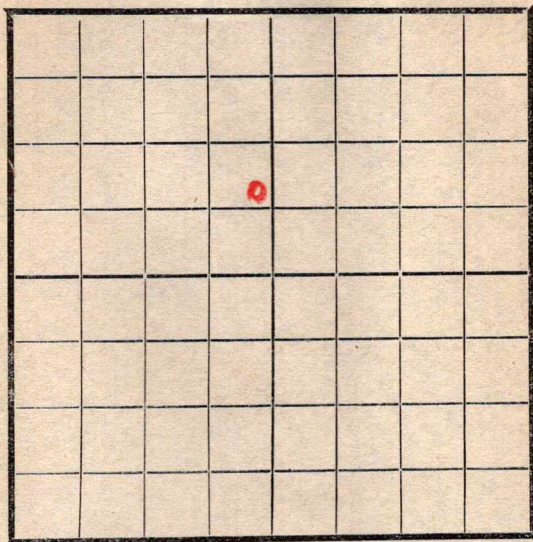

EAST

SOUTH

Location _____

Rig Up _____

Drilling and remarks

1000'

RECORD

Cased _____ in. _____ Ft.

Sand _____

Gas _____

Oil _____

Total Depth _____

PRODUCTION

1st 24 hrs. Nat. _____

1st 24 hrs. after shot _____

Gas _____ Cu. Ft.

Dry Hole _____

Abandoned _____

Date

11/22/1917

Pyle

Scout

Map No. _____ Sec. 3 Twp. 24 R. 5Well No. 2 Track Farm _____Hickory Company _____

NORTH

WEST

EAST

SOUTH

Location _____

Rig Up _____

Drilling and remarks

1075'

RECORD

Cased _____ in. _____ Ft.

Sand _____

Gas _____

Oil _____

Total Depth _____

PRODUCTION

1st 24 hrs. Nat. _____

1st 24 hrs. after shot _____

Gas _____ Cu. Ft.

Dry Hole _____

Abandoned _____

Date

11/27, 1917Pyle

Scout

Map No. _____ Sec. 3 Twp. 26 R. 5Well No. 2 Track Farm _____

Company _____

NORTH

WEST

EAST

SOUTH

Location _____

Rig Up _____

Drilling and remarks

1380'

RECORD

Cased _____ in. _____ Ft.

Sand _____

Gas _____

Oil _____

Total Depth _____

PRODUCTION

1st 24 hrs. Nat. _____

1st 24 hrs. after shot _____

Gas _____ Cu. Ft.

Dry Hole _____

Abandoned _____

Date


12/5, 1917

Pyle Scout

Map No. _____ Sec. 3 Twp. 26 R. 5Well No. 2 Trach Farm _____Kichory Company _____

NORTH

WEST

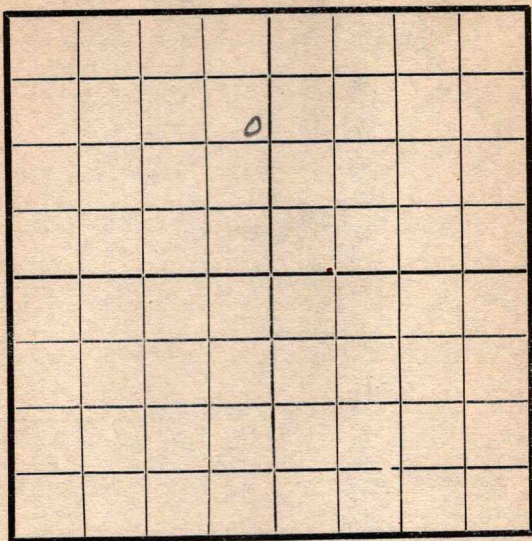

EAST

SOUTH

Location _____

Rig Up _____

Drilling and remarks

RECORD

Cased _____ in. _____ Ft.

Sand _____

Gas _____

Oil _____

Total Depth _____

PRODUCTION

1st 24 hrs. Nat. _____

1st 24 hrs. after shot _____

Gas _____ Cu. Ft.

Dry Hole _____


Abandoned _____

Date

12/11, 1917Cycle

Scout _____

Map No. _____ Sec. 3 Twp. 26 R. 5
 Well No. 2 Trach Farm _____
Hickory Company _____
 NORTH

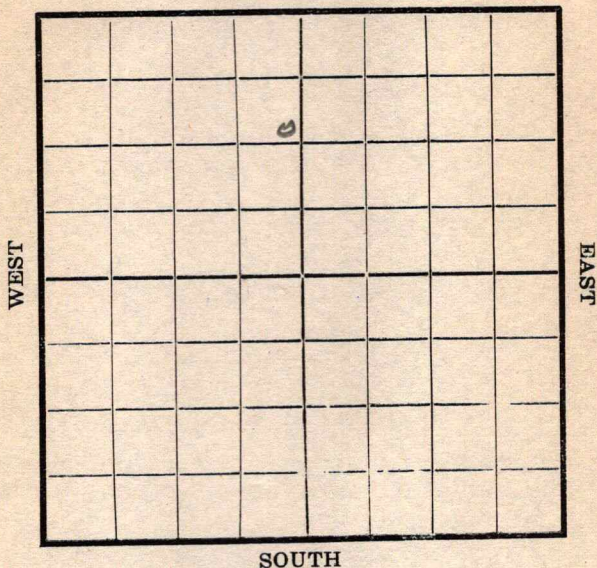

Location _____
 Rig Up _____
 Drilling and remarks

1500'

RECORD

Cased _____ in. _____ Ft.
 Sand _____
 Gas _____
 Oil _____
 Total Depth _____

PRODUCTION


1st 24 hrs. Nat. _____
 1st 24 hrs. after shot _____
 Gas _____ Cu. Ft.
 Dry Hole _____
 Abandoned _____

Date

12/27, 1917 Cyle Scout _____

Map No. _____ Sec. 3 Twp. 26 R. 5
Well No 2 Drach Farm _____
Hickory Company _____

NORTH

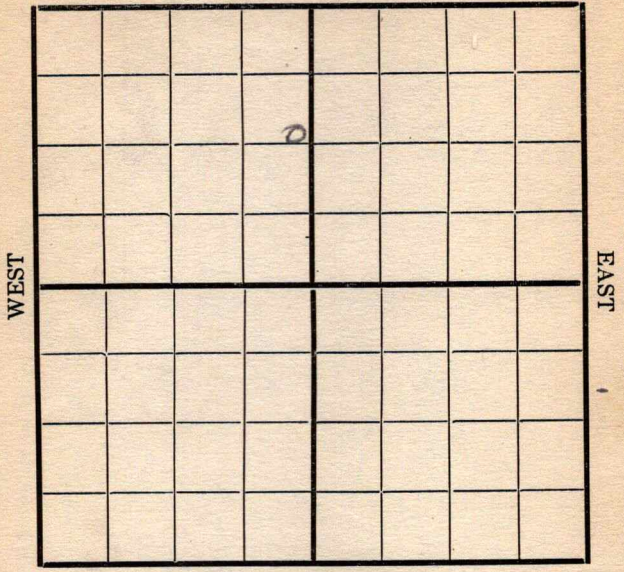

SOUTH

Location _____
Rig Up _____
Drilling and remarks _____

1570'

RECORD

Cased _____ in. _____ Ft.
Sand _____
Gas _____
Oil _____
Total Depth _____

PRODUCTION

1st 24 hrs. Nat. _____
1st 24 hrs. after shot _____
Gas _____ Cu. Ft.
Dry Hole _____
Abandoned _____

Date 1/8, 1918 Oyle Scout

Map No. _____ Sec. 3 Twp. 26 R. 5
 Well No. 2 Tract Farm _____
Hickory Company _____

NORTH

WEST

EAST

SOUTH

Location _____

Rig Up _____

Drilling and remarks

*fishing
for
pipe
@ 1570*

RECORD

Cased _____ in. _____ Ft.

Sand _____

Gas _____

Oil _____

Total Depth _____

PRODUCTION

1st 24 hrs. Nat. _____

1st 24 hrs. after shot _____

Gas _____ Cu. Ft.

Dry Hole _____

Abandoned _____


Date

1/25, 1918 Pyle Scout

Map No. _____ Sec. 3 Twp. 26 R. 5Well No. 2 Trach Farm _____
Hickory Company _____

NORTH

WEST

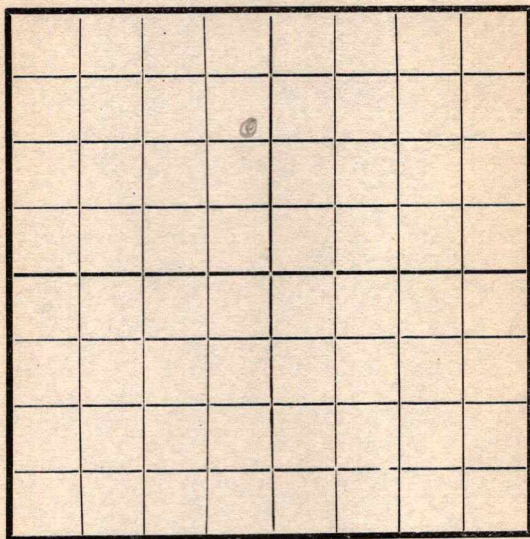

EAST

SOUTH

Location _____

Rig Up _____

Drilling and remarks

*fishing
for gas*

@

1570'

RECORD

Cased _____ in. _____ Ft.

Sand _____

Gas _____

Oil _____

Total Depth _____

PRODUCTION

1st 24 hrs. Nat. _____

1st 24 hrs. after shot _____

Gas _____ Cu. Ft.

Dry Hole _____

Abandoned _____


Date

1/30, 1918 *Oyle* Scout _____

Map No. _____ Sec. 3 Twp. 26 R. 5
Well No. 2 Tract Farm _____
Hickory Company _____

NORTH

WEST

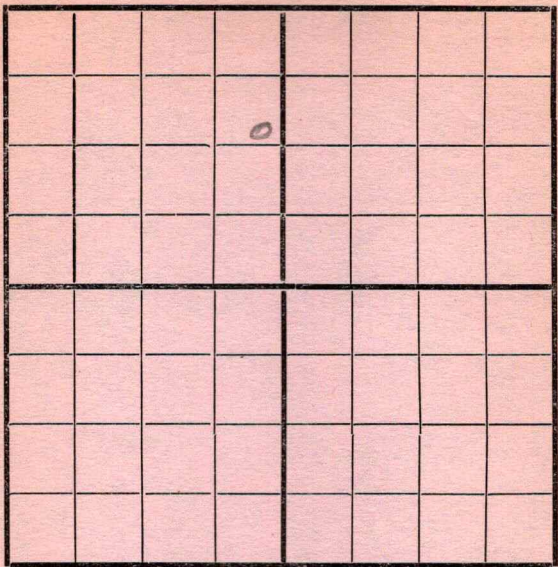

EAST

SOUTH

Location _____
Rig Up _____
Drilling and remarks _____

R. H.
@
1570'

RECORD

Cased _____ in. _____ Ft.
Sand _____
Gas _____
Oil _____
Total Depth _____

PRODUCTION


1st 24 hrs. Nat. _____
1st 24 hrs. after shot _____
Gas _____ Cu. Ft.
Dry Hole _____
Abandoned _____

Date 2/5 1918 Oyle Scout

Map No. _____ Sec. 3 Twp. 26 R. 5
 Well No. 2 Tract Farm _____
Hickory Company _____

NORTH

WEST

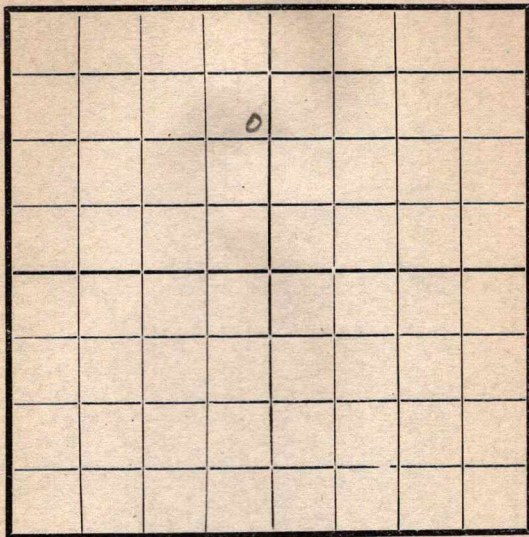

EAST

SOUTH

Location _____

Rig Up _____

Drilling and remarks

fishing
@
1570'

RECORD

Cased _____ in. _____ Ft.

Sand _____

Gas _____

Oil _____

Total Depth _____

PRODUCTION

1st 24 hrs. Nat. _____

1st 24 hrs. after shot _____

Gas _____ Cu. Ft.

Dry Hole _____

Abandoned _____

Date

2/12, 1918 Dyle Scout

Map No. _____ Sec. 3 Twp. 26 R. 5
 Well No. 2 Tract Farm _____
Pickover Company _____

NORTH

WEST

EAST

SOUTH

Location _____

Rig Up _____

Drilling and remarks _____

RECORD

Cased _____ in. _____ Ft.

Sand _____

Gas _____

Oil _____

Total Depth _____

PRODUCTION

1st 24 hrs. Nat. _____

1st 24 hrs. after shot _____

Gas _____ Cu. Ft.

Dry Hole _____

Abandoned _____

Date


191

Scout

Map No. _____ Sec. 3 Twp. 26 R. 5Well No. 2 Tract Farm _____Hickory Company _____

NORTH

WEST

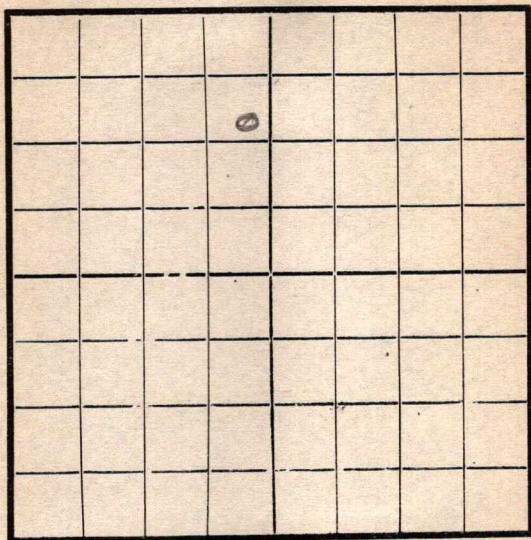

SOUTH

Location _____

Rig Up _____

Drilling and remarks

fristing
1570'

RECORD

Cased _____ in. _____ Ft.

Sand _____

Gas _____

Oil _____

Total Depth _____

PRODUCTION

1st 24 hrs. Nat. _____

1st 24 hrs. after shot _____

Gas _____ Cu. Ft.

Dry Hole _____

Abandoned _____

Date

2/27, 1918 Oyle Scout _____

Map No. _____ Sec. 3 Twp. 26 R. 5
 Well No. 2 Tract Farm _____
Hickory Company _____

NORTH

WEST

EAST

SOUTH

RECORD

Location _____

Cased _____ in. _____ Ft.

Rig Up _____

Sand _____

Drilling and remarks

Gas _____

Oil _____

Total Depth _____

PRODUCTION

1st 24 hrs. Nat. _____

1st 24 hrs. after shot _____

Gas _____ Cu. Ft.

Dry Hole _____

Abandoned _____


Date

3/6, 1918 P. H. Scout

Map No. _____ Sec. 3 Twp. 26 R. 5Well No. 2 Tract Farm _____Hickory Company _____

NORTH

WEST

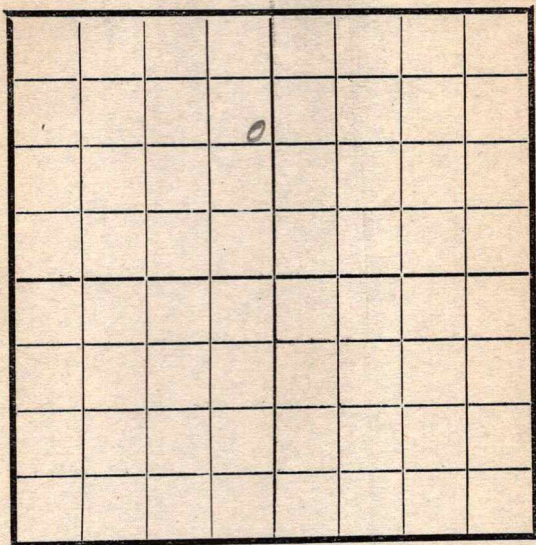

EAST

SOUTH

Location _____

Rig Up _____

Drilling and remarks

*fishing for
set jars string
tools & a
bailer*

RECORD

Cased _____ in. _____ Ft.

Sand _____

Gas _____

Oil _____

Total Depth _____

PRODUCTION

1st 24 hrs. Nat. _____

1st 24 hrs. after shot _____

Gas _____ Cu. Ft.


Dry Hole _____

Abandoned _____

Date

3/11, 1918 Pyle Scout _____

Map No. _____ Sec. 3 Twp. 26 R. 5
 Well No. 2 Track Farm _____
Hickory Company _____
 NORTH

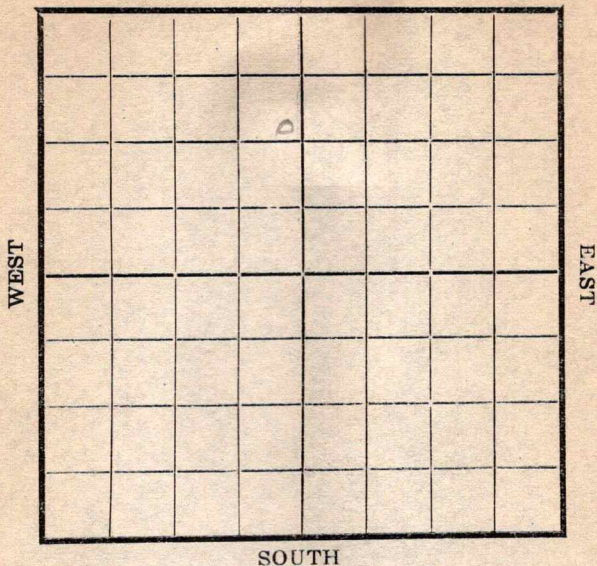

Location _____

Rig Up _____

Drilling and remarks

fishing
@
1570'

RECORD

Cased _____ in. _____ Ft.

Sand _____

Gas _____

Oil _____

Total Depth _____

PRODUCTION

1st 24 hrs. Nat. _____

1st 24 hrs. after shot _____

Gas _____ Cu. Ft.

Dry Hole _____

Abandoned _____

Date

3/8, 1918 Py Scout

Map No. _____ Sec. 3 Twp. 26 R. 5Well No. 2 Tract Farm _____
2 Hickory Company _____

NORTH

WEST

EAST

SOUTH

Location _____

Rig Up _____

Drilling and remarks

D. 10 @
1545

RECORD

Cased _____ in _____ Ft.

Sand _____

Gas _____

Oil _____

Total Depth _____

PRODUCTION

1st 24 hrs. Nat. _____

1st 24 hrs. after shot _____

Gas _____ Cu. Ft.

Dry Hole _____

Abandoned _____

Date

3/27, 1918 Oy 4 Scout _____

Map No. _____ Sec. 3 Twp. 26 R. 5Well No. 20 Track Farm _____Hickory Company _____

NORTH

WEST

EAST

SOUTH

Location _____

Rig Up _____

Drilling and remarks

RECORD

Cased _____ in _____ Ft.

Sand _____

Gas _____

Oil _____

Total Depth _____

PRODUCTION

1st 24 hrs. Nat. _____

1st 24 hrs. after shot _____

Gas _____ Cu. Ft.


Dry Hole _____

Abandoned _____

Date

4/2, 1918Scout Oy a

Map No. _____ Sec. 3 Twp. 26 R. 5
 Well No. 2 Track Farm _____
2 Hickory Company _____
 NORTH

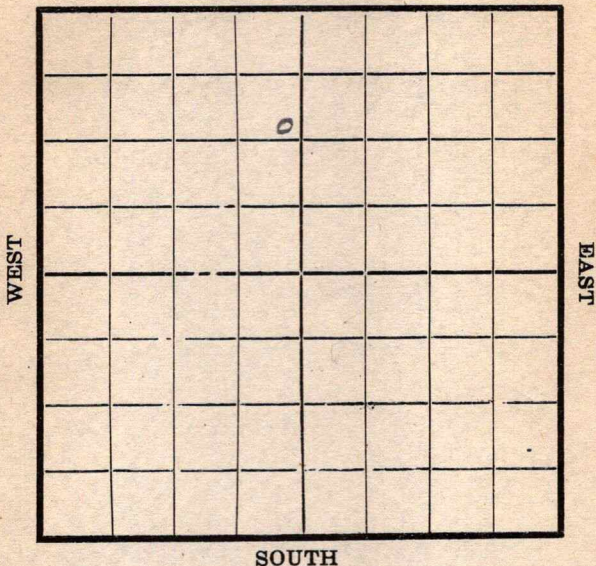

Location _____

Rig Up _____

Drilling and remarks

D. 10 @
1570'

RECORD

Cased _____ in. _____ Ft.

Sand _____

Gas _____

Oil _____

Total Depth _____

PRODUCTION

1st 24 hrs. Nat. _____

1st 24 hrs. after shot _____

Gas _____ Cu. Ft.

Dry Hole _____

Abandoned _____


Date

4/11, 1918 Pyle Scout

Map No. _____ Sec. 3 Twp. 26 R. 5
 Well No. 2 Track Farm _____
Lickory Company _____

NORTH

WEST

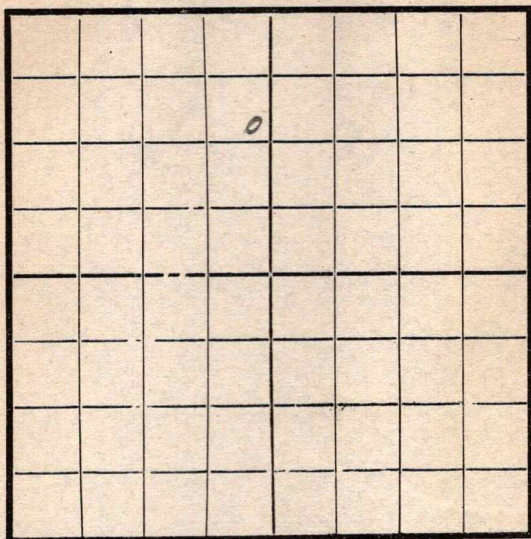

EAST

SOUTH

Location _____

Rig Up _____

Drilling and remarks

RECORD

Cased _____ in. _____ Ft.

Sand _____

Gas _____

Oil _____

Total Depth _____

PRODUCTION

1st 24 hrs. Nat. _____

1st 24 hrs. after shot _____

Gas _____ Cu. Ft.

Dry Hole _____

Abandoned _____


Date

4/18, 1915 J. O. Y. C. Scout

Map No. _____ Sec. 3 Twp. 26 R. 5
 Well No. 2 Tract Farm _____
Hickory Oil Company

NORTH

WEST

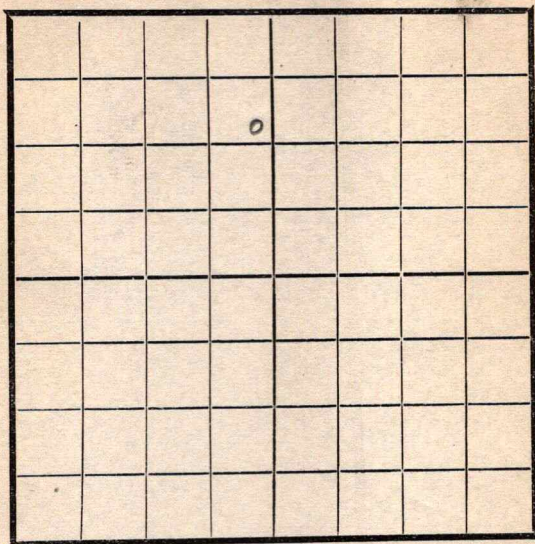

EAST

SOUTH

RECORD

Location _____
 Rig Up _____
 Drilling and remarks

Cased _____ in. _____ Ft.
 Sand _____
 Gas _____
 Oil _____
 Total Depth _____

PRODUCTION

1st 24 hrs. Nat. _____
 1st 24 hrs. after shot _____
 Gas _____ Cu. Ft.
 Dry Hole _____
 Abandoned _____


Date

4/24, 1918 Oyle Scout

Map No. _____ Sec. 3 Twp. 26 R. 5Well No. 22 Tract Farm _____
Hickory Company _____

NORTH

WEST

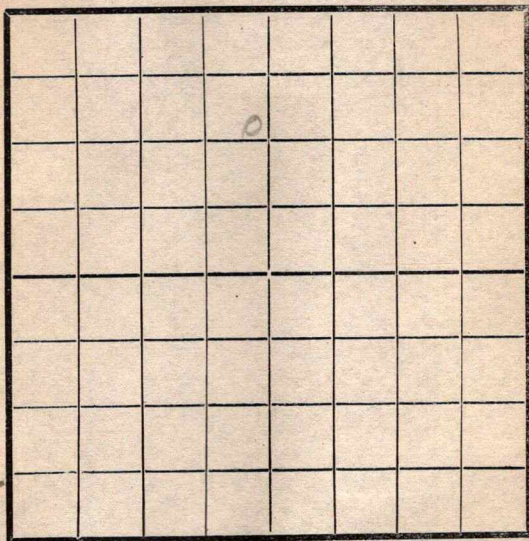

EAST

SOUTH

Location _____

Rig Up _____

Drilling and remarks

R.D. @1370'

RECORD

Cased _____ in. _____ Ft.

Sand _____

Gas _____

Oil _____

Total Depth _____

PRODUCTION

1st 24 hrs. Nat. _____

1st 24 hrs. after shot _____

Gas _____ Cu. Ft.

Dry Hole _____

Abandoned _____

Date

5/2, 1918 Ogle Scout _____

Map No. _____ Sec. 3 Twp. 26 R. 5Well No. 2 Track Farm _____Hickory O & L Company

NORTH

WEST

EAST

SOUTH

Location _____

Rig Up _____

Drilling and remarks


 10 @
 1570'

RECORD

Cased _____ in. _____ Ft.

Sand _____

Gas _____

Oil _____

Total Depth _____

PRODUCTION

1st 24 hrs. Nat. _____

1st 24 hrs. after shot _____

Gas _____ Cu. Ft.

Dry Hole _____

Abandoned _____


Date

5/8, 1918 Clyde Scout

Map No. _____ Sec. 3 Twp 26 R. 5Well No. 2 Tract _____ Farm _____Richmond Oil _____ Company _____

NORTH

WEST

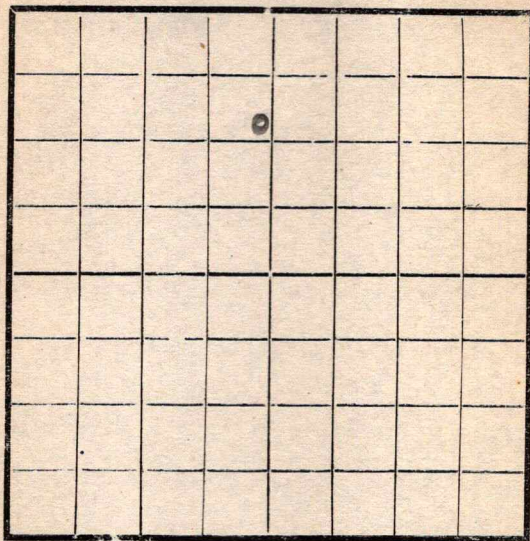

EAST

SOUTH

Location _____

Rig Up _____

Drilling and remarks

RECORD

Cased _____ in. _____ Ft.

Sand _____

Gas _____

Oil _____

Total Depth _____

PRODUCTION

1st 24 hrs. Nat. _____

1st 24 hrs. after shot _____

Gas _____ Cu. Ft.

Dry Hole _____

Abandoned _____

Date

5/8, 1918 Dyer _____ Scout15

Map No. _____ Sec. 3 Twp. 26 R. 5Well No. 22 Tract
Richson _____ Company _____ Contractor _____

NORTH

WEST

EAST

SOUTH

Location _____

Rig up _____

Drilling and Remarks:

D. 10, @
1570'

RECORD

Cased _____ in., _____ ft.

Sand _____

Gas _____

Oil _____

Total Depth _____

PRODUCTION

1st 24 hrs. Nat. _____

1st 24 hrs. after shot _____

Gas _____ Cu. Ft.

Dry Hole _____

Abandoned _____

Date

191

Scout


Map No. _____ Sec. 3 Twp. 26 R. 5Well No. 22 TractHickory O & S. Company _____

Contractor _____

NORTH

WEST

EAST

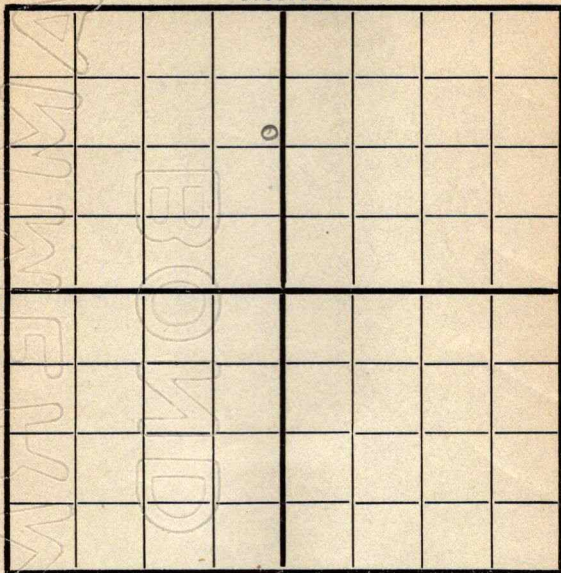

SOUTH

Location _____

Rig up _____

Drilling and Remarks:

D. D@
1570'

RECORD

Cased _____ in., _____ ft

Sand _____

Gas _____

Oil _____

Total Depth _____

PRODUCTION

1st 24 hrs. Nat. _____

1st 24 hrs. after shot _____

Gas _____ Cu. Ft

Dry Hole _____

Abandoned _____

Date


6/4 1918 Cyle Scout

Map No. _____ Sec. 3 Twp. 26 R. 5Well No. 20 TractHickory Company

Contractor _____

NORTH

WEST

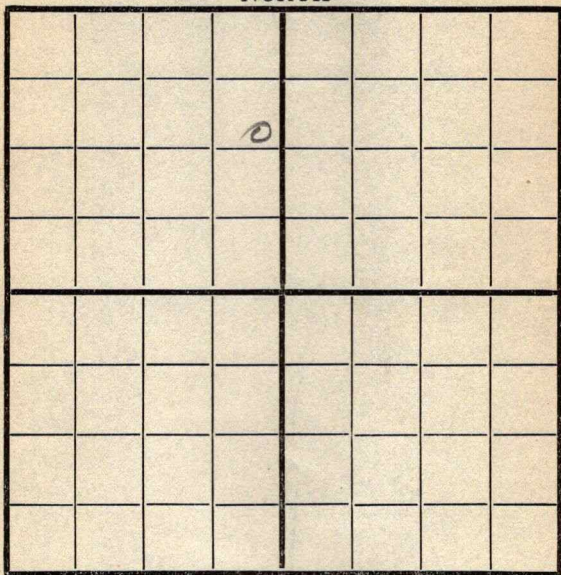

EAST

SOUTH

Location _____

Rig up _____

Drilling and Remarks:

D. 10 @
1570'

RECORD

Cased _____ in., _____ ft.

Sand _____

Gas _____

Oil _____

Total Depth _____

PRODUCTION

1st 24 hrs. Nat. _____

1st 24 hrs. after shot _____

Gas _____ Cu. Ft.

Dry Hole _____

Abandoned _____

Date


191

Scout

Map No. _____ Sec. 3 Twp. 26 R. 5Well No. 22 Tract2 Hickory _____ Company _____

Contractor _____

NORTH

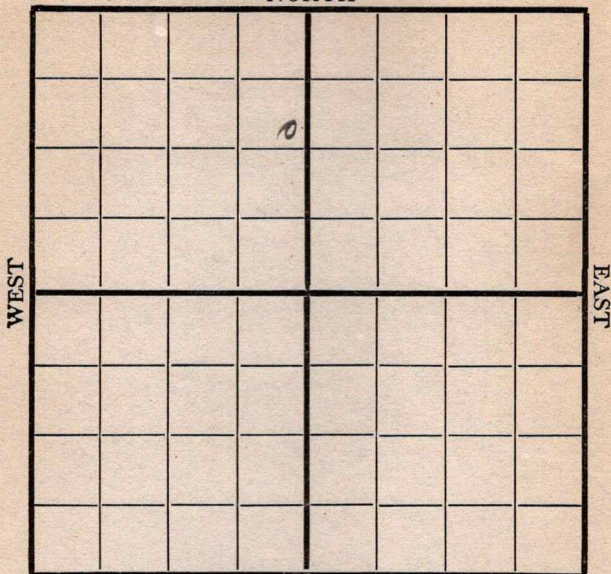

SOUTH

Location _____

Rig up _____

Drilling and Remarks:

D. 10. @
1570'

RECORD

Cased _____ in., _____ ft.

Sand _____

Gas _____

Oil _____

Total Depth _____

PRODUCTION

1st 24 hrs. Nat. _____

1st 24 hrs. after shot _____

Gas _____ Cu. Ft.

Dry Hole _____

Abandoned _____

Date

6/9 1918 G. Y. H. Scout

SOUTH

Scout

Map No. _____ Sec. 3 Twp. 26 R. 5
 Well No. 2 Tract Farm _____
Kickory O&G, Company _____

NORTH

WEST

EAST

SOUTH

Location _____
 Rig Up _____
 Drilling and remarks _____

D 10 @
1570'

RECORD

Cased _____ in. _____ Ft.
 Sand _____
 Gas _____
 Oil _____
 Total Depth _____

PRODUCTION

1st 24 hrs. Nat. _____
 1st 24 hrs. after shot _____
 Gas _____ Cu. Ft.
 Dry Hole _____
 Abandoned _____

Date

7/3, 1918 Oyle Scout

Map No. _____ Sec. 3 Twp. 26 R. 5Well No. 22 Tract Farm _____
Kickory O & S. Company _____

NORTH

WEST

EAST

SOUTH

Location _____

Rig Up _____

Drilling and remarks

D. 10 @
1570'

RECORD

Cased _____ in. _____ Ft.

Sand _____

Gas _____

Oil _____

Total Depth _____

PRODUCTION

1st 24 hrs. Nat. _____

1st 24 hrs. after shot _____

Gas _____ Cu. Ft.

Dry Hole _____

Abandoned _____

Date

7/10, 1918 Cyph Scout

Map No. _____ Sec. 3 Twp. 24 R. 5Well No. 2 Tract
Kibory 095 Company _____

Contractor _____

NORTH

WEST

EAST

SOUTH

Location _____

Rig up _____

Drilling and Remarks:

D. D @
1570'

RECORD

Cased _____ in., _____ ft.

Sand _____

Gas _____

Oil _____

Total Depth _____

PRODUCTION

1st 24 hrs. Nat. _____

1st 24 hrs. after shot _____

Gas _____ Cu. Ft.

Dry Hole _____

Abandoned _____

Date

7/17 1918 Pyle Scout

Map No. _____ Sec. 3 Twp. 26 R. 5Well No. 2 TractHickory _____ Company _____

_____ Contractor _____

NORTH

WEST

EAST

SOUTH

Location _____

Rig up _____

Drilling and Remarks:

D. 10 @
1570'

RECORD

Cased _____ in., _____ ft.

Sand _____

Gas _____

Oil _____

Total Depth _____

PRODUCTION

1st 24 hrs. Nat. _____

1st 24 hrs. after shot _____

Gas _____ Cu. Ft.

Dry Hole _____

Abandoned _____


Date

7/24 1918 Cyle _____ Scout _____

Map No. _____ Sec. 3 Twp. 26 R. 5Well No. 20 Tract
Richards O & B. Company

Contractor _____

NORTH

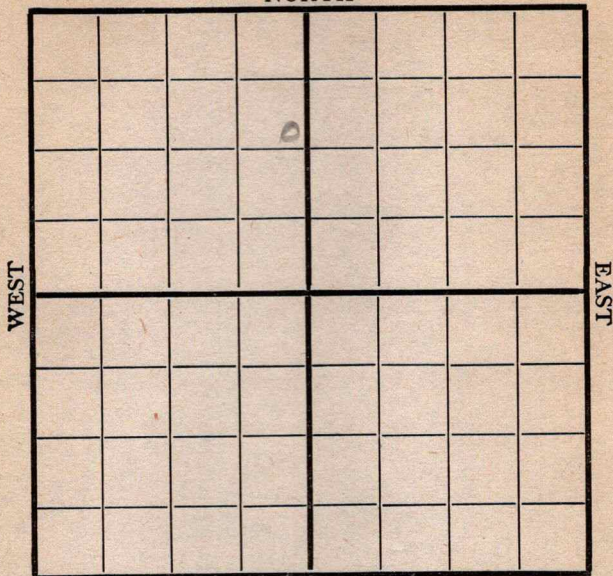

SOUTH

Location 1200' N
200' E

Rig up _____

Drilling and Remarks:

D. 10 @
1570'

RECORD

Cased _____ in., _____ ft

Sand _____

Gas _____

Oil _____

Total Depth _____

PRODUCTION

1st 24 hrs. Nat. _____

1st 24 hrs. after shot _____

Gas _____ Cu. F

Dry Hole _____

Abandoned _____

Date


8/8 1918 Cy L Score _____

Map No. _____ Sec. 3 Twp. 24 R. 5Well No. 2 Tract
Hickory 0 7 5 _____ Comp. _____

Contract _____

NORTH

WEST

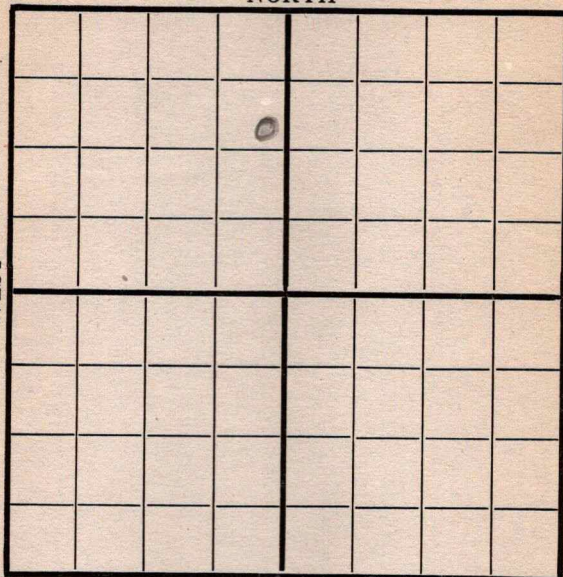

SOUTH

Location 1200 N
200 E

Rig up _____

Drilling and Remarks:

D. 10 @
1570'

RECORD

Cased _____ in., _____

Sand _____

Gas _____

Oil _____

Total Depth _____

PRODUCTION

1st 24 hrs. Nat. _____

1st 24 hrs. after shot _____

Gas _____ Cu. F.

Dry Hole _____


Abandoned _____

Date

8/8 191 8 Oyle Scot

Map No. _____ Sec. 3 Twp. 26 R. 5
 Well No. 22 Track
Hickory O & G. Company
 _____ Contractor

NORTH

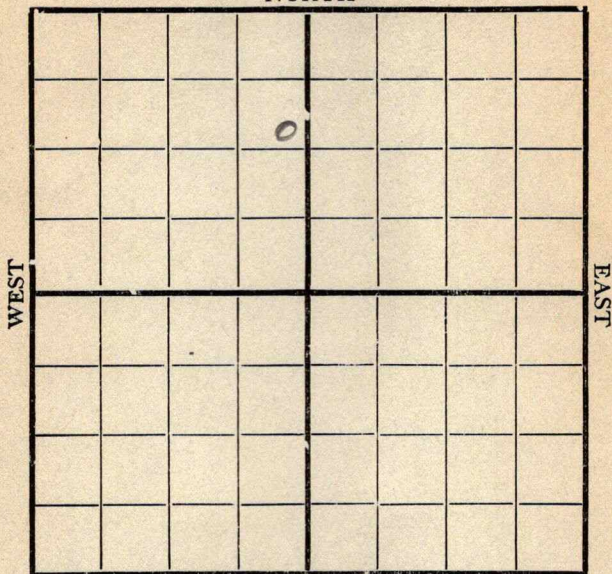

SOUTH

1200 N
200 E
 Location _____

Rig up _____

Drilling and Remarks:

D. D. @
1570'

RECORD

Cased _____ in., _____ ft.

Sand _____

Gas _____

Oil _____

Total Depth _____

PRODUCTION

1st 24 hrs. Nat. _____

1st 24 hrs. after shot _____

Gas _____ Cu. Ft.

Dry Hole _____

Abandoned _____

Date

191


8 July _____ Scout

Map No. _____ Sec. 3 Twp. 26 R. 5Well No. 227 trackRichmond Oil Co. Company_____
Contractor

NORTH

WEST

EAST

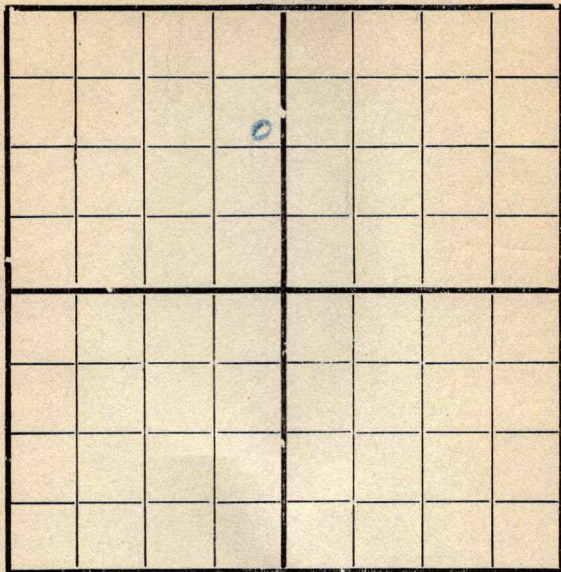

SOUTH

1200' n - 700' e

Location _____

Rig up _____

Drilling and Remarks:

D. N @
1570'

RECORD

Cased _____ in., _____ ft.

Sand _____

Gas _____

Oil _____

Total Depth _____

PRODUCTION

1st 24 hrs. Nat. _____

1st 24 hrs. after shot _____

Gas _____ Cu. Ft.

Dry Hole _____

Abandoned _____

Date

8/22

1916

Pyle

Scout


Map No. K14 Sec. 3 Twp. 26^S R. 5^EWell No. 2 TrachHickory O & M. Company

Contractor

NORTH

WEST

EAST

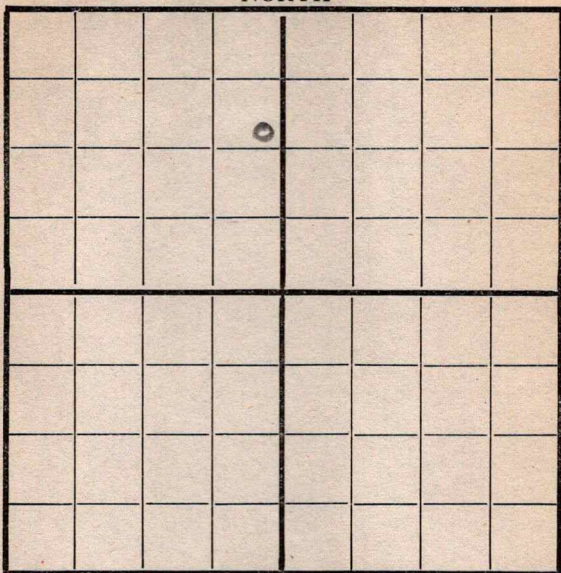1200N 200E SOUTH

Location

~~1200 S~~
~~200 W~~

Rig up

Drilling and Remarks:

D. 10 @1570'

RECORD

Cased _____ in., _____ ft.

Sand _____

Gas _____

Oil _____

Total Depth _____

PRODUCTION

1st 24 hrs. Nat. _____

1st 24 hrs. after shot _____

Gas _____ Cu. Ft.

Dry Hole _____

Abandoned _____

Date

8/24

191

8

Pyle

Scout

EAST

SOUTH

Date _____

Abandoned.....

Pyle

Scout

Map No. K14 Sec. 3 Twp. 26 R. 5Well No. 1 Track
Hickory 049 Company

Contractor

NORTH

WEST

EAST

SOUTH

Location

1200' N
200' S

Rig up

Drilling and Remarks:

D 10 @ 1370'

RECORD

Cased..... in., ft.

Sand.....

Gas.....

Oil.....

Total Depth.....

PRODUCTION

1st 24 hrs. Nat.

1st 24 hrs. after shot

Gas..... Cu. Ft.

Dry Hole.....

Abandoned.....

Date

9/11

191

8

Pyle

Scout

Map No. K14 Sec. 3 Twp. 26 R. 5
 Well No. 1. J rack
Hickory O & G. Company
 Contractor

NORTH

WEST

EAST

SOUTH

Location 1200' N
200' E
 Rig up _____
 Drilling and Remarks:

D 10 @
1570

RECORD

Cased _____ in., _____ ft.
 Sand _____
 Gas _____
 Oil _____
 Total Depth _____

PRODUCTION

1st 24 hrs. Nat. _____
 1st 24 hrs. after shot _____
 Gas _____ Cu. Ft.
 Dry Hole _____
 Abandoned _____

Date

9/17 1918 Ryle Scout

Map No. K14 Sec. 3 Twp. 26 R. 5
 Well No. 1 tract
Hickory O & G. Company
 Contractor

NORTH

WEST

EAST

SOUTH

Location 1200' N200' E

Rig up

Drilling and Remarks:

D 10 1570

RECORD

Cased.....in.,ft.

Sand.....

Gas.....

Oil.....

Total Depth.....

PRODUCTION

1st 24 hrs. Nat.

1st 24 hrs. after shot.....

Gas.....Cu. Ft.

Dry Hole.....

Abandoned.....

Date

9/25

191

8

Pyle

Scout

Map No. K14 Sec. 3 Twp. 26 R. 5Well No. 1 Trach
Hickory O & Y. Company
Contractor

NORTH

WEST

EAST

SOUTH

Location 1200-N
200-E
Rig up _____

Drilling and Remarks:

RECORD

Cased _____ in., _____ ft.
Sand _____
Gas _____
Oil _____
Total Depth _____

PRODUCTION

1st 24 hrs. Nat. _____
1st 24 hrs. after shot _____
Gas _____ Cu. Ft.
Dry Hole _____
Abandoned _____

Date

1918


Pyle

Scout

Map No. K14 Sec. 3 Twp. 26 R. 5
 Well No. 123
Hickory O & G. Company
 Contractor

NORTH

WEST

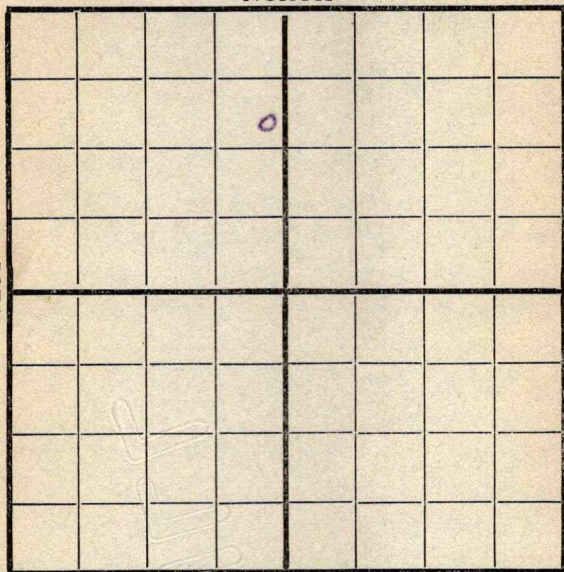

EAST

SOUTH

Location 1200-N

200-E

Rig up

Drilling and Remarks:

1570'

RECORD

Cased _____ in., _____ ft.

Sand _____

Gas _____

Oil _____

Total Depth _____

PRODUCTION

1st 24 hrs. Nat. _____

1st 24 hrs. after shot _____

Gas _____ Cu. Ft.

Dry Hole _____

Abandoned _____

Date

10/8

191

Pyle


Scout

Map No. K14 Sec. 3 Twp. 26 R. 5
Well No. 127
Hickory O & G. Company
Contractor

NORTH

WEST

EAST

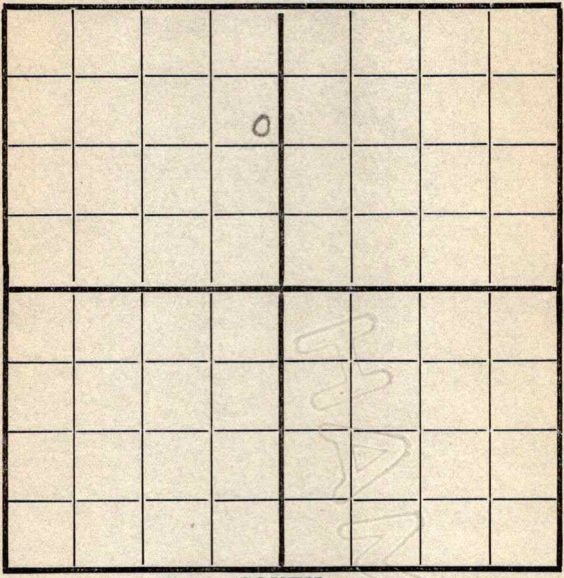

SOUTH

Location 1200-N
200-E
Rig up
Drilling and Remarks:

10 @
1570'

RECORD

Cased _____ in., _____ ft.
Sand _____
Gas _____
Oil _____
Total Depth _____


PRODUCTION

1st 24 hrs. Nat. _____
1st 24 hrs. after shot _____
Gas _____ Cu. Ft.
Dry Hole _____
Abandoned _____

Date 10/17 1918 **Pyle** Scout

Map No. K14 Sec. 3 Twp. 26 R. 5
Well No. 1 Tract
Hickory O & G. Company
Contractor

NORTH

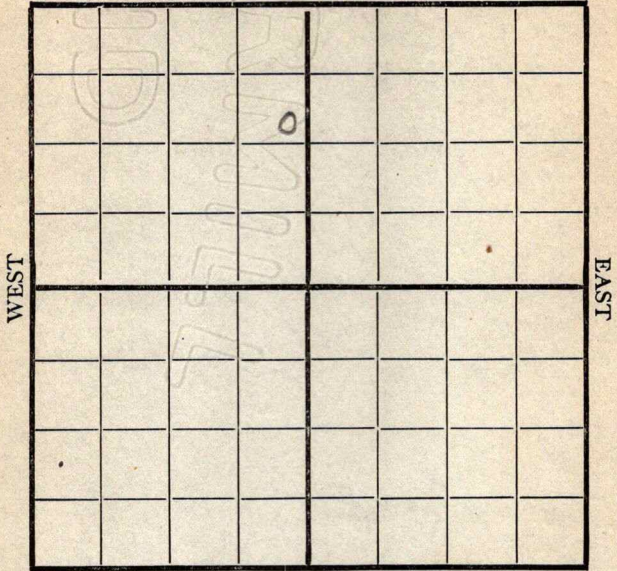

SOUTH

Location 1200-N
200-E
Rig up
Drilling and Remarks:
AD @
1570

RECORD

Cased _____ in., _____ ft.
Sand _____
Gas _____
Oil _____
Total Depth _____

PRODUCTION

1st 24 hrs. Nat. _____
1st 24 hrs. after shot _____
Gas _____ Cu. Ft.
Dry Hole _____
Abandoned _____

Date 10/26 1918 Pyle Scout

Map No. K14 Sec. 3 Twp. 26 R. 5
 Well No. 1200-E
Hickory O.K.G. Company
 Contractor

NORTH

SOUTH

Location 1200-N

Rig up 200-E

Drilling and Remarks:

D. 10 @
1570'

RECORD

Cased _____ in., _____ ft.
 Sand _____
 Gas _____
 Oil _____
 Total Depth _____

PRODUCTION

1st 24 hrs. Nat. _____
 1st 24 hrs. after shot _____
 Gas _____ Cu. Ft.
 Dry Hole _____
 Abandoned _____

Date

11/6 1918

Pyle

Scout

Map No. K14 Sec. 3 Twp. 26 R. 5Well No. 1 Tract
Hickory OIL Company

Contractor

NORTH

WEST

EAST

SOUTH

Location 1200-NRig up 200-E

Drilling and Remarks:

1570'

RECORD

Cased _____ in., _____ ft.

Sand _____

Gas _____

Oil _____

Total Depth _____

PRODUCTION

1st 24 hrs. Nat. _____

1st 24 hrs. after shot _____

Gas _____ Cu. Ft.

Dry Hole _____

Abandoned _____

Date

11/13 1918


Pyle

Scout

Map No. K14 Sec. 3 Twp. 26 R. 5Well No. 127 tractHickory O & G. Company

Contractor

NORTH

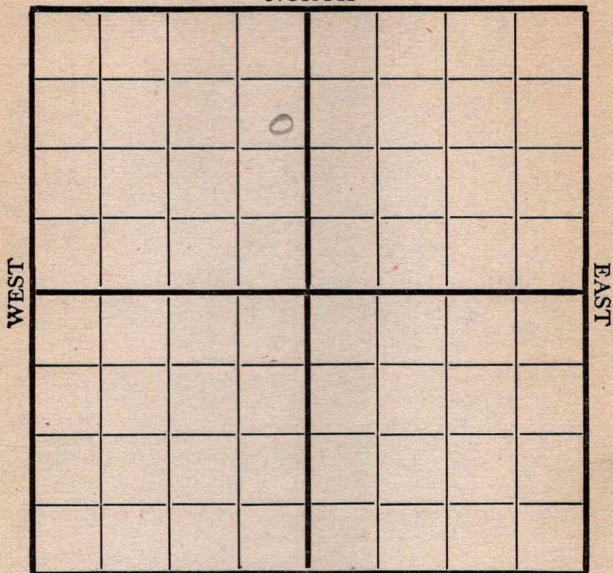

SOUTH

1200 N 200 E

Location _____

Rig up _____

Drilling and Remarks:

D. 10 for
found @
1570'

RECORD

Cased _____ in., _____ ft.

Sand _____

Gas _____

Oil _____

Total Depth _____

PRODUCTION

1st 24 hrs. Nat. _____

1st 24 hrs. after shot _____

Gas _____ Cu. Ft.

Dry Hole _____

Abandoned _____

Date

11/21 1918 Cyph Scout

Map No. K 14 Sec. 3 Twp. 26 R. 5
 Well No. 1 Tract
Hickory O.K.G. Company
 Contractor

NORTH							
WEST							
SOUTH							
1200-N				200-E			

Location _____
 Rig up _____
 Drilling and Remarks:

10 @
1570'

RECORD

Cased _____ in., _____ ft.
 Sand _____
 Gas _____
 Oil _____
 Total Depth _____

PRODUCTION

1st 24 hrs. Nat. _____
 1st 24 hrs. after shot _____
 Gas _____ Cu. Ft.
 Dry Hole _____
 Abandoned _____

Date

11/29 1918

Pyle

Scout


Map No. K 14 Sec. 3 Twp. 26 R. 5Well No. 1 Track
Hickory O. & G. Company

Contractor

NORTH

WEST

EAST

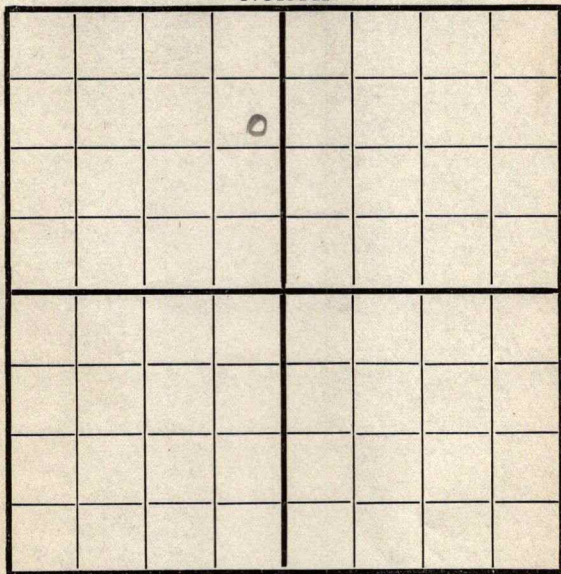

SOUTH

1200-N200-E

Location _____

Rig up _____

Drilling and Remarks:

RECORD

Cased _____ in., _____ ft.

Sand _____

Gas _____

Oil _____

Total Depth _____

PRODUCTION

1st 24 hrs. Nat. _____

1st 24 hrs. after shot _____

Gas _____ Cu. Ft.

Dry Hole _____

Abandoned _____

Date

12/5 1918C. J. L. Scout


Map No. K 14 Sec. 3 Twp. 26 R. 5Well No. 12 Tract
Hickory O.K. Company _____

Contractor _____

NORTH

WEST

EAST

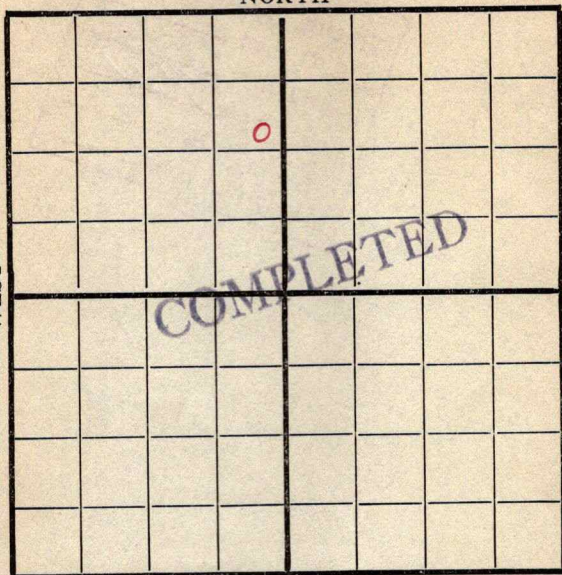

SOUTH

1200-N200-E

Location _____

Rig up _____

Drilling and Remarks:

RECORD

Cased _____ in., _____ ft.

Sand _____

Gas _____

Oil _____

Total Depth _____

PRODUCTION

1st 24 hrs. Nat. _____

1st 24 hrs. after shot _____

Gas _____ Cu. Ft.

Dry Hole _____

Abandoned 1570'

Date

12/10

191

8Pyle

Scout

3-24-5

