


Section 4 Township 26 Range 5-E

Well No. 12 Cook

Company Associated Oil & Gas

NORTH Eldorado Pool

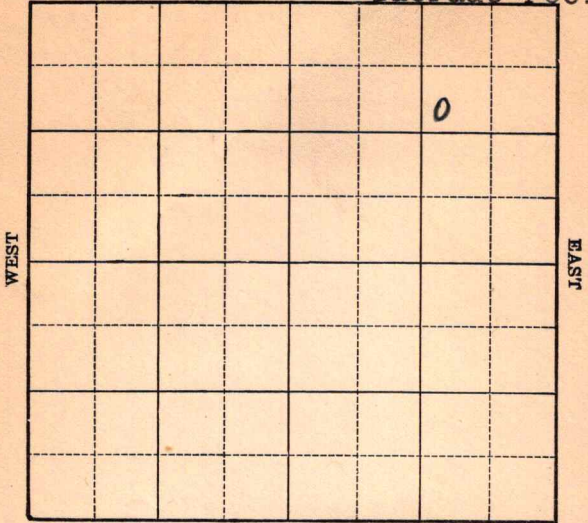

SOUTH

Sec. 4 Twp. 26 R. 5-E

Well No. #12 Cook Farm

Associated Oil & Gas _____ Company


(Eldorado)

1220 Ft. from N. Line

Ft. from S. Line

1170 Ft. from E. Line

Ft. from W. Line

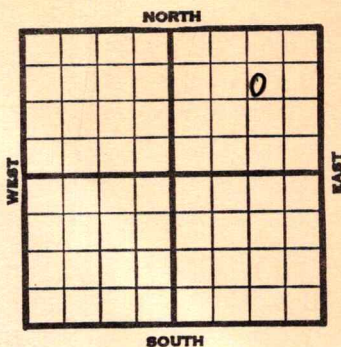[illegible]

Map No. 14 Sec. 4 Twp. 26 R. 5EWell No. 12 CookAssociated Oil & Gas

Company

Contractor

FIRST REPORT

SW NE NE

1220 Ft. from N. Line

_____ Ft. from S. Line

1170 Ft. from E. Line

_____ Ft. from W. Line

ELDORADO POOL

SECTION PLAT

			o

Location _____

Rig up _____

Drilling and Remarks:

13" - 50Dr lg. 600

RECORD

Cased _____ in., _____ ft.

Sand _____

Gas _____

Oil _____

Total Depth _____

PRODUCTION

1st 24 hrs. Nat. _____

1st 24 hrs. after shot _____

Gas _____ Cu. Ft.

Dry Hole _____

Abandoned _____

Date

DEC 20 1939 19

S. J. LEWIS

Scout

Map No. 14 Sec. 4 Twp. 26 R. 5EWell No. 12 CookAssociated Oil & Gas

Company

Contractor

COMPLETED

SW NE NE

1220 Ft. from N. Line Ft. from S. Line1170 Ft. from E. Line Ft. from W. Line

ELDORADO POOL

SECTION PLAT

			0

Location Rig up

Drilling and Remarks:

*Viola 2596**2" @ 2597**2000 acid**Pump 120*

RECORD

Cased in., ft.Sand Gas Oil Total Depth 2611 1/2

PRODUCTION

1st 24 hrs. Nat. 1st 24 hrs. after shot Gas Cu. Ft.Dry Hole Abandoned

Date

JAN 17 1940

19

S. J. LEWIS

Scout