


Map No. 2 Sec. 22 Twp. 26 R. 8
 Well No. 3 Stonhope Farm
Great Southern Company

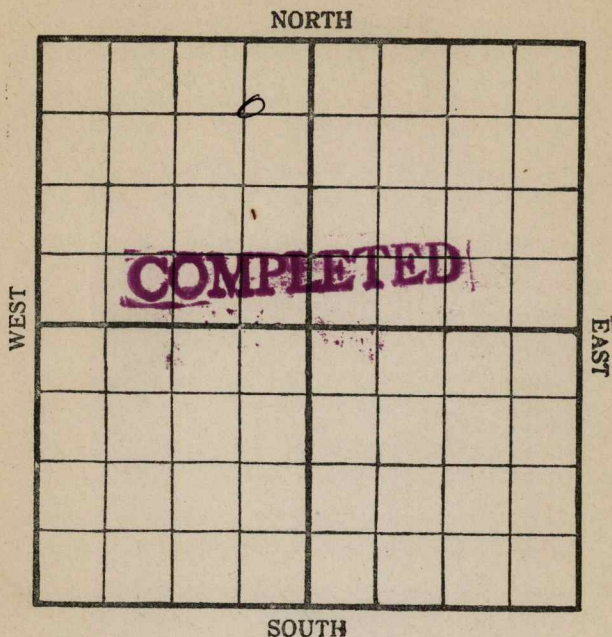

Location _____

Rig Up _____

Drilling Remarks:

Drilling Remarks:

RECORD

Cased _____ in. _____ ft.

Sand _____

Gas _____

Oil _____

Total Depth _____

PRODUCTION

1st 24 hrs. Nat. _____

1st 24 hrs. after shot _____

Gas _____ cu. ft


Dry Hole _____

Abandoned _____

Map No. _____ Sec. 22 Twp. 26 R. 8Well No. 3. Steinhope FarmGreat Southern Company
Greenwood NORTH

WEST

EAST

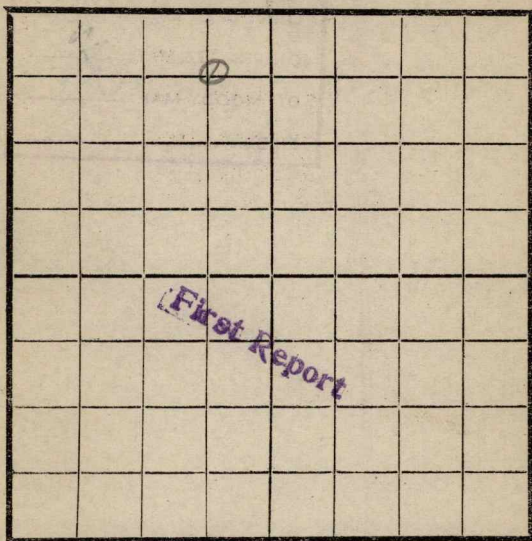

SOUTH

Location _____

Rig Up _____

Drilling and remarks

S.S. at 1300.

RECORD

Cased _____ in _____ Ft

Sand _____

Gas _____

Oil _____

Total Depth _____

PRODUCTION

1st 24 hrs. Nat. _____

1st 24 hrs. after shot _____

Gas _____ Cu. Ft.

Dry Hole _____


Abandoned _____

Date

8-31-1917 Laut Scout

Map No. _____ Sec. 22 Twp. 26 R. 8
 Well No. 3 Starbuck Farm _____
Great Southern Company

NORTH

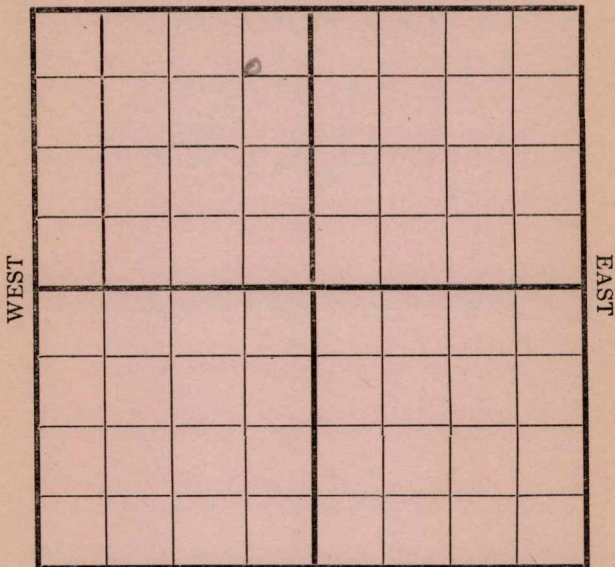

SOUTH

Location _____

Rig Up _____

Drilling and remarks

1400

RECORD

Cased _____ in. _____ Ft.

Sand _____

Gas _____

Oil _____

Total Depth _____

PRODUCTION

1st 24 hrs. Nat. _____

1st 24 hrs. after shot _____

Gas _____ Cu. Ft.

Dry Hole _____

Abandoned _____


Date

9/17, 1917 Cardiff Scout

Map No. _____ Sec. 27 Twp. 26 R. 8Well No. 3 Starhope Farm _____Great Southern Company _____

NORTH

WEST

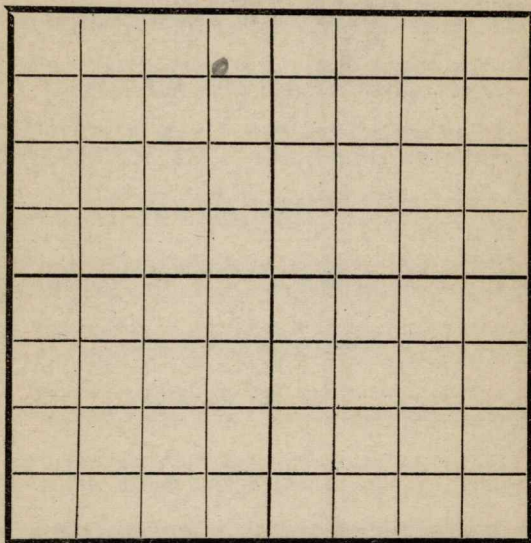

EAST

SOUTH

Location _____

Rig Up _____

Drilling and remarks

Shut down
at 1700
Greenwood
Co

RECORD

Cased _____ in. _____ Ft.

Sand _____

Gas _____

Oil _____

Total Depth _____

PRODUCTION

1st 24 hrs. Nat. _____

1st 24 hrs. after shot _____

Gas _____ Cu. Ft.

Dry Hole _____

Abandoned _____


Date

10/24 1917 Landry Scout

Map No. _____ Sec. 22 Twp. 26 R. 8Well No. 3 Stanhope Farm _____Great Southern Company

NORTH

WEST

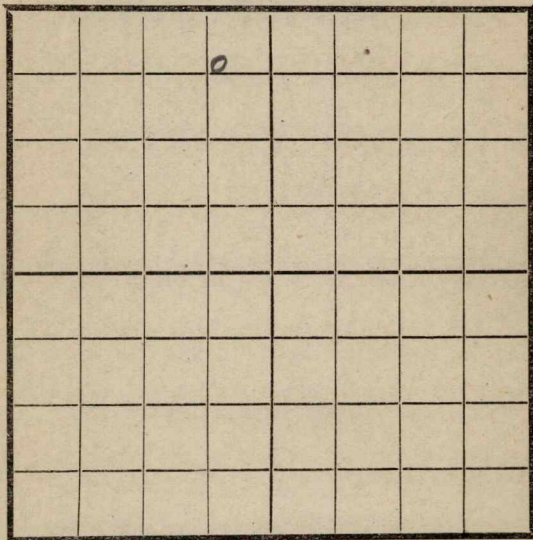

EAST

SOUTH

Location _____

Rig Up _____

Drilling and remarks

2.20. 1650'

RECORD

Cased _____ in. _____ Ft.

Sand _____

Gas _____

Oil _____

Total Depth _____

PRODUCTION

1st 24 hrs. Nat. _____

1st 24 hrs. after shot _____

Gas _____ Cu. Ft.

Dry Hole _____

Abandoned _____

Date

11/5, 1917 Byrle Scout


Map No. _____ Sec. 22 Twp. 26 R. 8

Well No. 2 Stanhope Farm _____

Company _____

NORTH

WEST

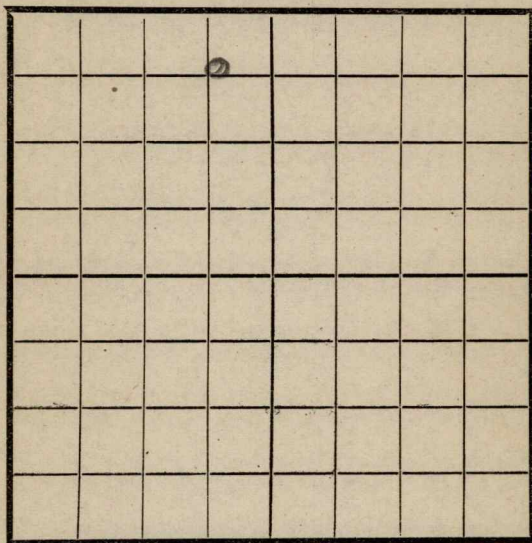

EAST

SOUTH

Location _____

Rig Up _____

Drilling and remarks

2000'

RECORD

Cased _____ in. _____ Ft.

Sand _____

Gas _____

Oil _____

Total Depth _____

PRODUCTION

1st 24 hrs. Nat. _____

1st 24 hrs. after shot _____

Gas _____ Cu. Ft.

Dry Hole _____

Abandoned _____

Date

11/17

191

7


Pyle

Scout

Map No. _____ Sec. 22 Twp. 26 R. 5Well No. 2 Stanhope FarmSt. Southern Company

NORTH

WEST

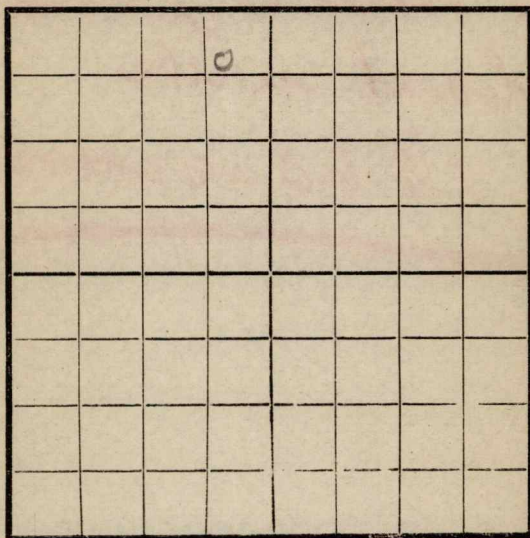

EAST

SOUTH

Location _____

Rig Up _____

Drilling and remarks _____

RECORD

Cased _____ in _____ Ft.

Sand _____

Gas _____

Oil _____

Total Depth _____

PRODUCTION

1st 24 hrs. Nat. _____

1st 24 hrs. after shot _____

Gas _____ Cu. Ft.

Dry Hole _____


Abandoned _____

Date

11/24, 1917 Dyle Scout

Map No. _____
 Sec. _____
 Twp. _____
 R. _____
 Well No. _____
 Company _____

Driller was
 a damn liar
 last week
 1860 is correct

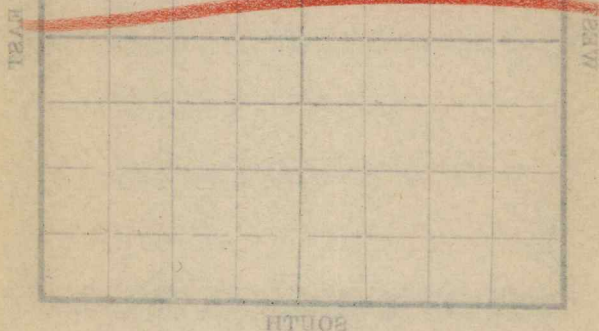

RECORD

Cased in _____
 Sand _____
 Gas _____
 Oil _____
 Total Depth _____

PRODUCTION

1st 24 hrs Nat. _____
 1st 24 hrs after shot _____
 Gas _____
 Dry Hole _____
 Abandoned _____

Location _____

Rig Up _____

Drilling and remarks _____

Date _____


191 _____

Scale _____

Map No. _____ Sec. 22 Twp. 26 R. 8
 Well No. 2 Stanhope Farm
St Southern Company

NORTH

WEST

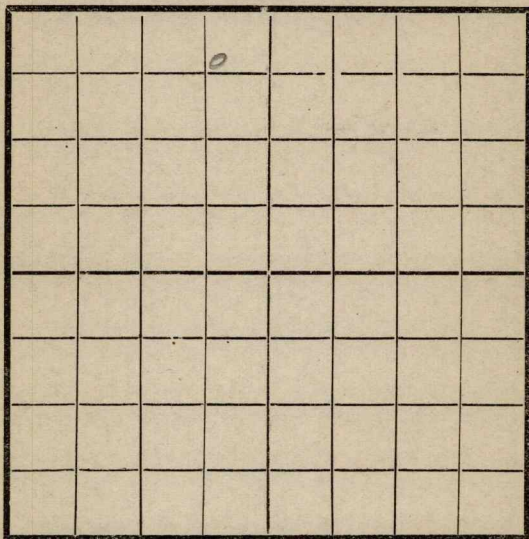

EAST

SOUTH

Location _____

Rig Up _____

Drilling and remarks

1900'
Hay Tower

RECORD

Cased _____ in. _____ Ft.

Sand _____

Gas _____

Oil _____

Total Depth _____

PRODUCTION

1st 24 hrs. Nat. _____

1st 24 hrs. after shot _____

Gas _____ Cu. Ft.

Dry Hole _____

Abandoned _____

Date

1/29, 1917 Py a Scout

Map No. _____ Sec. 22 Twp. 24 R. 8Well No. 2 Stanhope FarmSt. Southern Company

NORTH

WEST

EAST

SOUTH

Location _____

Rig Up _____

Drilling and remarks

2100'

RECORD

Cased _____ in. _____ Ft.

Sand _____

Gas _____

Oil _____

Total Depth _____

PRODUCTION

1st 24 hrs. Nat. _____

1st 24 hrs. after shot _____

Gas _____ Cu. Ft.

Dry Hole _____

Abandoned _____


Date

12/6, 1917 Pyle Scout

Map No. _____ Sec. 22 Twp 26 R. 8
 Well No. 2 Stanhope Farm
Gt Southern Company

NORTH

WEST

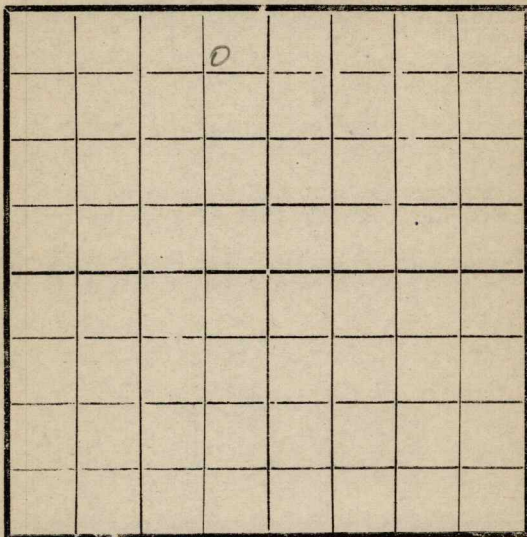

EAST

SOUTH

Location _____
 Rig Up _____
 Drilling and remarks

D. H. 2100'

RECORD

Cased _____ in. _____ Ft.
 Sand _____
 Gas _____
 Oil _____
 Total Depth _____

PRODUCTION

1st 24 hrs. Nat. _____
 1st 24 hrs. after shot _____
 Gas _____ Cu. Ft.
 Dry Hole _____
 Abandoned _____

Date

1/5, 1917

Lyke Scout

Map No. _____ Sec. 22 Twp. 26 R. 8
 Well No. 2 Stanhope Farm
St. Southern Company

NORTH

WEST

EAST

SOUTH

Location _____

Rig Up _____

Drilling and remarks

S. W.2100'

RECORD

Cased _____ in. _____ Ft.

Sand _____

Gas _____

Oil _____

Total Depth _____

PRODUCTION

1st 24 hrs. Nat. _____

1st 24 hrs. after shot _____

Gas _____ Cu. Ft.

Dry Hole _____

Abandoned _____

Date

1/12, 1918Lyle Scout

Map No. _____ Sec. 22 Twp. 26 R. 8
 Well No. 2 Stanhope Farm _____
Sh. Southern Company _____

NORTH

WEST									EAST

SOUTH

Location _____
 Rig Up _____
 Drilling and remarks _____

RECORD

Cased _____ in. _____ Ft.
 Sand _____
 Gas _____
 Oil _____
 Total Depth _____

PRODUCTION


1st 24 hrs. Nat. _____
 1st 24 hrs. after shot _____
 Gas _____ Cu. Ft.
 Dry Hole _____
 Abandoned _____

Date

2/1, 1918 Pyle Scout

Map No. _____ Sec. 22 Twp. 26 R. 8
 Well No. 2 Stanhope Farm _____
Yk Southern Company

NORTH

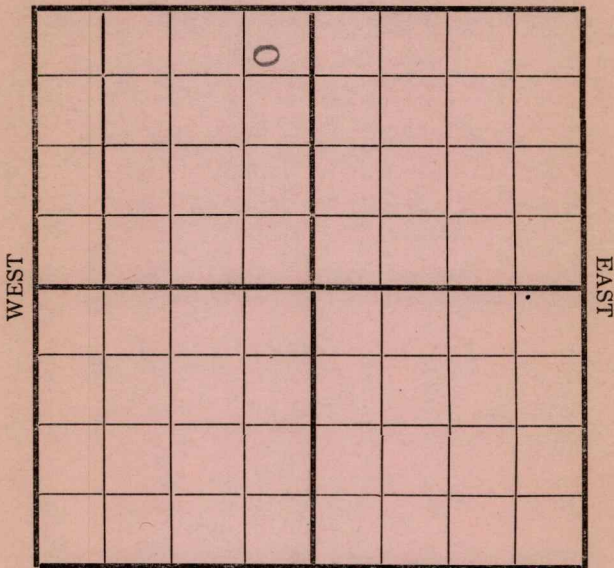

SOUTH

Location _____
 Rig Up _____
 Drilling and remarks _____

RECORD

Cased _____ in. _____ Ft.
 Sand _____
 Gas _____
 Oil _____
 Total Depth _____

PRODUCTION

1st 24 hrs. Nat. _____
 1st 24 hrs. after shot _____
 Gas _____ Cu. Ft.
 Dry Hole _____
 Abandoned _____


Q. D.
@
2100'

Date _____
2/7, 1918 OyL Scout

Map No. _____ Sec. 22 Twp 26 R. 8Well No. 2 Stanhope Farm _____Great Southern Company

NORTH

WEST

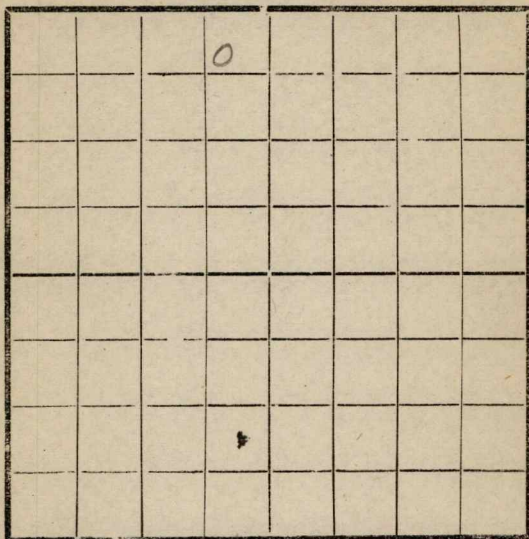

EAST

SOUTH

Location _____

Rig Up _____

Drilling and remarks

RECORD

Cased _____ in. _____ Ft.

Sand _____

Gas _____

Oil _____

Total Depth _____

PRODUCTION

1st 24 hrs. Nat. _____

1st 24 hrs. after shot _____

Gas _____ Cu. Ft.

Dry Hole _____

Abandoned _____


Date

2/14, 1918 Jyle Scout

Map No. _____ Sec. 22 Twp. 24 R. 8
 Well No. 2 Stanhope Farm _____
St Southern Company

NORTH

WEST

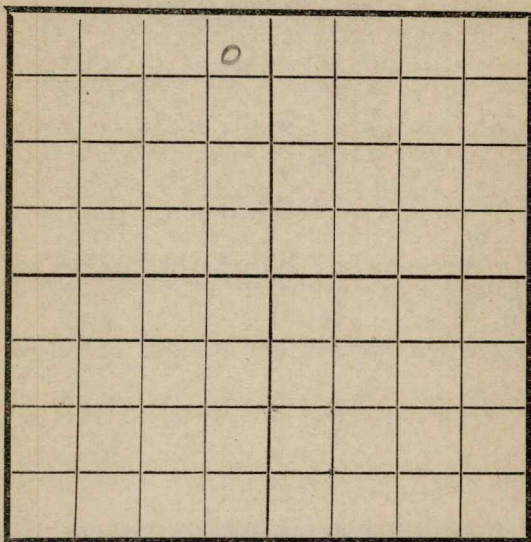

EAST

SOUTH

Location _____
 Rig Up _____
 Drilling and remarks

Set 8" @ 1915
S W @
2100'

RECORD

Cased _____ in. _____ Ft.
 Sand _____
 Gas _____
 Oil _____
 Total Depth _____

PRODUCTION

1st 24 hrs. Nat. _____
 1st 24 hrs. after shot _____
 Gas _____ Cu. Ft.
 Dry Hole _____
 Abandoned _____


Date

2/5, 1918 Gylb Scout

Map No. _____ Sec. 22 Twp. 26 R. 8
 Well No. 2 Stanhope Farm _____
Great Southern Company

NORTH

WEST

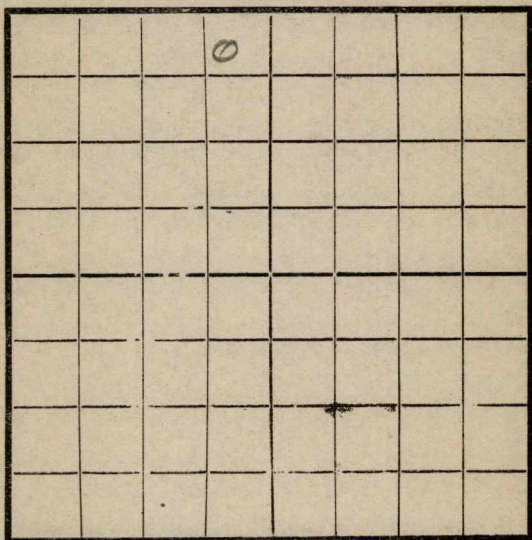

EAST

SOUTH

Location _____

Rig Up _____

Drilling and remarks

U.P. 8" @
2050'

RECORD

Cased _____ in. _____ Ft.

Sand _____

Gas _____

Oil _____

Total Depth _____

PRODUCTION

1st 24 hrs. Nat. _____

1st 24 hrs. after shot _____

Gas _____ Cu. Ft.

Dry Hole _____

Abandoned _____


Date

3/1, 1918 Pyle Scout

Map No. _____ Sec. 22 Twp. 26 R. 8Well No. 2 Stanhope Farm _____St. Southern Company _____

NORTH

WEST

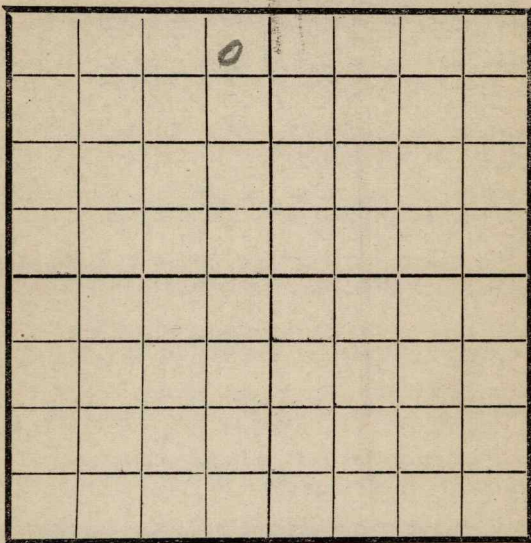

EAST

SOUTH

RECORD

Cased _____ in. _____ Ft.

Sand _____

Gas _____

Oil _____

Total Depth _____

PRODUCTION

1st 24 hrs. Nat. _____

1st 24 hrs. after shot _____

Gas _____ Cu. Ft.

Dry Hole _____

Abandoned _____

Location _____

Rig Up _____

Drilling and remarks

H. P. @
2050'


Date

3/8, 1918 Pyle Scout

Map No. _____ Sec. 22 Twp. 26 R. 8Well No. 2 Stanhope Farm
Great Southern Company

NORTH

WEST

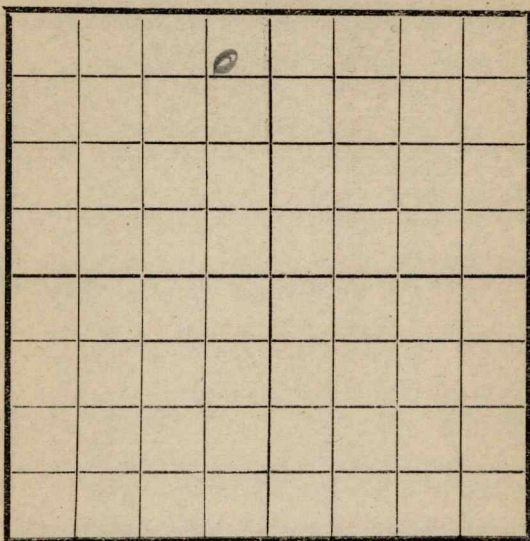

EAST

SOUTH

Location _____

Rig Up _____

Drilling and remarks

RECORD

Cased _____ in _____ Ft

Sand _____

Gas _____

Oil _____

Total Depth _____

PRODUCTION

1st 24 hrs. Nat. _____

1st 24 hrs. after shot _____

Gas _____ Cu. Ft.

Dry Hole _____

Abandoned _____


Date

3 / 15, 1918 Fyl Scout

Map No. _____ Sec. 22 Twp. 26 R. 8Well No. 2 Stanhope FarmSt. Southern Company

NORTH

WEST

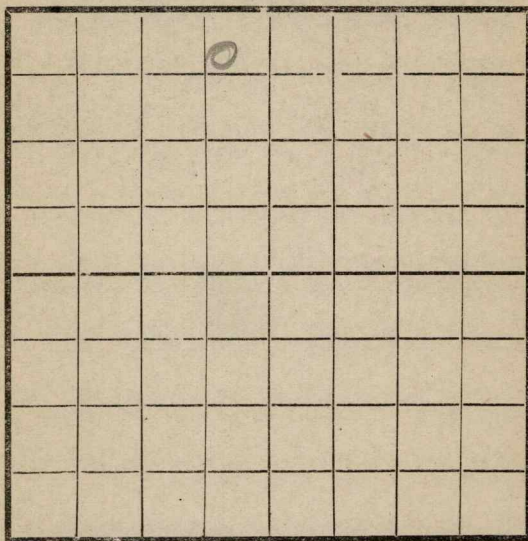

EAST

SOUTH

Location _____

Rig Up _____

Drilling and remarks

RECORD

Cased _____ in _____ Ft.

Sand _____

Gas _____

Oil _____

Total Depth _____

PRODUCTION

1st 24 hrs. Nat. _____

1st 24 hrs. after shot _____

Gas _____ Cu. Ft.

Dry Hole _____

Abandoned _____


Date deeper3/22, 1918Cyle Scout

Map No. _____ Sec. 22 Twp. 26 R. 8
 Well No. 2 Stanhope Farm
St. Southern Company

NORTH

WEST

EAST

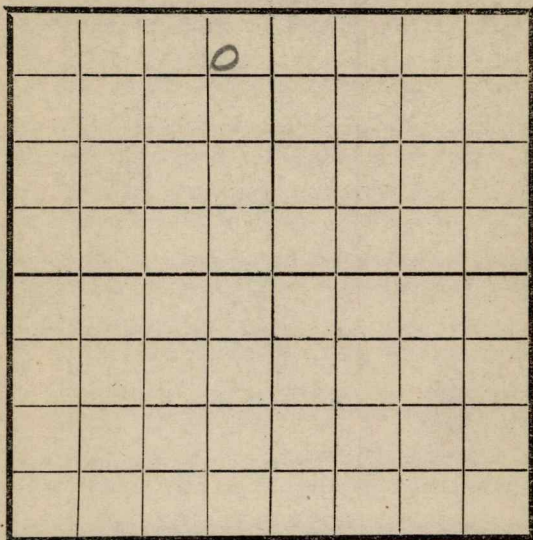

SOUTH

Location _____
 Rig Up _____
 Drilling and remarks _____

RECORD

Cased _____ in. _____ Ft.
 Sand _____
 Gas _____
 Oil _____
 Total Depth _____

PRODUCTION


1st 24 hrs. Nat. _____
 1st 24 hrs. after shot _____
 Gas _____ Cu. Ft.
 Dry Hole _____
 Abandoned _____

Date 3/5, 1918 Dyle Scout

38

Map No. _____ Sec. 22 Twp. 26 R. 8
 Well No. 2 Stanhope Farm _____
Great Southern Company

NORTH

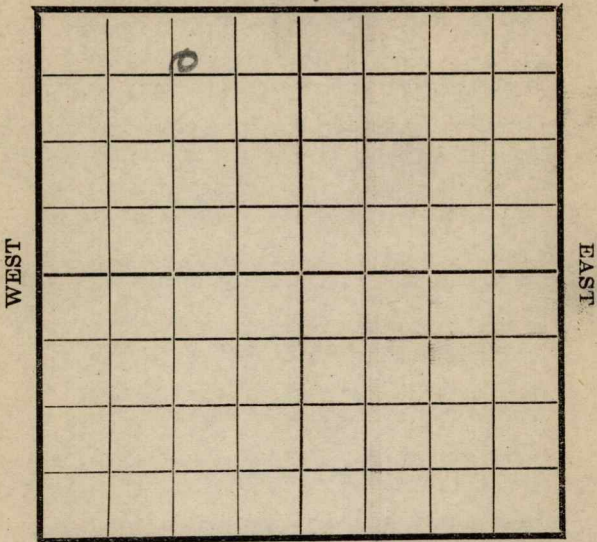

SOUTH

Location _____
 Rig Up _____
 Drilling and remarks _____

RECORD
 Cased _____ in _____ Ft.
 Sand _____
 Gas _____
 Oil _____
 Total Depth _____

PRODUCTION
 1st 24 hrs. Nat. _____
 1st 24 hrs. after shot _____
 Gas _____ Cu. Ft.
 Dry Hole _____
 Abandoned _____


2442
2456
filled 300' in
14 hrs waiting
on shot

Date 4/5, 1918 Cyke Scout

Map No. K15 Sec. 22 Twp. 26 R. 8Well No. 2 Stayhope Farm
Great Southern Company

NORTH

WEST

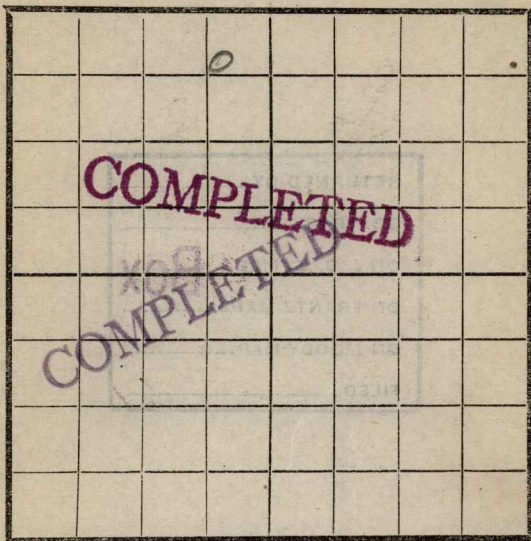

EAST

SOUTH

Location -----

Rig Up -----

Drilling and remarks

Est. @50 bblsShot 40 gts

Date

4/8, 1918
11

RECORD

Cased ----- in ----- Ft.

Sand 2442-2456

Gas -----

Oil -----

Total Depth -----

PRODUCTION

1st 24 hrs. Nat. -----

1st 24 hrs. after shot -----

Gas ----- Cu. Ft.

Dry Hole -----

Abandoned -----

Scout

Map No. K 15 Sec. 22 Twp. 26 R. 8Well No. 3 StanhopeEast Southern Company

Contractor _____

NORTH

WEST

EAST

SOUTH

COMPLETED

Location _____

Rig up _____

Drilling and Remarks:

Pumping25 bblsper day

RECORD

Cased _____ in., _____ ft.

Sand _____

Gas _____

Oil _____

Total Depth _____

PRODUCTION

1st 24 hrs. Nat. _____

1st 24 hrs. after shot _____

Gas _____ Cu. Ft.

Dry Hole _____

Abandoned _____

Date

5/24 1918 Oyle Scout