


Map No. _____ Sec. 22 Twp. 26 R. 8Well No. 6 Stanhope Farm __________ Tidal Oil Company _____

NORTH

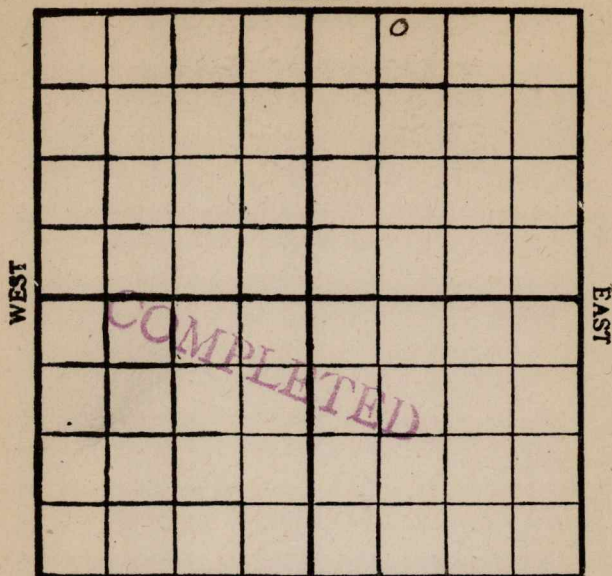

SOUTH

Location _____

Rig Up _____

Drilling Remarks:

Drilling Remarks:

8-23-19Sand 2402'2416'Shot 20gts

RECORD

PRODUCTION

Cased _____ in. _____ ft.

1st 24 hrs. Nat. _____

Sand _____

1st 24 hrs. after shot _____

Gas _____

Gas _____ cu. ft.

Oil _____

Dry Hole _____

Total Depth _____

Abandoned _____

Map No. K15 Sec. 22 Twp. 26 R. 8Well No. 6 Stanhope FarmTidal Oil & Gas Company

NORTH

WEST

EAST

700 W

SOUTH

200 N

Location _____

Rig up ☒

Drilling and remarks:

RECORD

Cased _____ in. _____ Ft.

Sand _____

Gas _____

Oil _____

Total Depth _____

PRODUCTION

1st 24 hrs. Nat. _____

1st 24 hrs. after shot _____

Gas _____ Cu. Ft.

Dry Hole _____

Abandoned _____

Date

April 4, 1919, Pyle Scout

Map No. K15 Sec. 22 Twp. 26 R. 8
Well No. 6 Stanhope
Tidal Oil Company
Contractor

NORTH

NORTH

WEST

EAST

SOUTH

0

SOUTH

700 W SOUTH 200 N

Location _____

Rig up ✓

Drilling and Remarks:

RECORD

Cased-----in., -----ft.

Sand_____

Gas -----

Oil_____

Total Depth_____

PRODUCTION

1st 24 hrs. Nat. -----

1st 24 hrs. after shot.....

Gas.....Cu. Ft.

Dry Hole.....

Abandoned_____

Date _____

4/10 1919

Pyle

Scout

Map No. K15 Sec. 22 Twp. 26 R. 8Well No. 6 StanhopeTidal Oil Company

Contractor

NORTH

WEST

EAST

SOUTH

700 W200 N

Location _____

Rig up _____

Drilling and Remarks:

1030'

RECORD

Cased _____ in., _____ ft.

Sand _____

Gas _____

Oil _____

Total Depth _____

PRODUCTION

1st 24 hrs. Nat. _____

1st 24 hrs. after shot _____

Gas _____ Cu. Ft.

Dry Hole _____

Abandoned _____

Date

5/4 1919 Cyle Scout


Map No. K15 Sec. 22 Twp. 26 R. 8
 Well No. 6 Stanhope
Tidal & Gt Southern Company

Contractor _____

NORTH

WEST

EAST

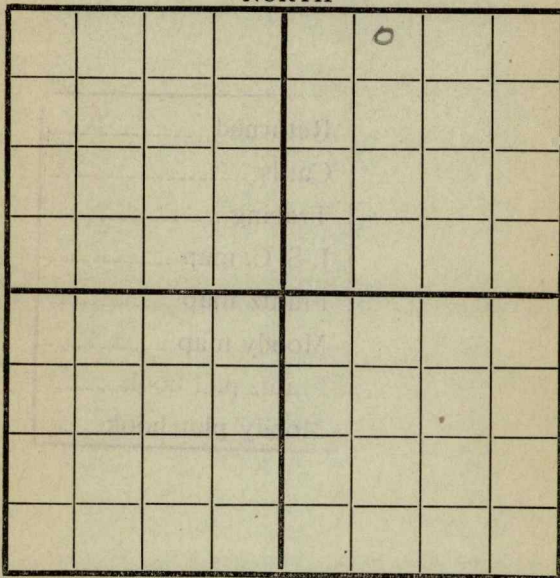

SOUTH

700 W

200 N

Location _____

Rig up _____

Drilling and Remarks:

1600'

RECORD

Cased _____ in., _____ ft.

Sand _____

Gas _____

Oil _____

Total Depth _____

PRODUCTION

1st 24 hrs. Nat. _____

1st 24 hrs. after shot _____

Gas _____ Cu. Ft.

Dry Hole _____

Abandoned _____

Date

7/6

1919

Cyl

Scout


Map No. K15 Sec. 22 Twp. 26 R. 8Well No. 6 StanhopeTidal & Southern Company

Contractor _____

NORTH

WEST

EAST

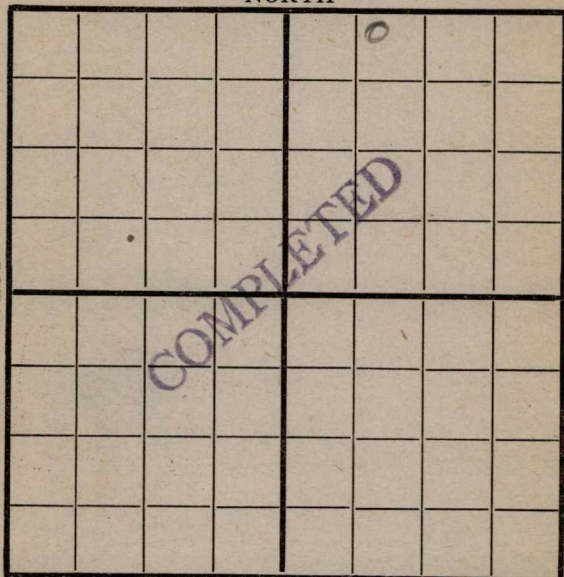

700 W

SOUTH

200 N

Location _____

Rig up _____

Drilling and Remarks:

Shot 20 qts

RECORD

Cased _____ in., _____ ft.

Sand 2402 - 2416

Gas _____

Oil _____

Total Depth _____

PRODUCTION

1st 24 hrs. Nat. _____

1st 24 hrs. after shot 30 bbl

Gas _____ Cu. Ft.

Dry Hole _____

Abandoned _____

Date

8/201919Pyh

Scout