


Map No. _____ Sec. 22 Twp. 26 R. 8
 Well No. 7 Starbuck Farm
Tidal & St. Southern Company

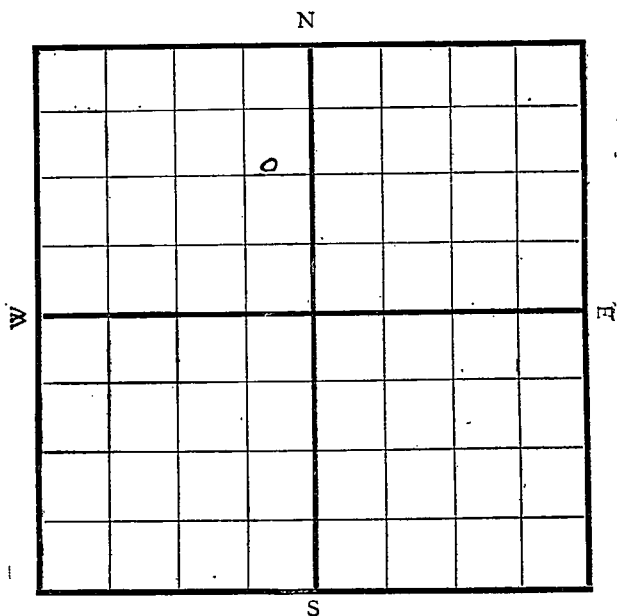

Location _____

Drilling Remarks: _____

Rig Up _____

Drilling Remarks: _____

RECORD

Cased _____ in. _____ ft.

Sand _____

Gas _____

Oil _____

Total Depth _____

PRODUCTION


1st 24 hrs. Nat. _____

1st 24 hrs. after shot _____

Gas _____ cu. ft.

Dry Hole _____

Abandoned _____

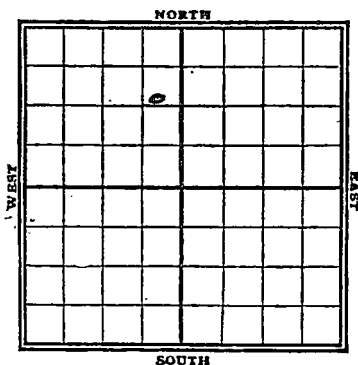Map No. Sec. 22 Twp. 26 R. 8Well No. 7. Stantope FarmTidal Oil & Co. Santhera company1100 Ft. from N. Line Ft. from S. Line450 Ft. from E. Line Ft. from W. Line

REPORT

1920

1/3 Dry - 960'

16 Dry 1120'

24 Dry 1600'

21 Dry 1810'

8 Dry 1810'

12 ~ ~

18 Dry 1960' - Set 6 7/8

27 ~ 2175'

3 1/2 T. S. 2005' - Sh. Oil

20 2405' - 32' - 20 BH

COMPLETED

Map No. K 15 Sec. 22 Twp. 26 R. 8Well No. 7 StanhopeTidal Oil & Gas Southern Company

Contractor _____

SECTION PLAT

1100 Ft. from N. Line

_____ Ft. from S. Line

450 Ft. from E. Line

_____ Ft. from W. Line

	10		

FIRST REPORT

Location _____

Rig up _____

Drilling and Remarks:

960'

RECORD

Cased _____ in., _____ ft.

Sand _____

Gas _____

Oil _____

Total Depth _____

PRODUCTION

1st 24 hrs. Nat. _____

1st 24 hrs. after shot _____

Gas _____ Cu. Ft.

Dry Hole _____

Abandoned _____

Date

1/3 1919

Pyle

Scout

Map No. K15 Sec. 22 Twp. 26 R. 8Well No. 7 Stanhope
Tidal & M. Southern Company

Contractor


SECTION PLAT

1100 Ft. from N. Line

Ft. from S. Line

450 Ft. from E. Line

Ft. from W. Line

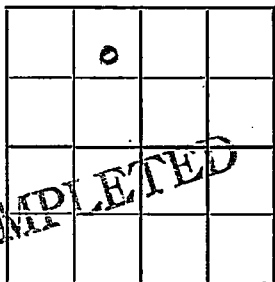

Location

Rig up

Drilling and Remarks:

RECORD

Cased _____ in., _____ ft.

Sand 2405 - 2432

Gas _____

Oil _____

Total Depth _____

PRODUCTION

1st 24 hrs. Nat. 20 bbls

1st 24 hrs. after shot _____

Gas _____ Cu. Ft.

Dry Hole _____

Abandoned _____

Date

3/19 1910

Pyle

Scout