
FORM 51 25M 3-49 PETROL

Butler KANSAS

Section 29 Township 26 Range 8E

Well No. #1 Drumm

Company Thrifty Drlg.

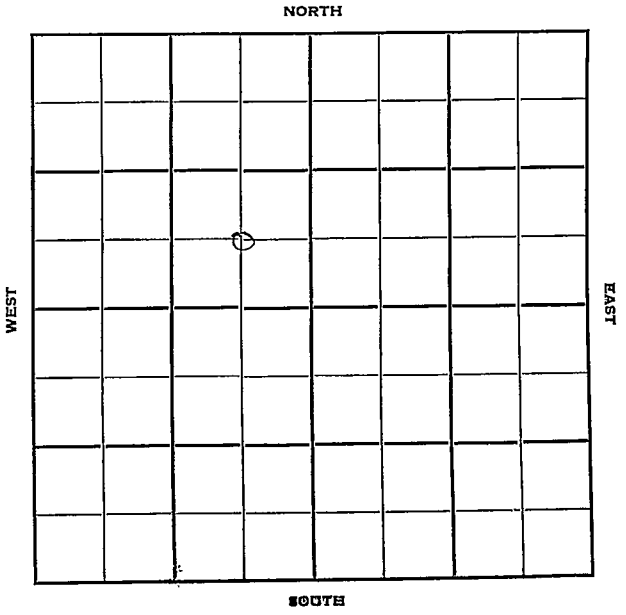

FORM 252-B
10M 9-49 PETROL

Butler KANSAS

Sec. 29 Twp. 26 R. 8E

Well No. #1 Drumm Farm

Thrifty Drlg. Company

Miscellaneous Contractor


____ Ft. from N. Line

660' Ft. from S. Line

660' Ft. from E. Line

____ Ft. from W. Line

C SE NW

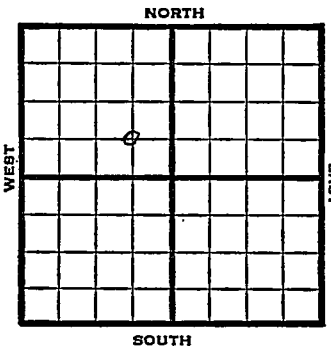

1950	Elev. REPORT
1/25	Spud 1-11-50 8" @ 87' Bart 2634' TD 2640' Show of oil 5½" @ 2634' WOC
2/22	8" @ 87' 5½ @ 2634' Bart 2634' D&A TD 2695'

ABANDONED

Form 26 200 Bks. 6-49 Petrol Kansas Miscellaneous

Map No. Sec. 29 Twp. 26 R. 8E


Well No. 1 Drumm

Thrifty Drlg. Company

Contractor

C SE NW

SECTION PLAT

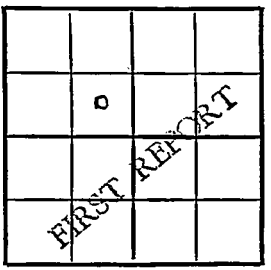

Ft. from N. Line

660 Ft. from S. Line

660 Ft. from E. Line

Ft. from W. Line

Butler County

Location

Rig up

Drilling and Remarks:

Spud 1-11-50
8" @ 87
Bart. 2634-40 TD
show of oil
5½" @ 2634
WOC

RECORD

Cased in, ft.
Sand
Gas
Oil
Total Depth

PRODUCTION

1st 24 hrs. Nat.
1st 24 hrs. after shot
Gas Cu. Ft.
Dry Hole
Abandoned

Date

JAN 25 1950

J. E. TYRA Scout

Form 26 200 Bks. 11-49 Petrol

Miscellaneous

Map No. _____ Sec. 29 Kansas Twp. 26 R. 8E


Well No. 1 Drumm

Thrifty Drlg. Company

Contractor

C SE NW

SECTION PLAT

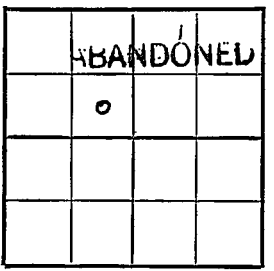

_____ Ft. from N. Line

660 Ft. from S. Line

660 Ft. from E. Line

_____ Ft. from W. Line

Butler County

Location _____

Rig up _____

Drilling and Remarks:

8" @ 87

5½ @ 2634

Bort 2634

D & A

RECORD

Cased _____ in., _____ ft.

Sand _____

Gas _____

Oil _____

Total Depth 2695

PRODUCTION

1st 24 hrs. Nat. _____

1st 24 hrs. after shot _____

Gas _____ Cu. Ft.

Dry Hole _____

Abandoned _____

Date

FEB 22 1950

19

J. E. TYRA

Scout